


TO: Joann Price
From: Christy Jolicœur
-Damon Engineering


3 pages
4-23-07

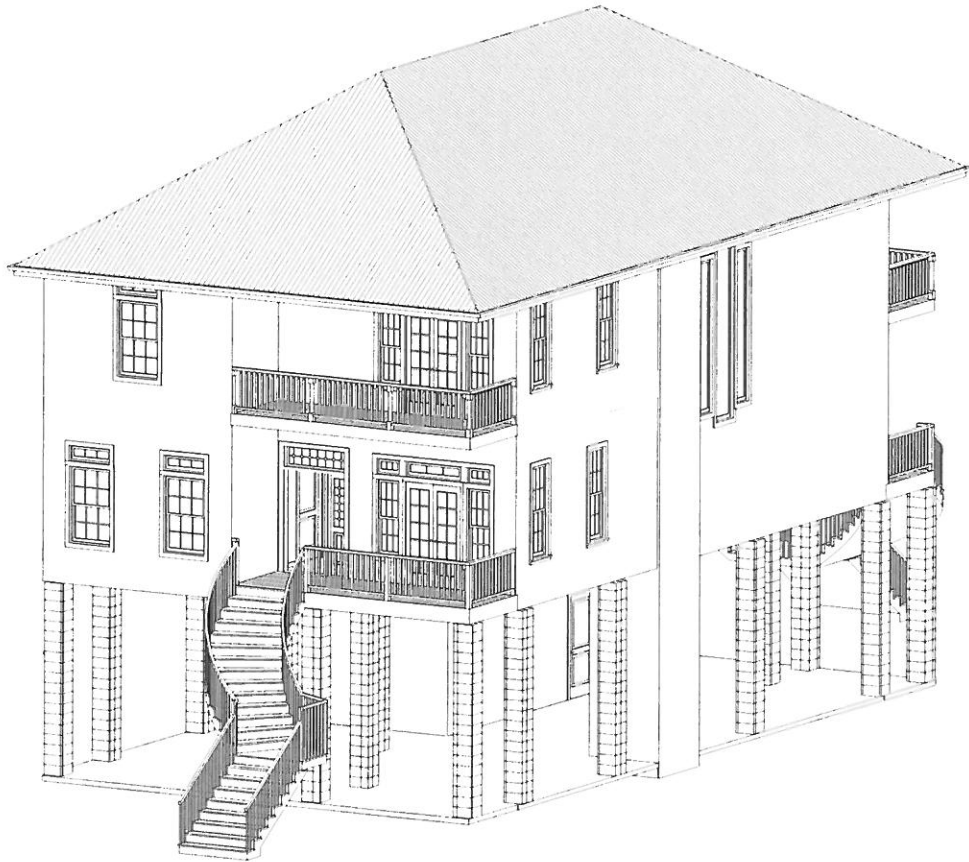

Joann,

See the attached floor plans. I made a few changes. Also, check your email. Call me. Thanks,

Christy

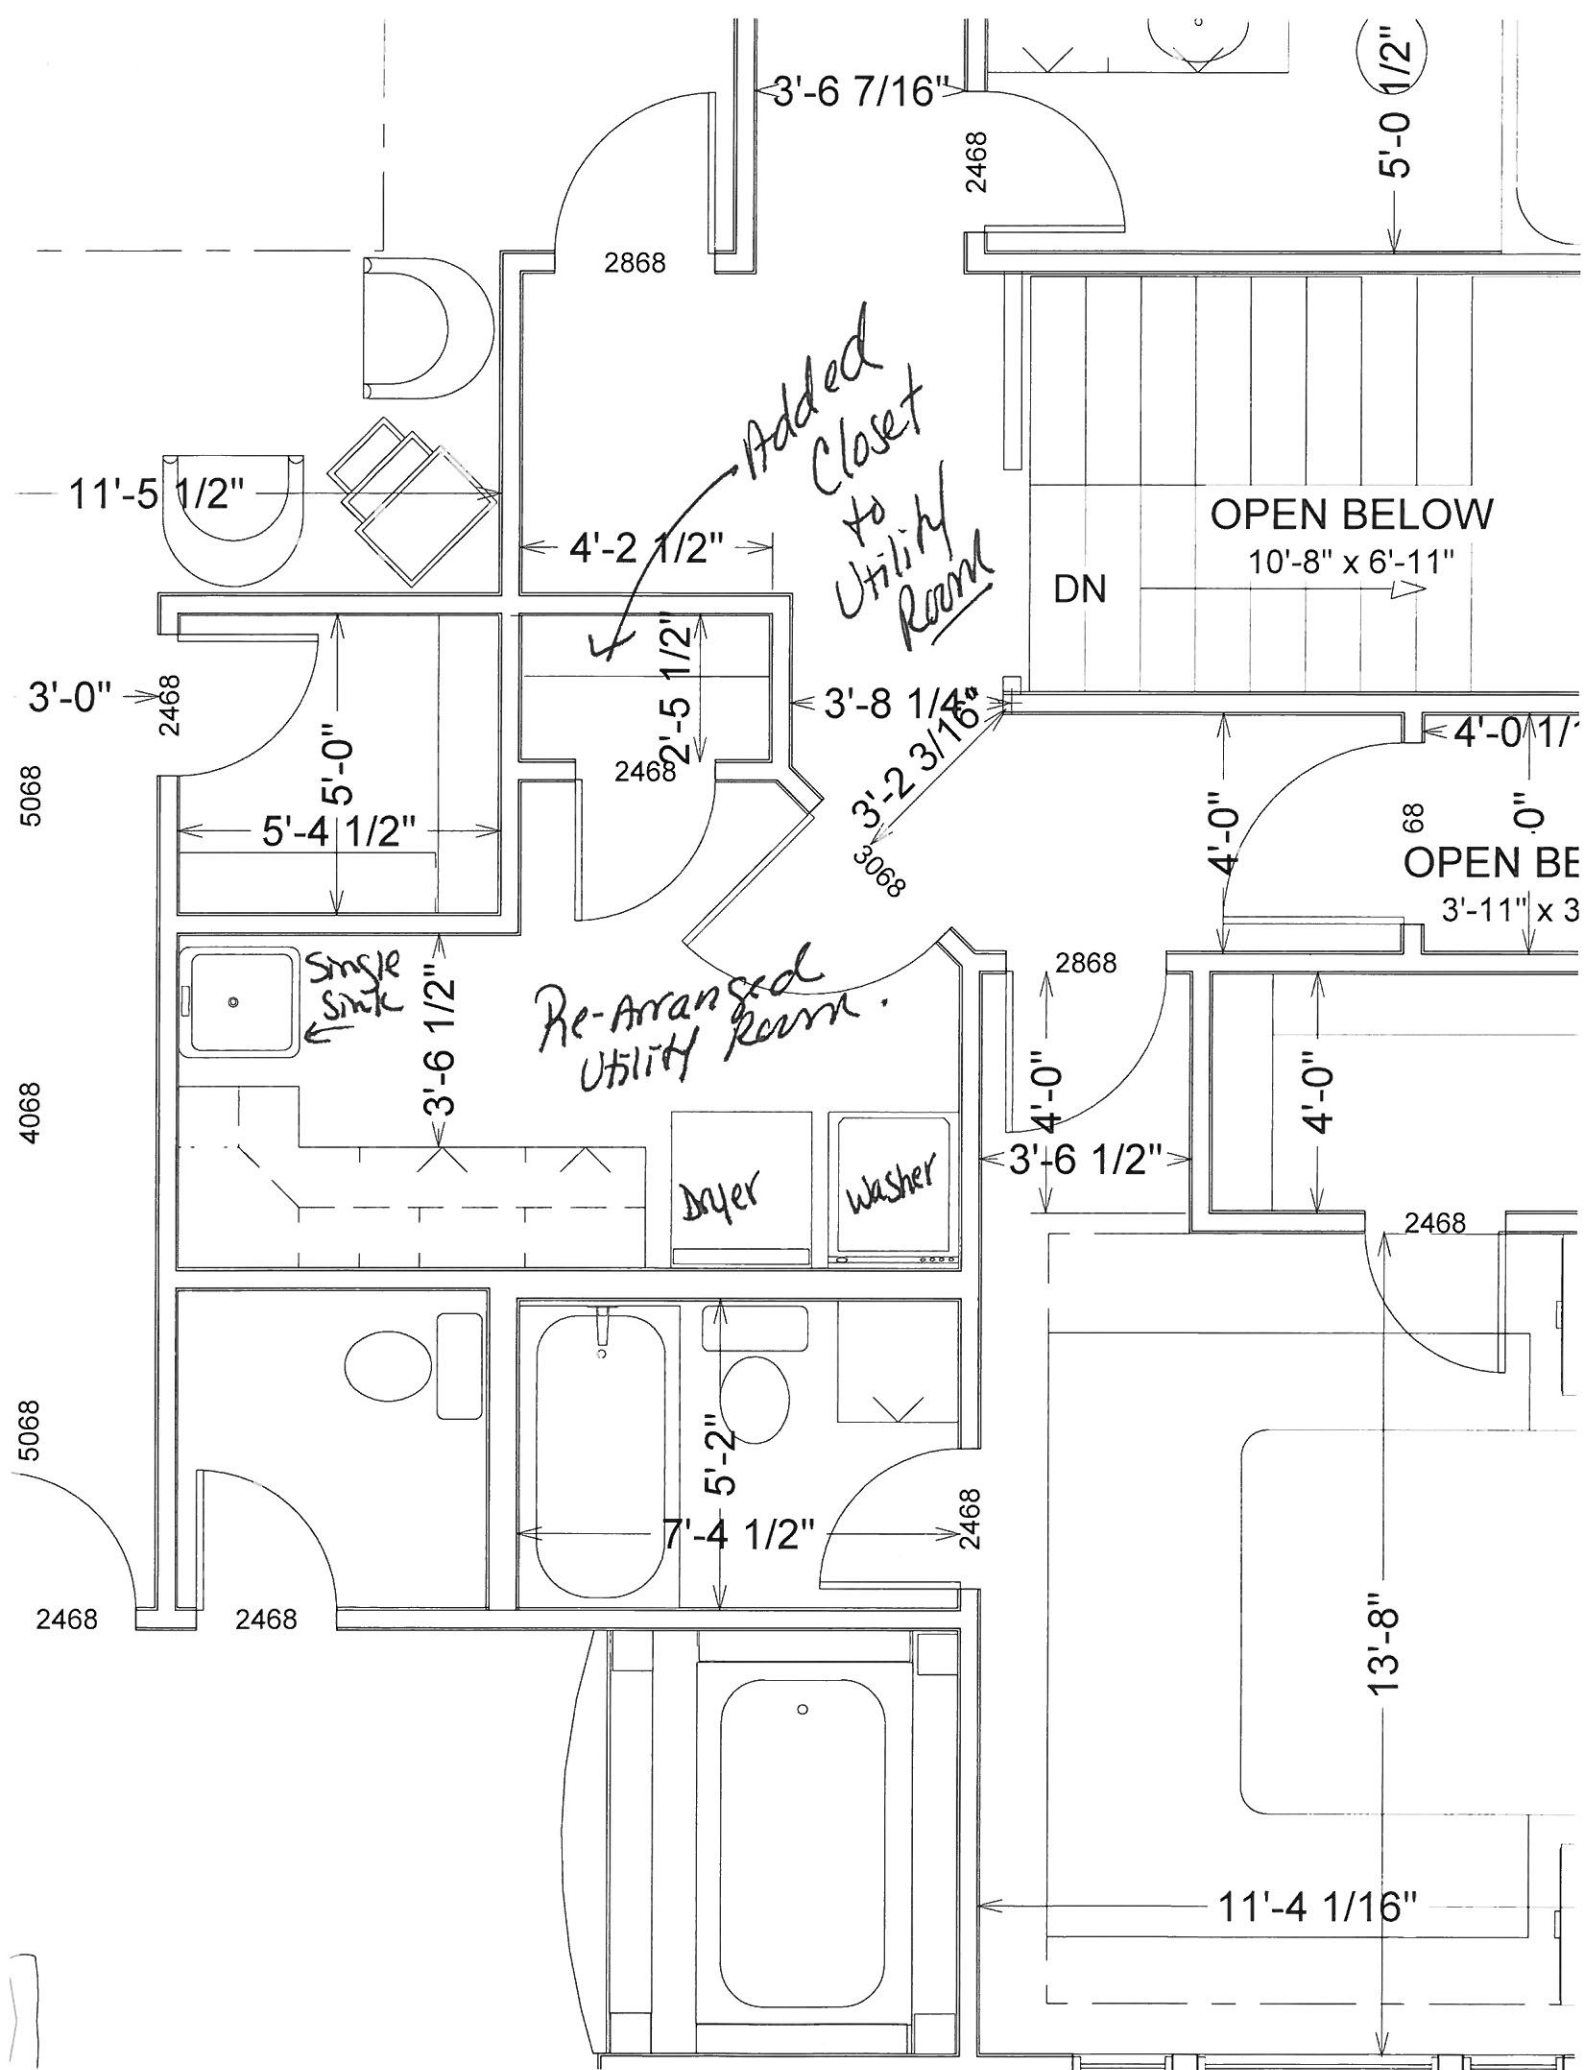


JPEGS

423FP Front Right ✓
" Right ✓

423FP Rear Right ✓
" Rear ✓

" Rear Left ✓
" Left ✓
" Left Front ✓
" Front ✓

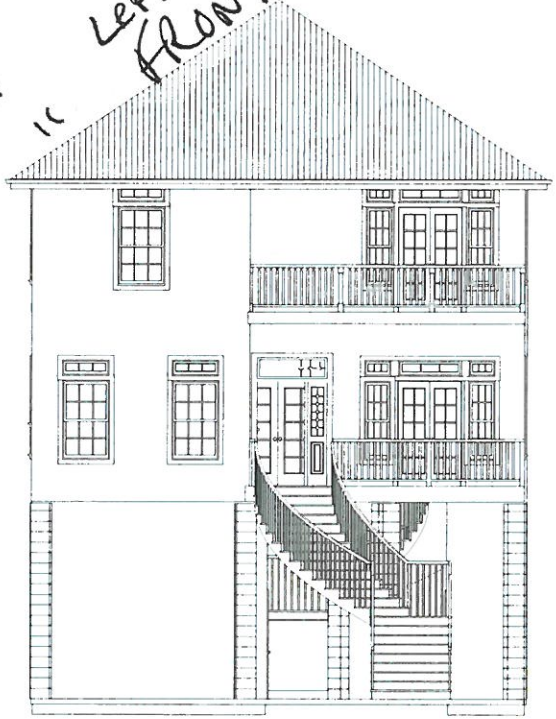

MrsJalPrice@yahoo.com