


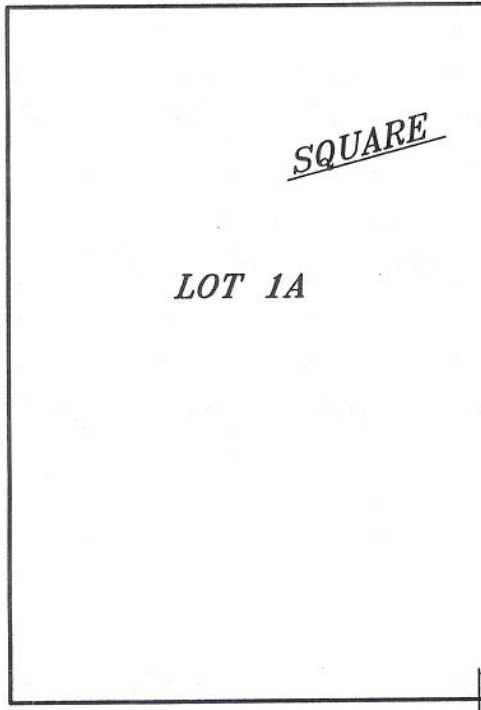


DE SOTO STREET  
(NOT CONSTRUCTED)



"35"

LOT 4

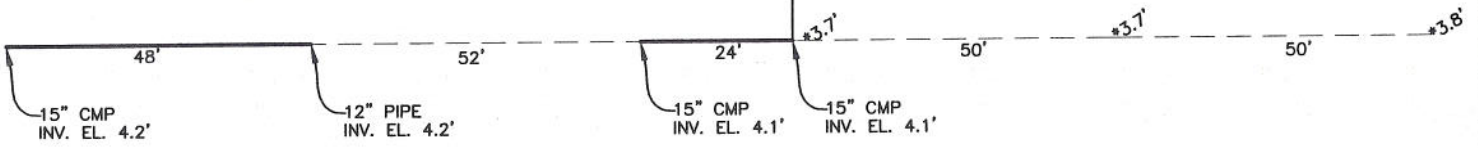

#56388 ALMONASTER STREET

COPYRIGHT © 2012  
ALL RIGHTS RESERVED  
JOHN E. BONNEAU & ASSOCIATES, INC.

A DRAINAGE STUDY OF  
LOT 1A, SQUARE 35, SPANISH TRAIL HIGHLANDS  
in  
St. Tammany Parish, Louisiana  
for  
**CHRIS DUPUY**

Survey No. 2006 717 DS      Drawn by: SPH      Scale: 1" = 30'  
Date: APRIL 11, 2012      Revised:

This Survey is Certified  
True and Correct By  
**JOHN E. BONNEAU**  
REG. NO. 4423  
REGISTERED  
PROFESSIONAL  
SURVEYOR  
*John E. Bonneau*  
John E. Bonneau  
Professional Land Surveyor  
Registration No. 4423

**JOHN E. BONNEAU & ASSOCIATES, INC.**  
Professional Land Surveyors      Planners and Consultants  
420 HWY. 1085, EXIT #57 • MADISONVILLE, LA. 70447  
(985)845-1012 • (985)845-1013 • (985)845-1351 • FAX NO. (985)845-1778  
www.JEBCOLandSurveying.com • e-mail: jebco1@bellsouth.net