


CHEF MENTEUR PASS

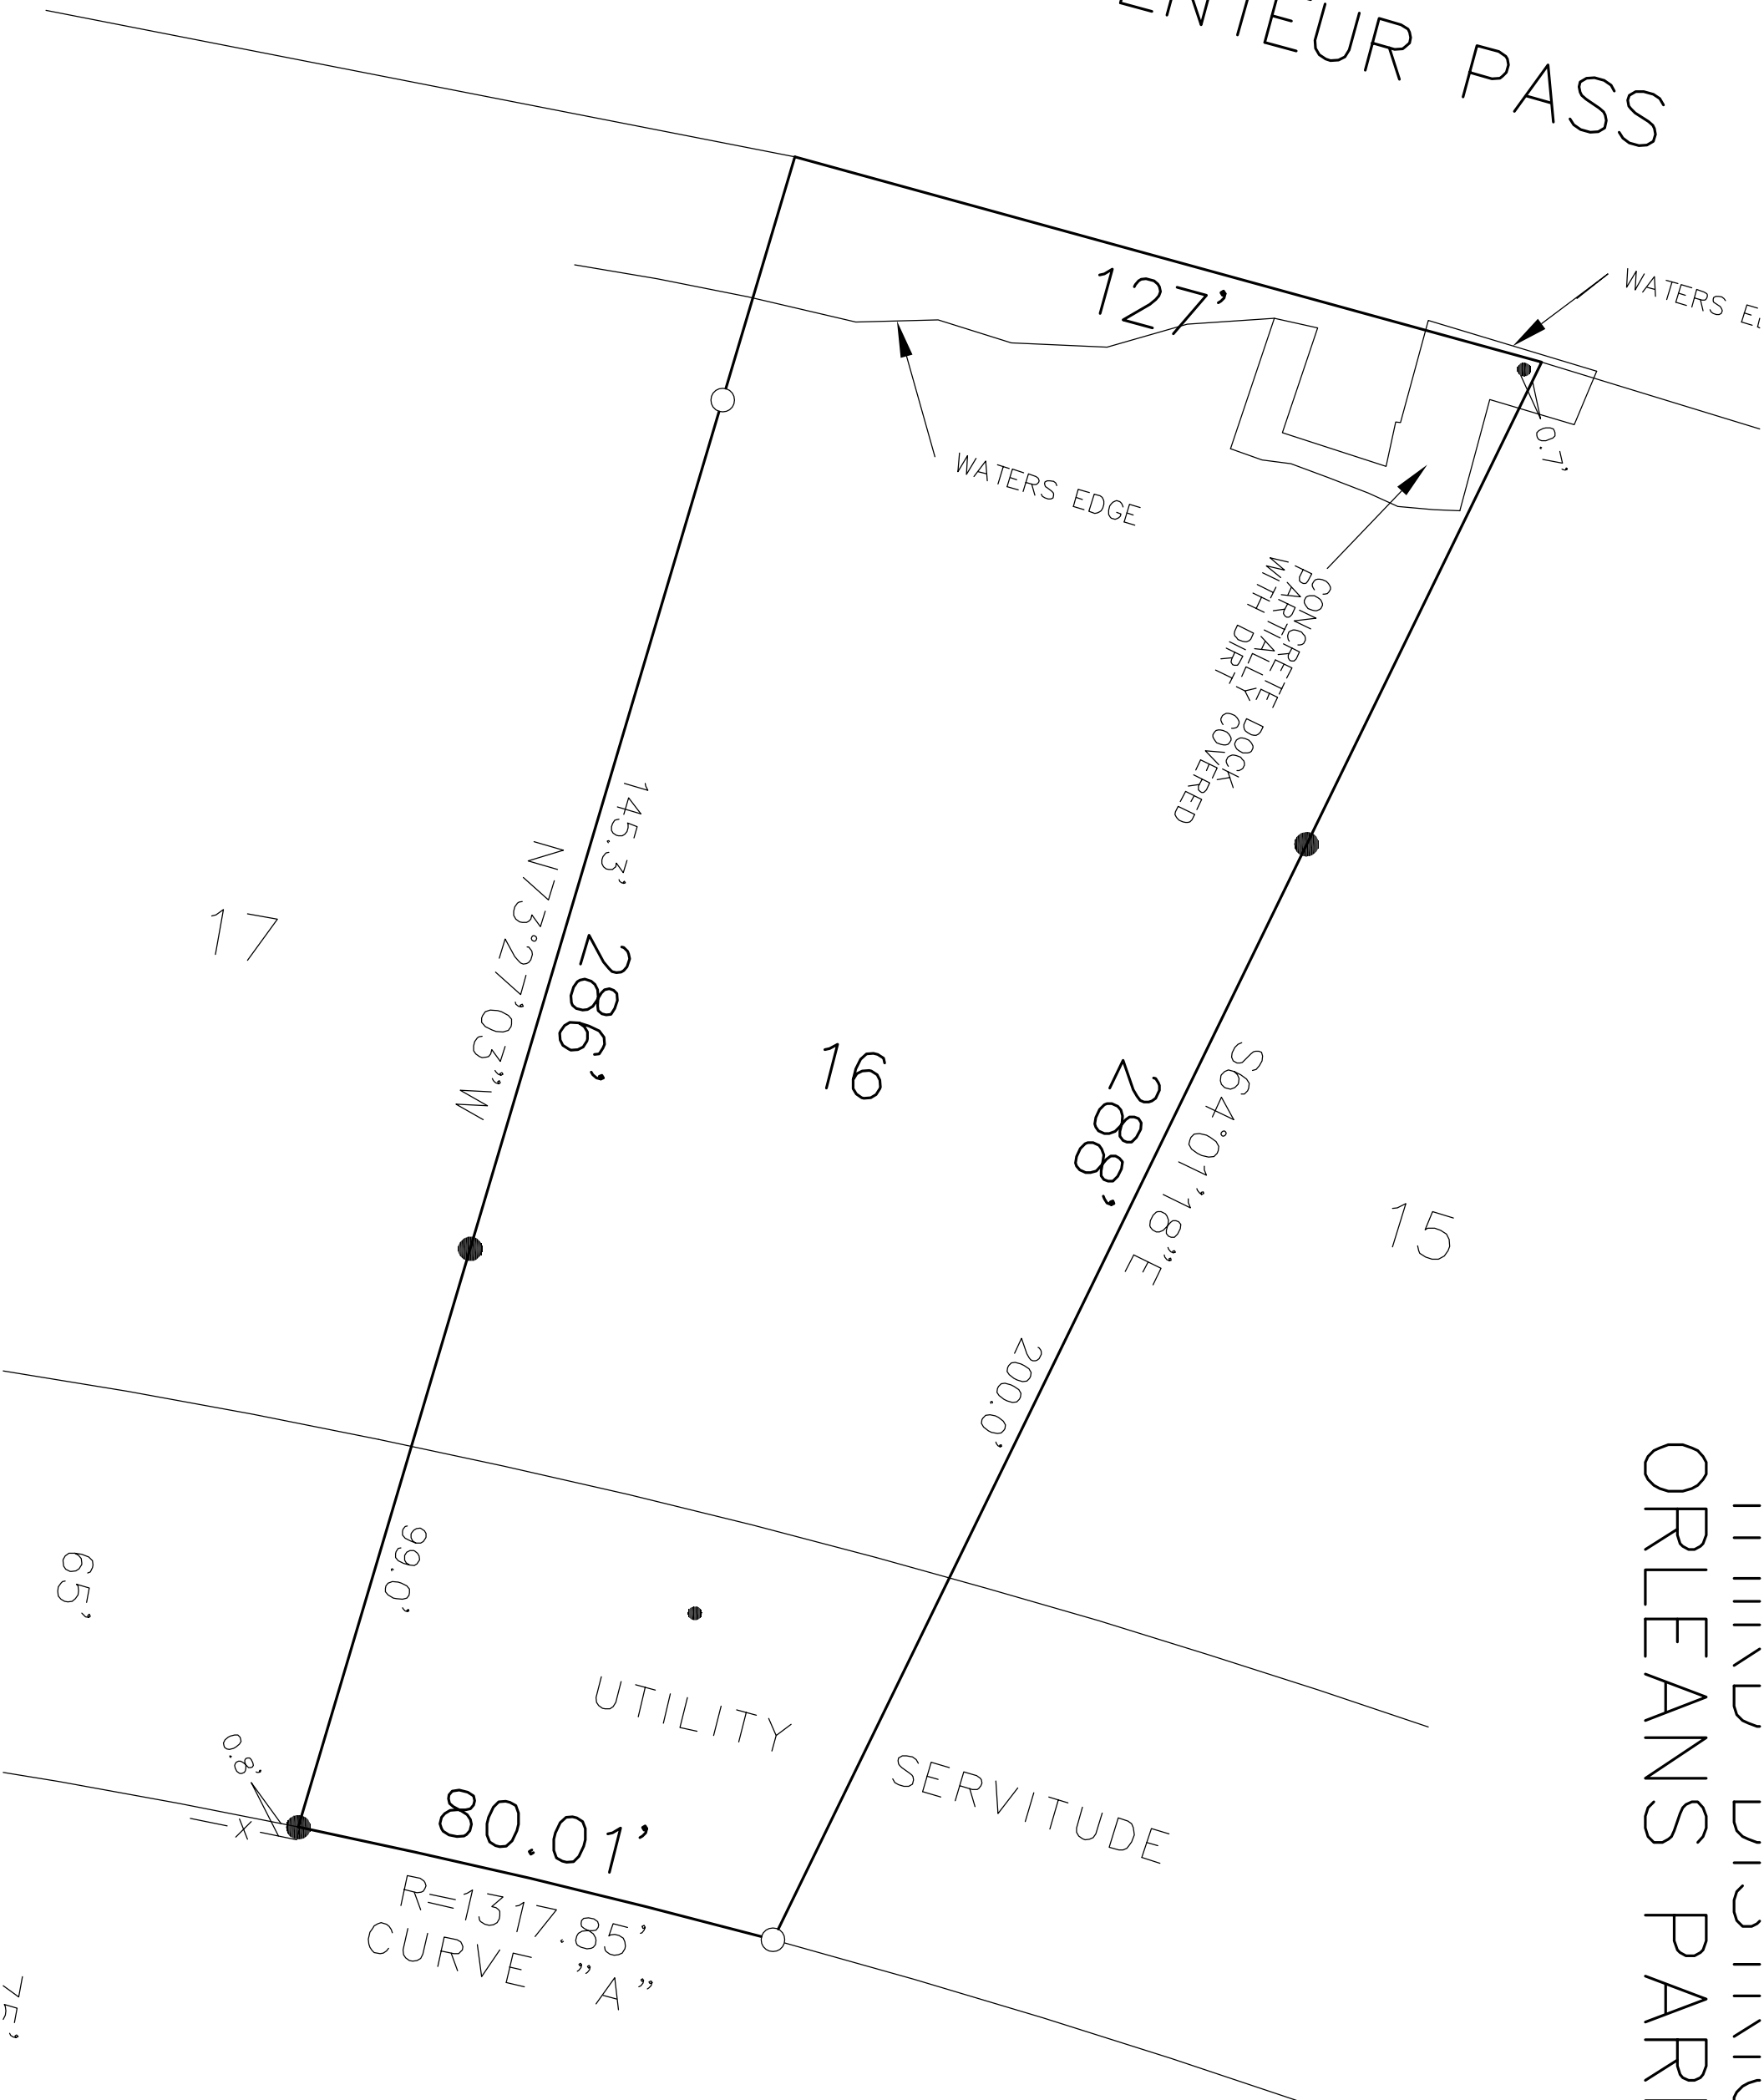

ORLEANS PARISH