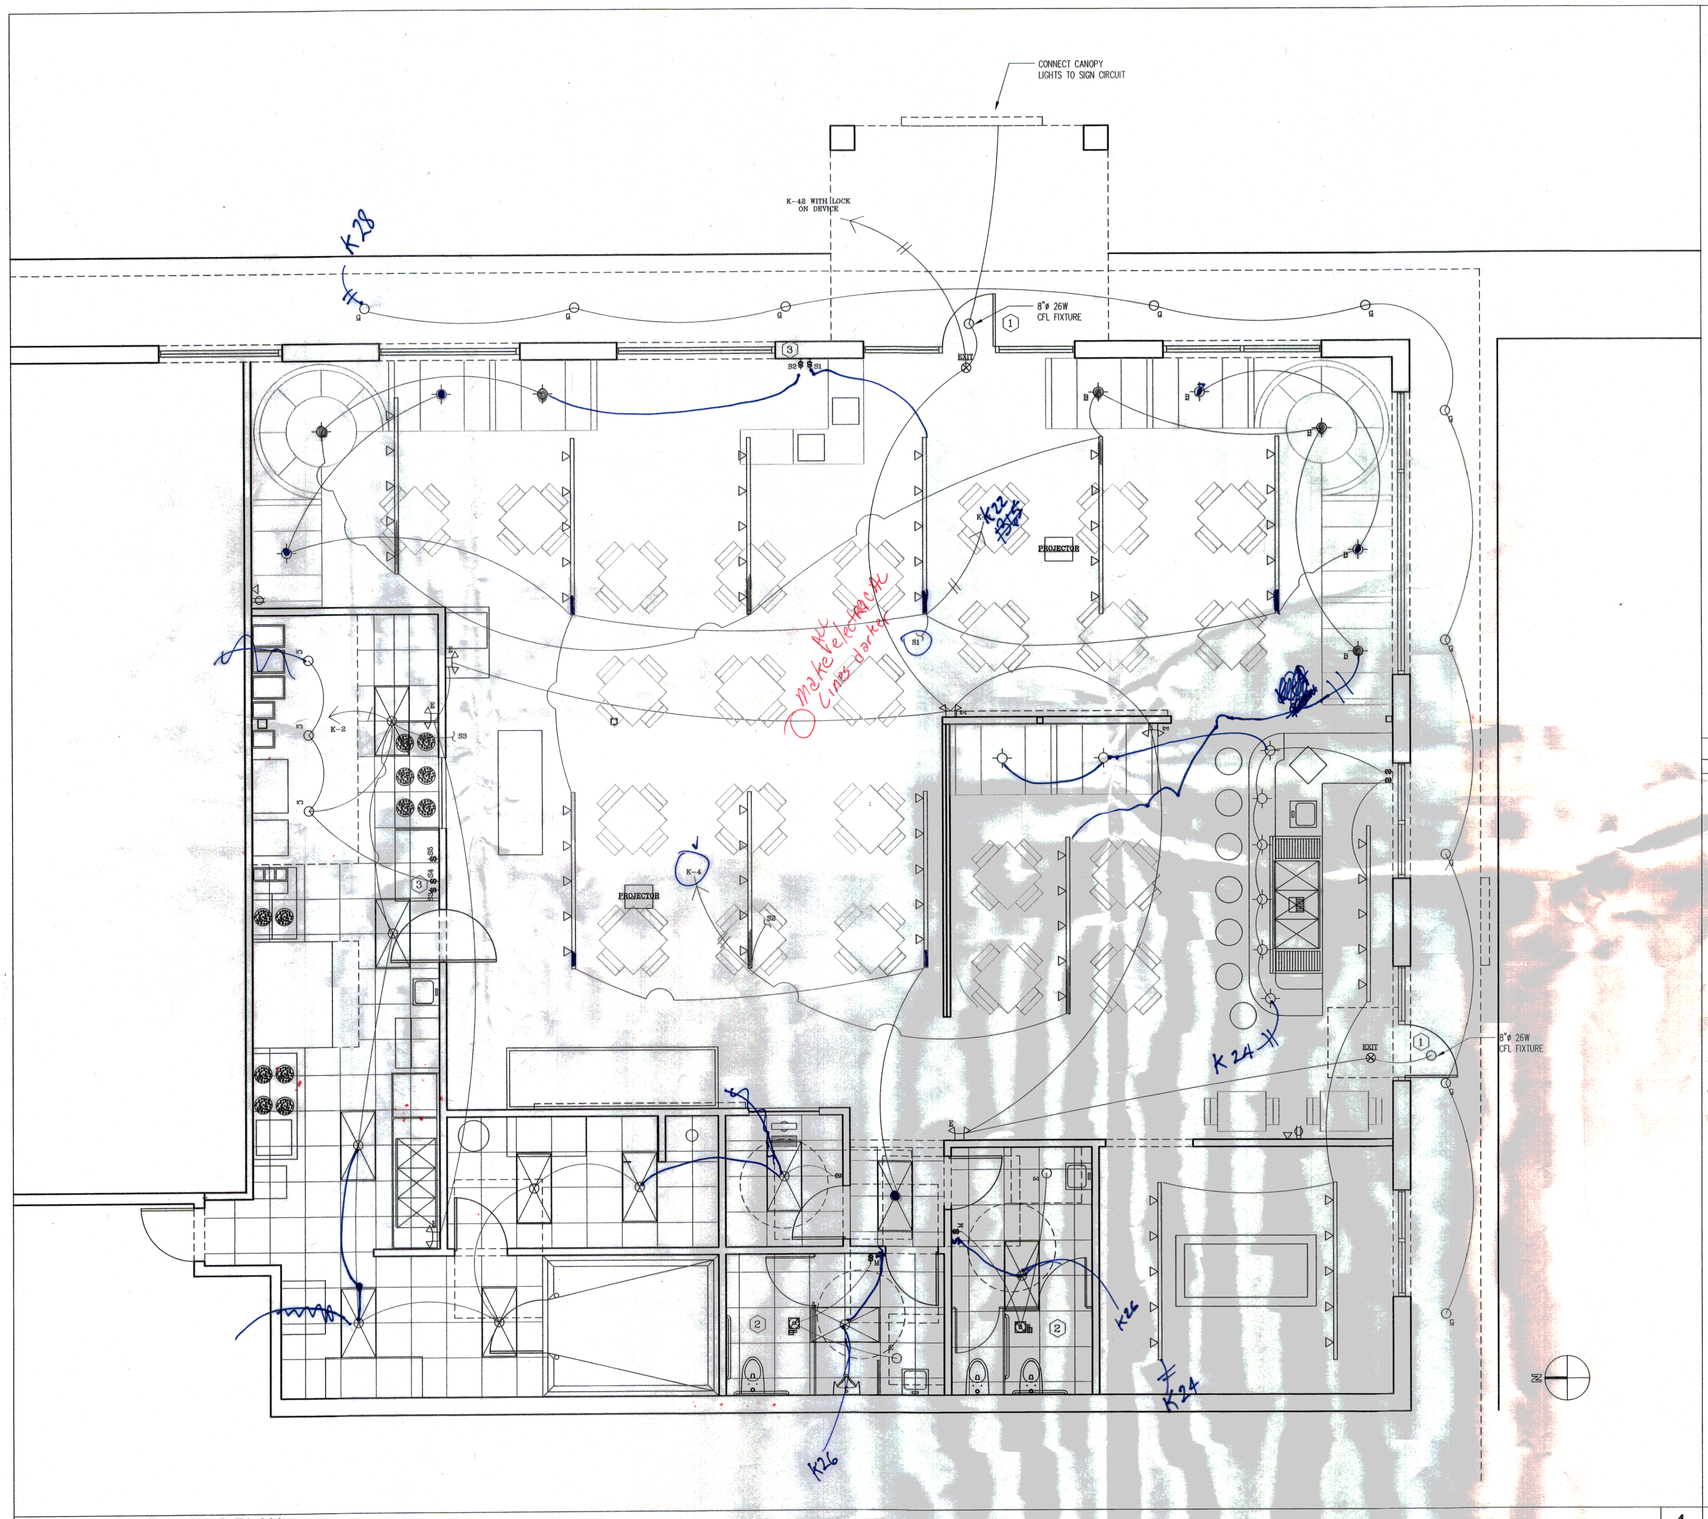

ELECTRICAL LIGHTING PLAN

SCALE: 1/4"=1'-0"

	SINGLE POLE SWITCH
	DOUBLE POLE SWITCH
	TRIPLE POLE SWITCH
	"D" RECESSED CAN DOWN LIGHT - 32W FLUORESCENT
	WALL SCONCE
	EXHAUST FAN / EXISTING TOILET
SD	SMOKE DETECTOR
	110 VOLT RECEPTACLE
GFI	GROUND FAULT INTERRUPTED RECEPTACLE
	220 VOLT RECEPTACLE
	VOICE / DATA OUTLET
W	WATER LINE
G	GAS LINE
	FAN / LIGHT COMBO
B	"B" PENDANT LIGHT FIXTURE 40W 1F, A19
	"A" TWO LAMP T-8 EXISTING TO REUSE
	NIGHT LIGHT WITH BATT. BACKUP
WM	WALL MOUNTED FLUORESCENT FIXTURE
	SURFACE MOUNTED UNDERCABINET LIGHT FIXTURE
EXIT	BATHROOM EMER. TREC LT.EXIT W/ BATT. BACKUP, TWO HEAD EGRESS AND 26W EXTERIOR RECESSED CAN LIGHT FIXTURE
C	"C" HOOD LIGHTS BY OTHERS
G	"G" EXISTING EXTERIOR CAN LIGHT FIXTURE
E	BATHROOM EMER. TREC LT.
M	NOVITAS #01-400 WALL MTD. MOTION SWITCH
	"E" 2 HEAD EMERGENCY LIGHT, 120 V

B-Pendant Light 40W

ELECTRICAL LEGEND - 3

GENERAL NOTES:

REFER TO BUILDER'S SPECIFICATIONS

1. VERIFY QUANTITY AND LOCATION OF ALL CABLE OUTLETS, POWER OUTLETS, AND TELEPHONE JACKS WITH OWNER / BUILDER PRIOR TO INSTALLATION.
2. ALL EXTERIOR OUTLETS AND FIXTURES TO BE WATER PROTECTED.
3. VERIFY APPLIANCE AND ELECTRICAL EQUIPMENT REQUIREMENTS WITH BUILDER.
4. VERIFY H.B. LOCATIONS WITH BUILDER.
5. PROVIDE PLUMBING TO ALL FIXTURES AS REQUIRED.
6. ELECTRICAL LAYOUT IS SCHEMATIC ONLY, AND SHOWN FOR REPRESENTATIONAL PURPOSES. FINAL LAYOUT TO BE VERIFIED BY BUILDER.
8. LIGHTING SUPPLYER / INSTALLER TO COORDINATE WITH BUILDER FOR LOCATION AND QUANTITY OF OUTLETS.

(1) EXIT LIGHT WITH TWO HEAD EMERGENCY LIGHT AND ADA APPROVED EXTERIOR EGRESS LIGHT

(2) CONN BATHROOM FAN, LIGHTS, AND SWITCHES TO NEW PANEL "K".

(3) WALL MOUNTED SWITCHES S1 THROUGH S4 FOR LIGHTING AND S5 FOR SWITCHED RECEPACLE FOR WALL MTD. SIGNS AND TELEVISIONS.

NOTE:

CONTRACTOR ASSUMES ALL RESPONSIBILITY TO CONFIRM AND FIELD VERIFY THAT ALL STRUCTURAL, PLUMBING, ELECTRICAL, AND MECHANICAL DESIGNS IN THIS SET OF DWGS. MEET ALL REQUIREMENTS PER EXISTING SITE CONDITIONS, LOCAL BUILDING CODES, DEED RESTRICTIONS, AND OWNER SPECIFICATIONS PRIOR TO SUBMITTING FINAL PRICING.

GENERAL NOTES - 1

WINGS-PIZZA-N-THINGS
550 GAUSE BLVD.
SLIDELL, LOUISIANA

SQUARE FOOTAGE = 3,960 S.F.

ELECTRICAL LIGHTING PLAN

Drawn By -

Sheet **E101**

Scale AS NOTED