


GENERAL SHEET NOTES


1. SEE SHEET D1 FOR GENERAL DEMOLITION NOTES.

DAMMON ENGINEERING, INC.
Architects & Engineers

Chief Architect: Kevin J. Kinchen, NCARB
Chief Engineer: Brian M. Mitch, PE
www.dammonengineering.com
info@dammonengineering.com
554 Old Spanish Trail
Brentwood, LA 70005
P: 985.341.1950
F: 985.341.1952

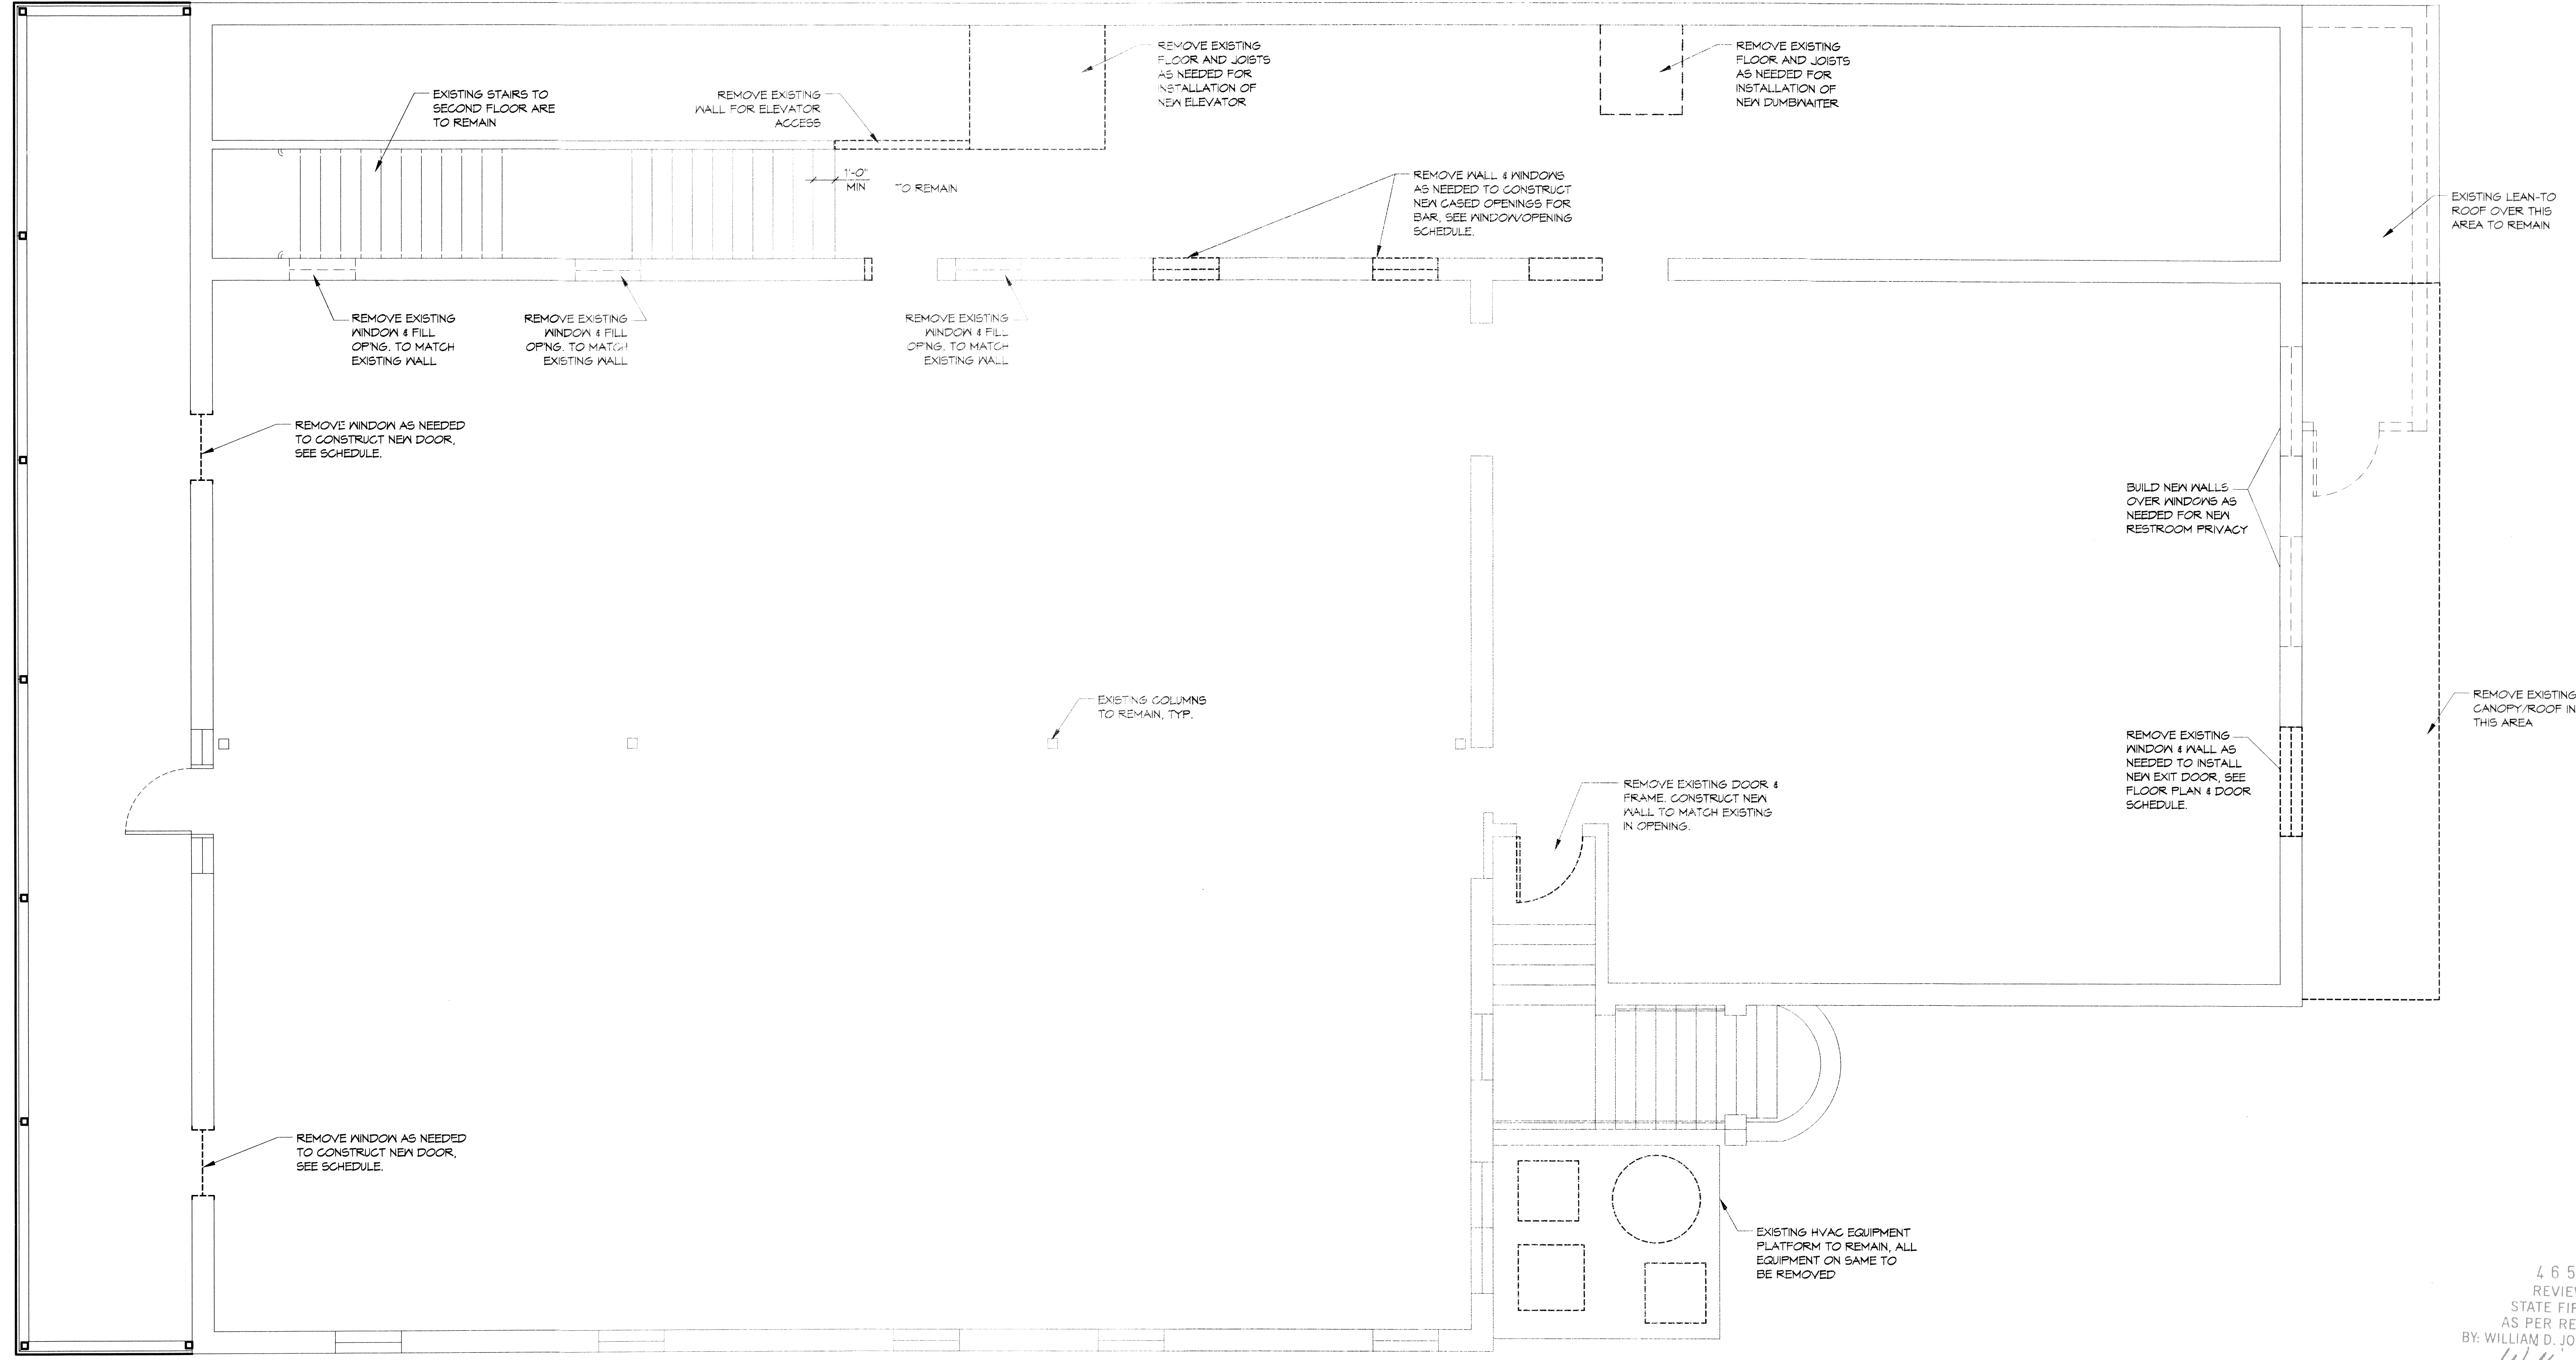

#	DESCRIPTION	DATE

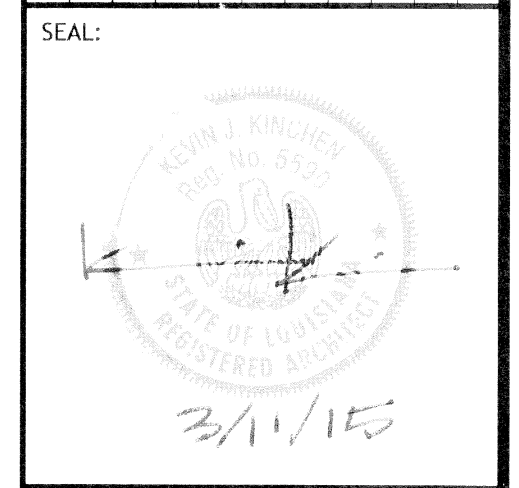

RECEPTION HALL RENOVATION FOR:
BEV, INCORPORATED
211 COUEN STREET
SLIDELL, LOUISIANA 70459
JOB No: 2220 DATE: MARCH 2015
DRAWN BY: KJK CHECKED BY: CJD

SHEET TITLE:
DEMOLITION PLAN
- LEVEL 2

DRAWING NUMBER:
D2

SHEET No: 4 of 19

1 DEMOLITION PLAN - LEVEL 2
SCALE: 1/4" = 1'-0"

465406
REVIEWED FOR
STATE FIRE MARSHAL
AS PER REVIEW LETTER
BY: WILLIAM D. JONES, ARCHITECT, CBO
William D. Jones