


1 ARCHITECTURAL FLOOR PLAN - LEVEL 2  
SCALE: 1/4" = 1'-0"

465406  
REVIEWED FOR  
STATE FIRE MARSHAL  
AS PER REVIEW LETTER  
BY: WILLIAM D. JONES, ARCHITECT, CBO  
*William D. Jones*

**DAMMON**  
ENGINEERING, INC.  
Architects & Engineers  
www.dammonengineering.com  
info@dammonengineering.com  
PH: 985.649.8832  
554 Old Spanish Trail  
Slidell, LA 70458  
F: 985.641.9950

#	DESCRIPTION	DATE

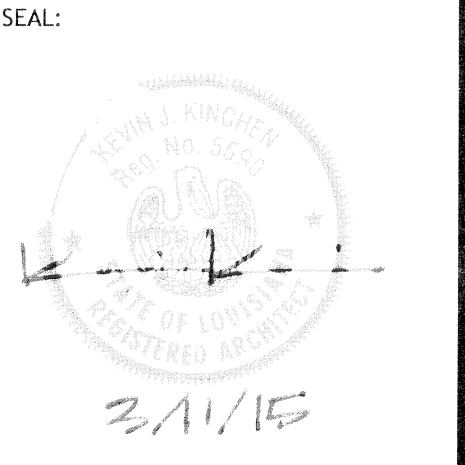

RECEPTION HALL RENOVATION FOR:  
**BEV, INCORPORATED**  
211 COBURN STREET  
SLIDELL, LOUISIANA 70458  
JOB No: 2220 DATE: MARCH 08, 2015  
DRAWN BY: K-KJ CHECKED BY: K-KJ

SHEET TITLE:  
ARCHITECTURAL FLOOR  
PLAN - LEVEL 2  
DRAWING NUMBER:  
**A2**  
SHEET No: 6 of 14