Amt	Existing Trees & Plants	
4	Live OAK	5" CAL
38	SAbal Palms	10 to 12'
6	Mandina	3'

Amt	New Plants & Trees
24	Indian Hawthorn 3gal
75	Liropes 1gal
60	Parsons Juniper 3gal
1	Live OAK 3" Cal

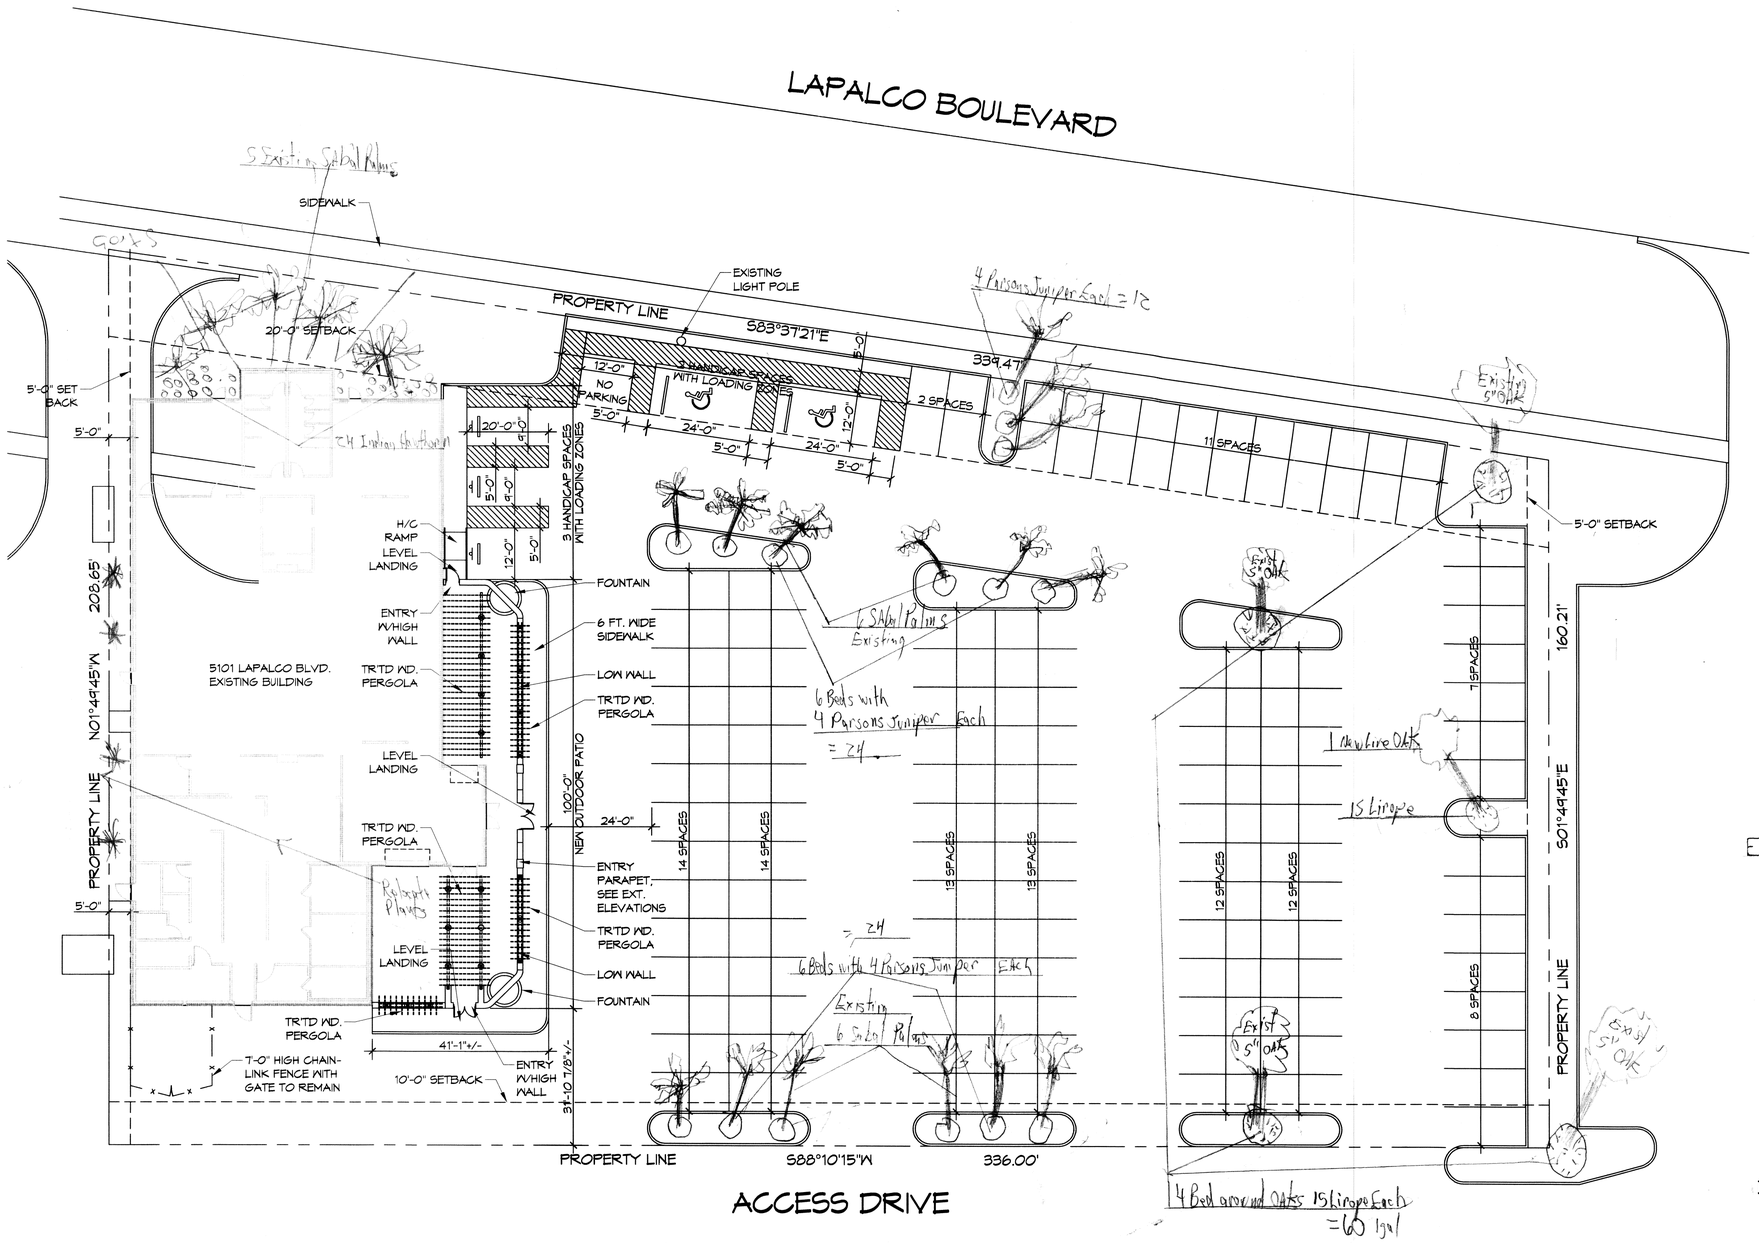

EL PASO RESTAURANT

5101 LAPALCO BLVD.

David Parr
Landscape Contractor
Lic. # 1049
Horticulture Lic # 0685

1 SITE PLAN
SCALE: 1" = 20'-0"

EXISTING SITE PLAN

Date 4-16-17
1 of 1

David Parr
Landscape Contractor
Lic. # 1049
Horticulture Lic # 0685