
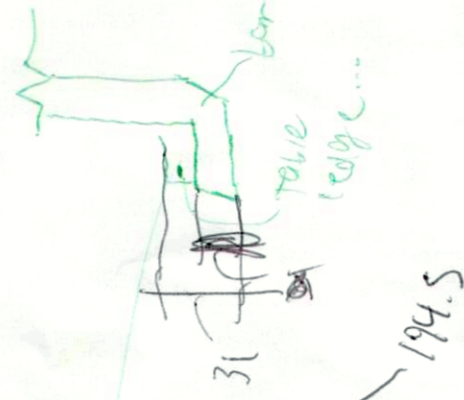


DOOR SCHEDULE				
MARK	WIDTH	HINGE	LATCH	NOTES
D01				
D02				
D03				
D04				
D05				
D06				
D07				
D08	2			light obs
D09				
D10				
D11				
D12				
D13				
D14	4x7	109		fire, fh
D15				
D16				
D17				
D18				
D19				
D20				

FS = FLIP SWING
FH = FLIP HINGE


D21 4x7'

fire

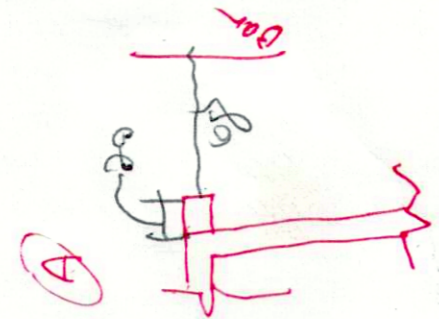

7x7 step ground bar

01-04

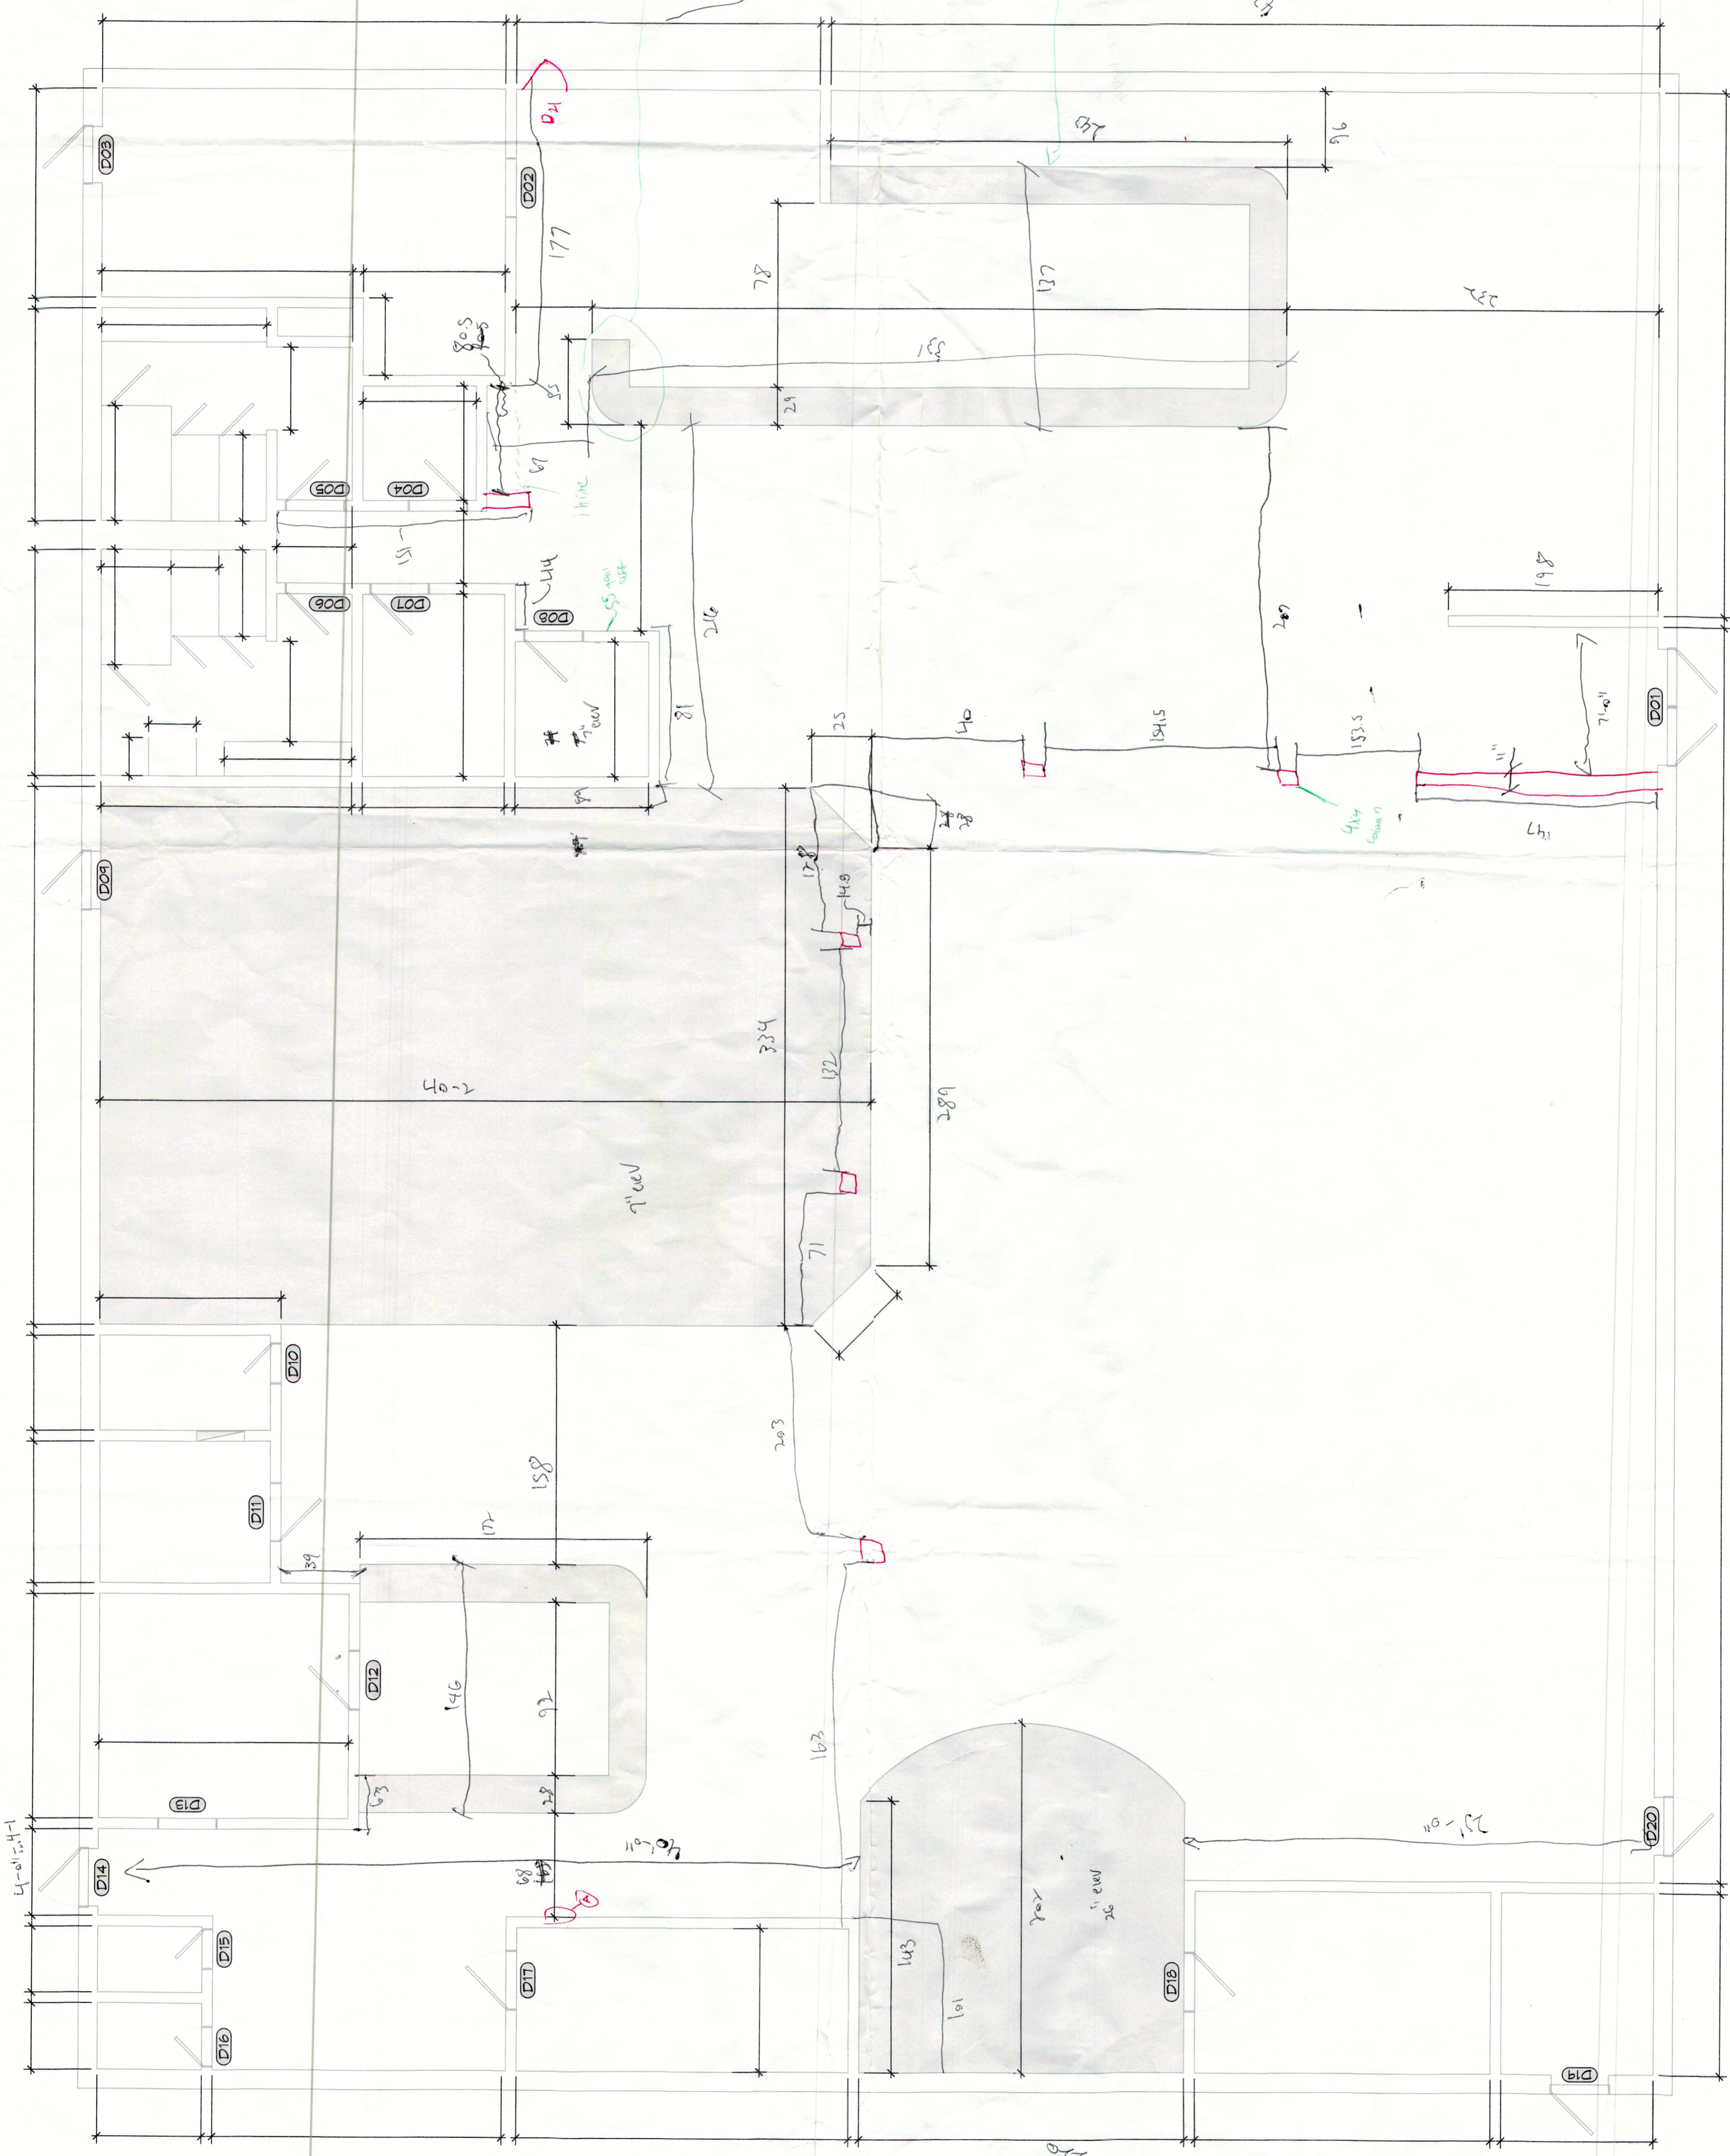

208
216