SITE LIGHTING

EXTERIOR LIGHTING SHALL BE SHADED OR INWARDLY DIRECTED IN SUCH A MANNER SO THAT NO DIRECT LIGHTING OR GLARE BE CAST BEYOND THE PROPERTY LINE. THE INTENSITY OF SUCH LIGHTING SHALL NOT EXCEED ONE FOOT CANDLE AS MEASURED AT THE ABUTTING PROPERTY LINE.

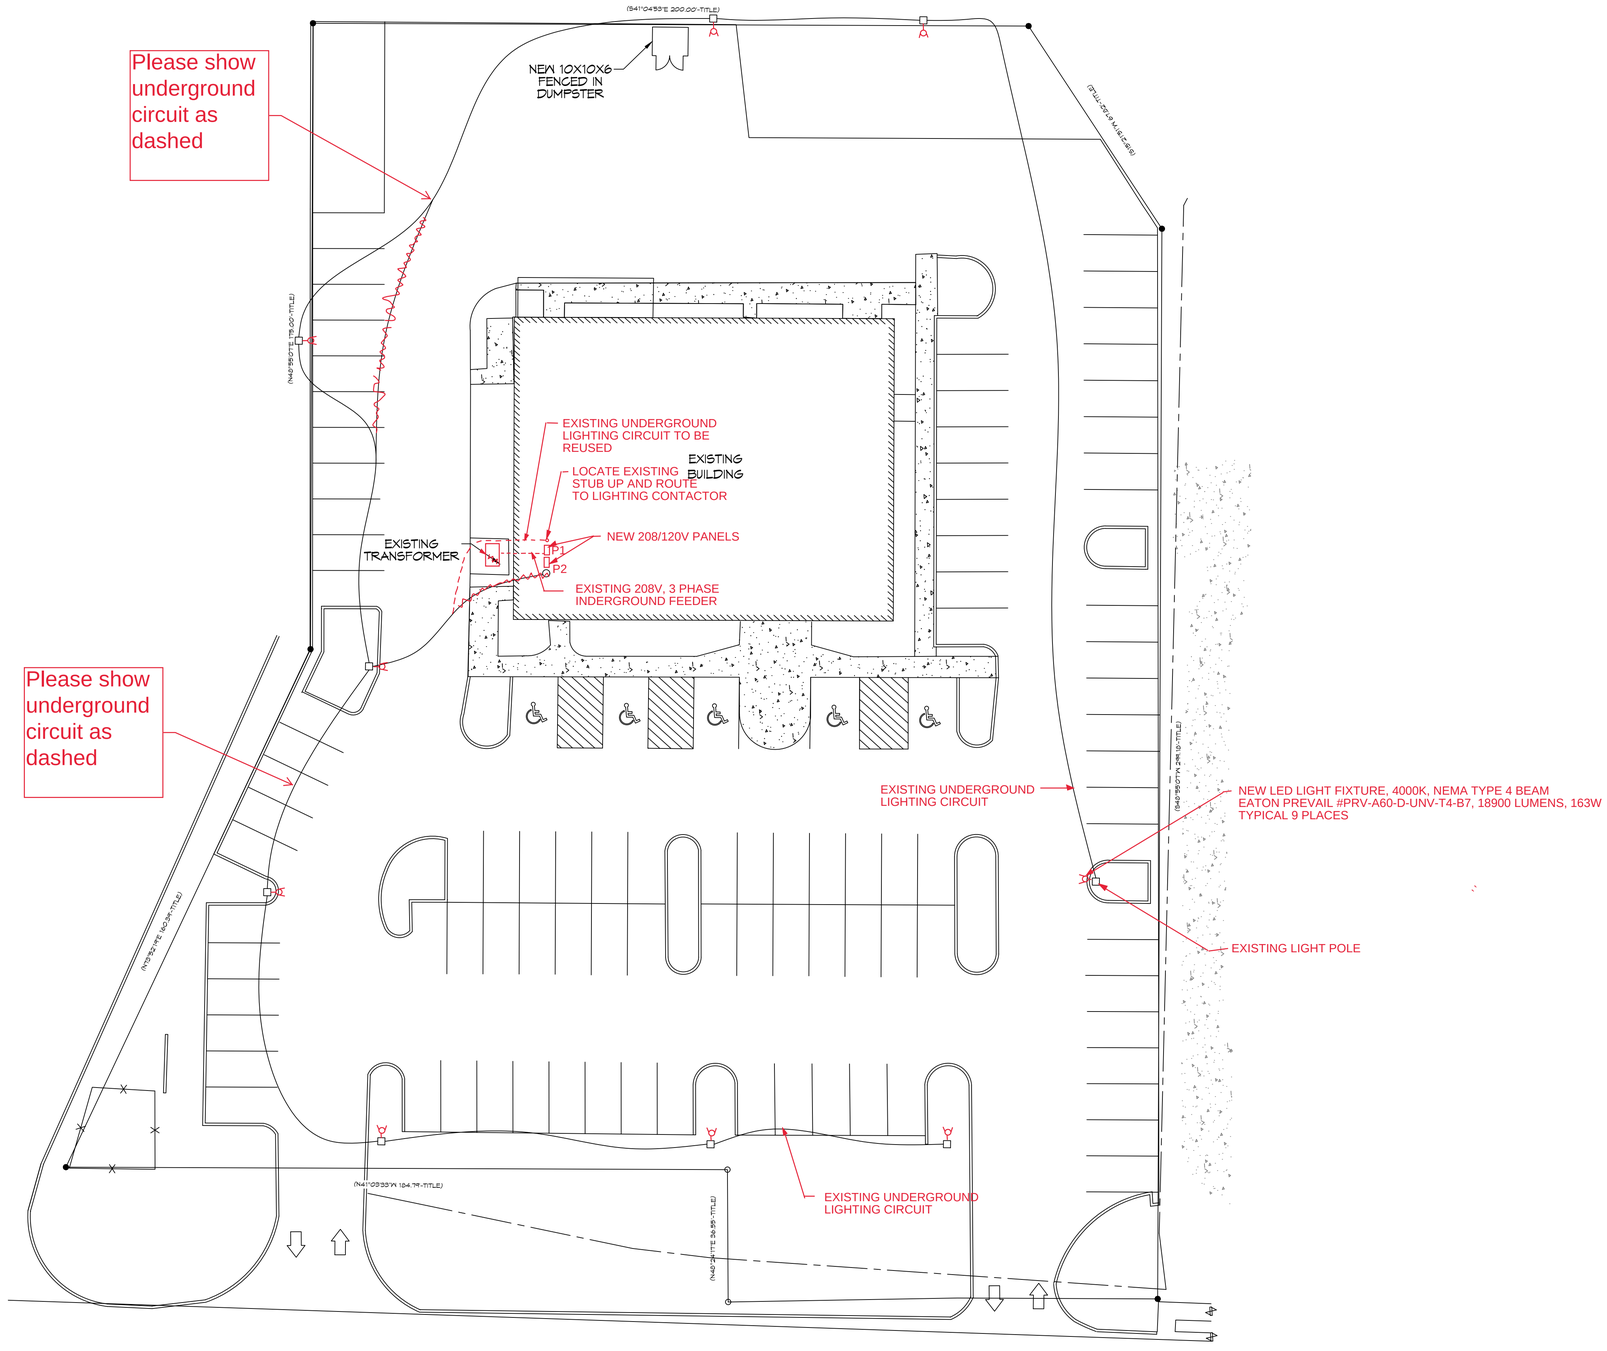

1 SITE LIGHTING PLAN
SCALE: 1" = 20'

DAMMON ENGINEERING, INC.
LOUISIANA & MISSISSIPPI
www.dammonengineering.com
info@dammonengineering.com
PH: 985.649.5832

Chief Engineer: Brian Mistich, PE
5500 Oakwood Trail
Slidell, LA 70458

#	DESCRIPTION	DATE

REVISIONS

SEAL:

NEW LOUNGE RESTAURANT

THE BLAKK LOUNGE RESTAURANT AND BAR

2304 OLD SPANISH TRAIL, SLIDELL, LA 70461

JOB No:	2464	DATE:	03/02/2023
DRAWN BY:	CKD	CHECKED BY:	JMS

THIS DRAWING IS AN INSTRUMENT OF SERVICE AND IS THE PROPERTY OF DAMMON ENGINEERING, INC. AND SHALL REMAIN THE PROPERTY OF DAMMON ENGINEERING, INC. AND IS NOT TO BE USED IN WHOLE OR IN PART WITHOUT THE WRITTEN CONSENT OF DAMMON ENGINEERING, INC. ALL REPRODUCTIONS, COPIES OR SUBSTITUTIONS OF THIS DRAWING WITHOUT WRITTEN CONSENT OF DAMMON ENGINEERING, INC. IS PROHIBITED.

SHEET TITLE:
SITE LIGHTING PLAN

DRAWING NUMBER:
E103

SHEET No: 2 of 15