
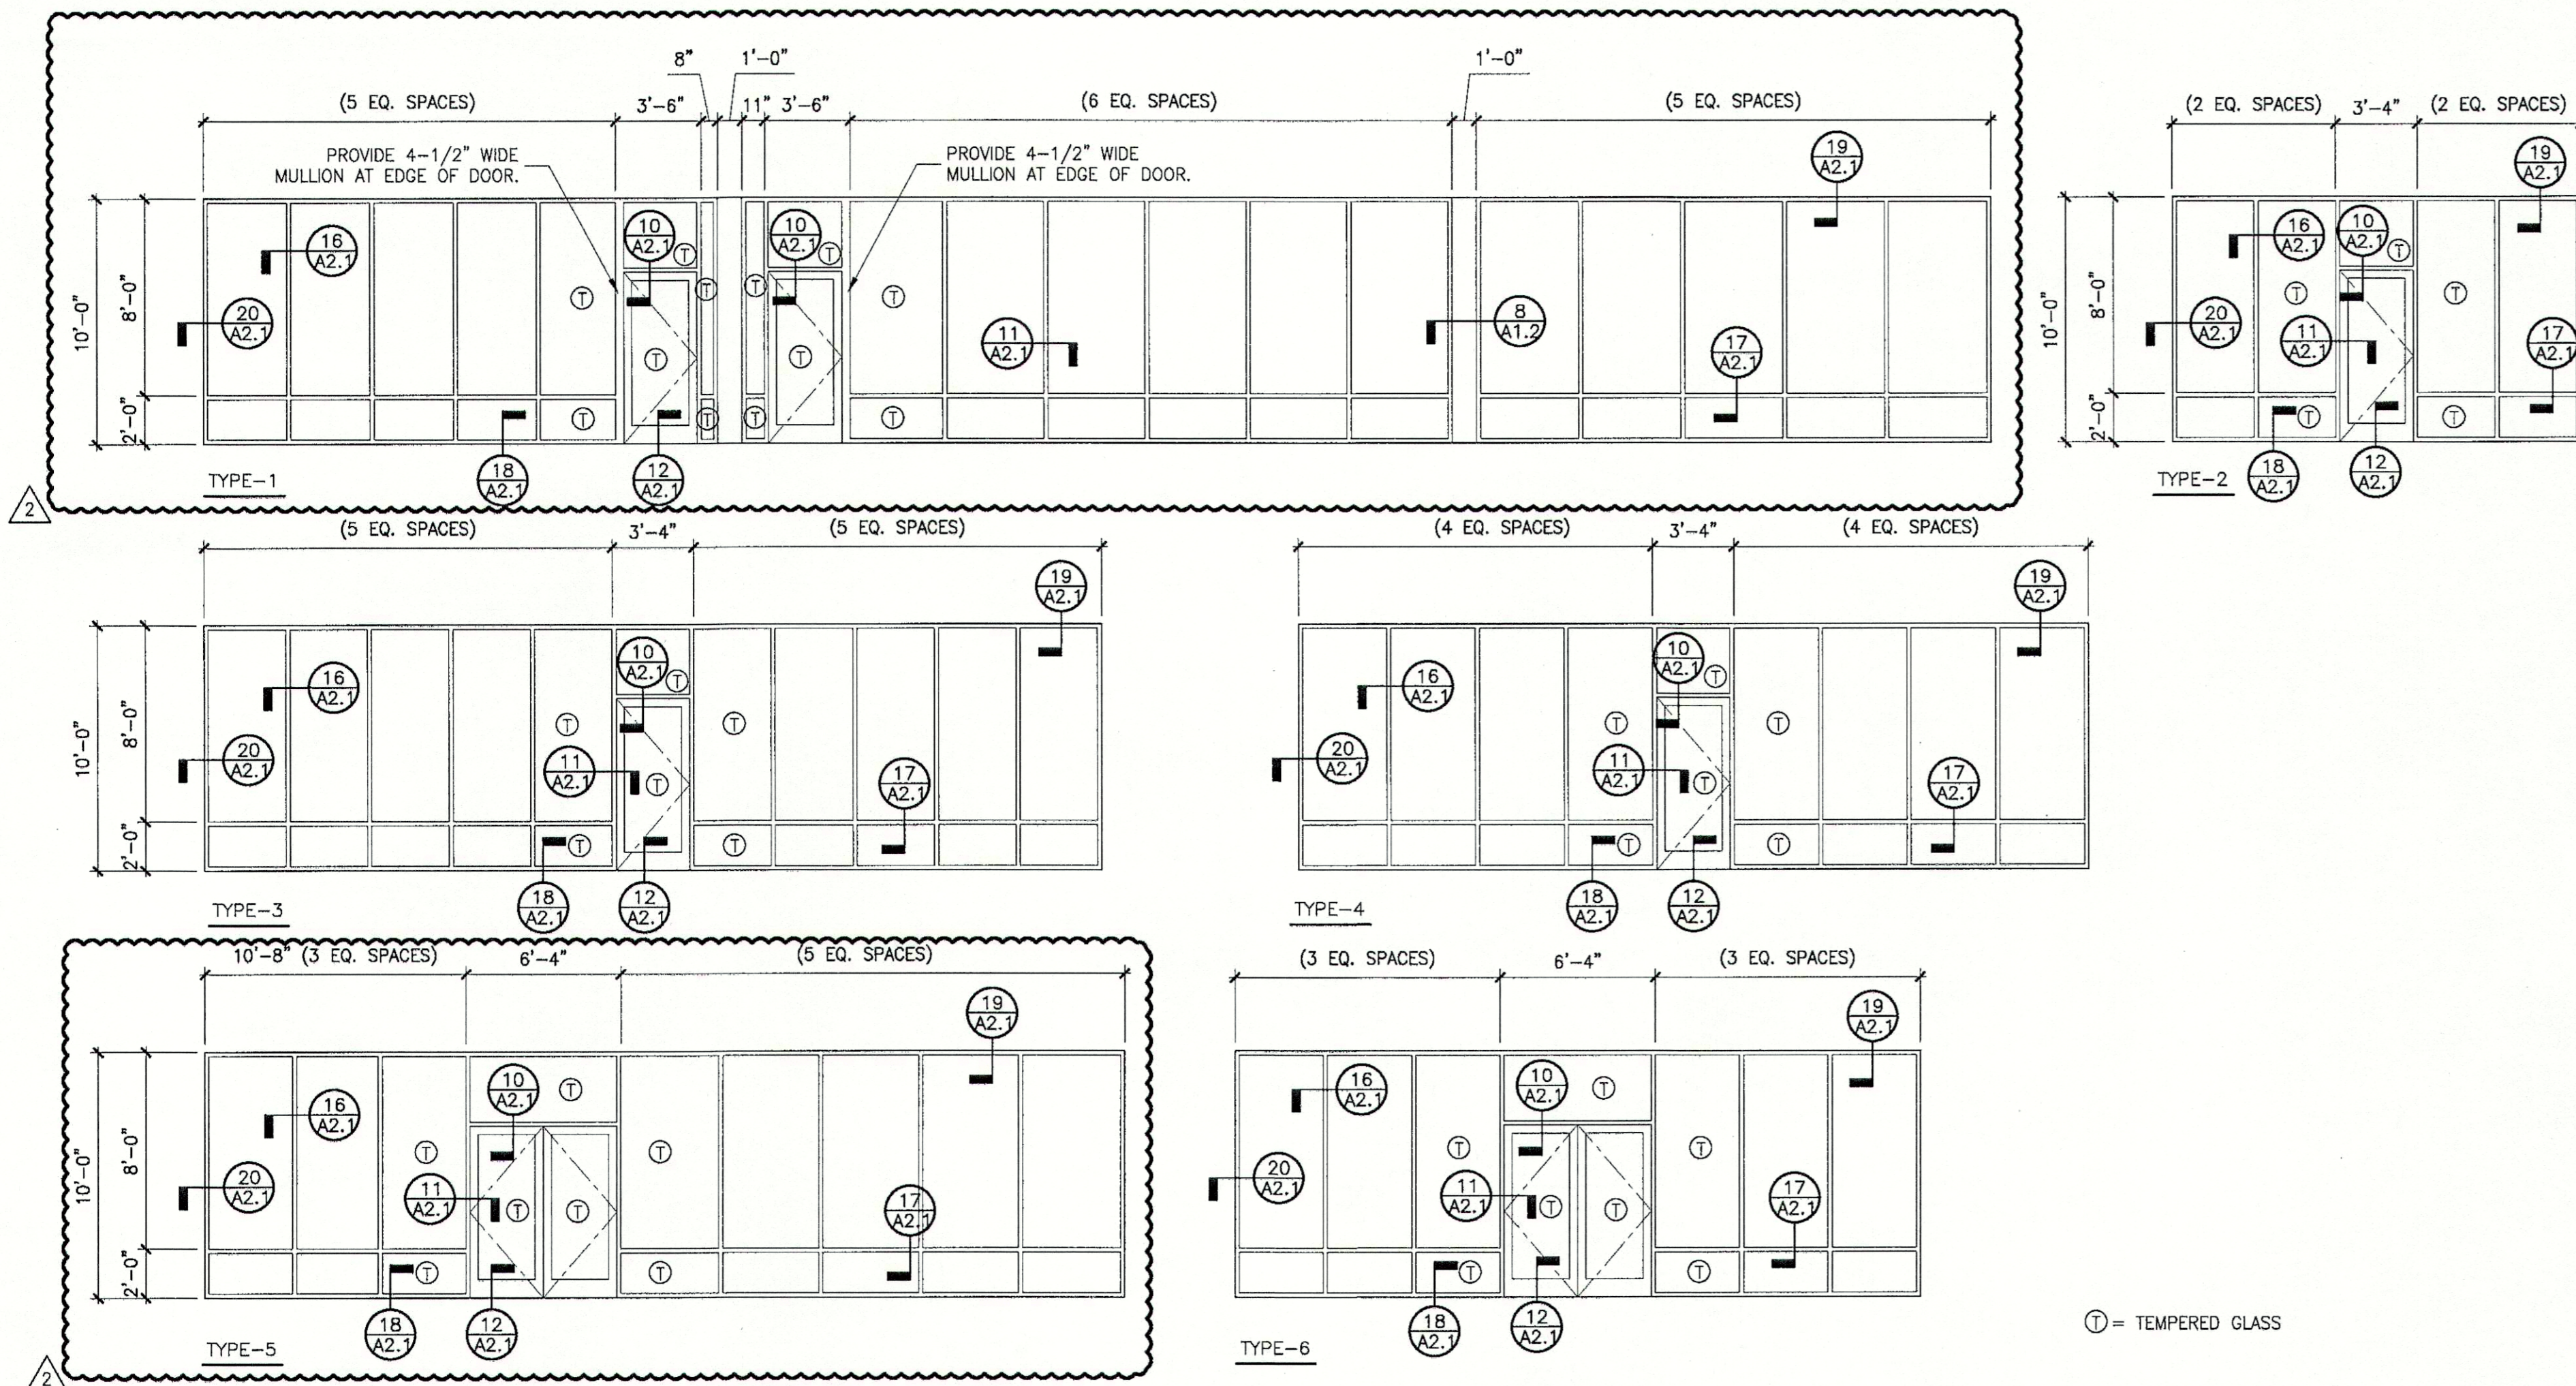


1 STOREFRONT TYPES

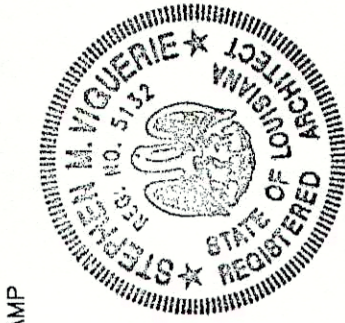

REVISION	
DATE	DESCRIPTION
3/14/08	REV #3 LMR
9/17/07	REV #1 LMR
	BY

DDG DUPLANTIS DESIGN GROUP, PC
 Respect • Integrity • Client Satisfaction • Excellence
 THIBODAUX MANDEVILLE HOUSTON
 Civil Engineering • Site Development • Public Works • Architecture
 314 East Bayou Road
 Thibodaux, Louisiana 70081
 Phone: 985-447-0090
 Fax: 985-447-7009

SIGNATURE: *[Signature]*
 DATE: 3/5/08


PROPOSED RETAIL DEVELOPMENT
 CITY OF BOUTTE
 ST. CHARLES PARISH, LOUISIANA
 FOR THE SPECTRA GROUP, INC.
 MEMPHIS, TENNESSEE

DRAWN	LMR
CHECKED	SMV
DATE	8/13/07
SCALE	AS NOTED ON DWG
PROJECT NO.	07-205A
FILE:	REVISION 3\A2-2.DWG
SHEET	

A2.2