


1 STOREFRONT TYPES

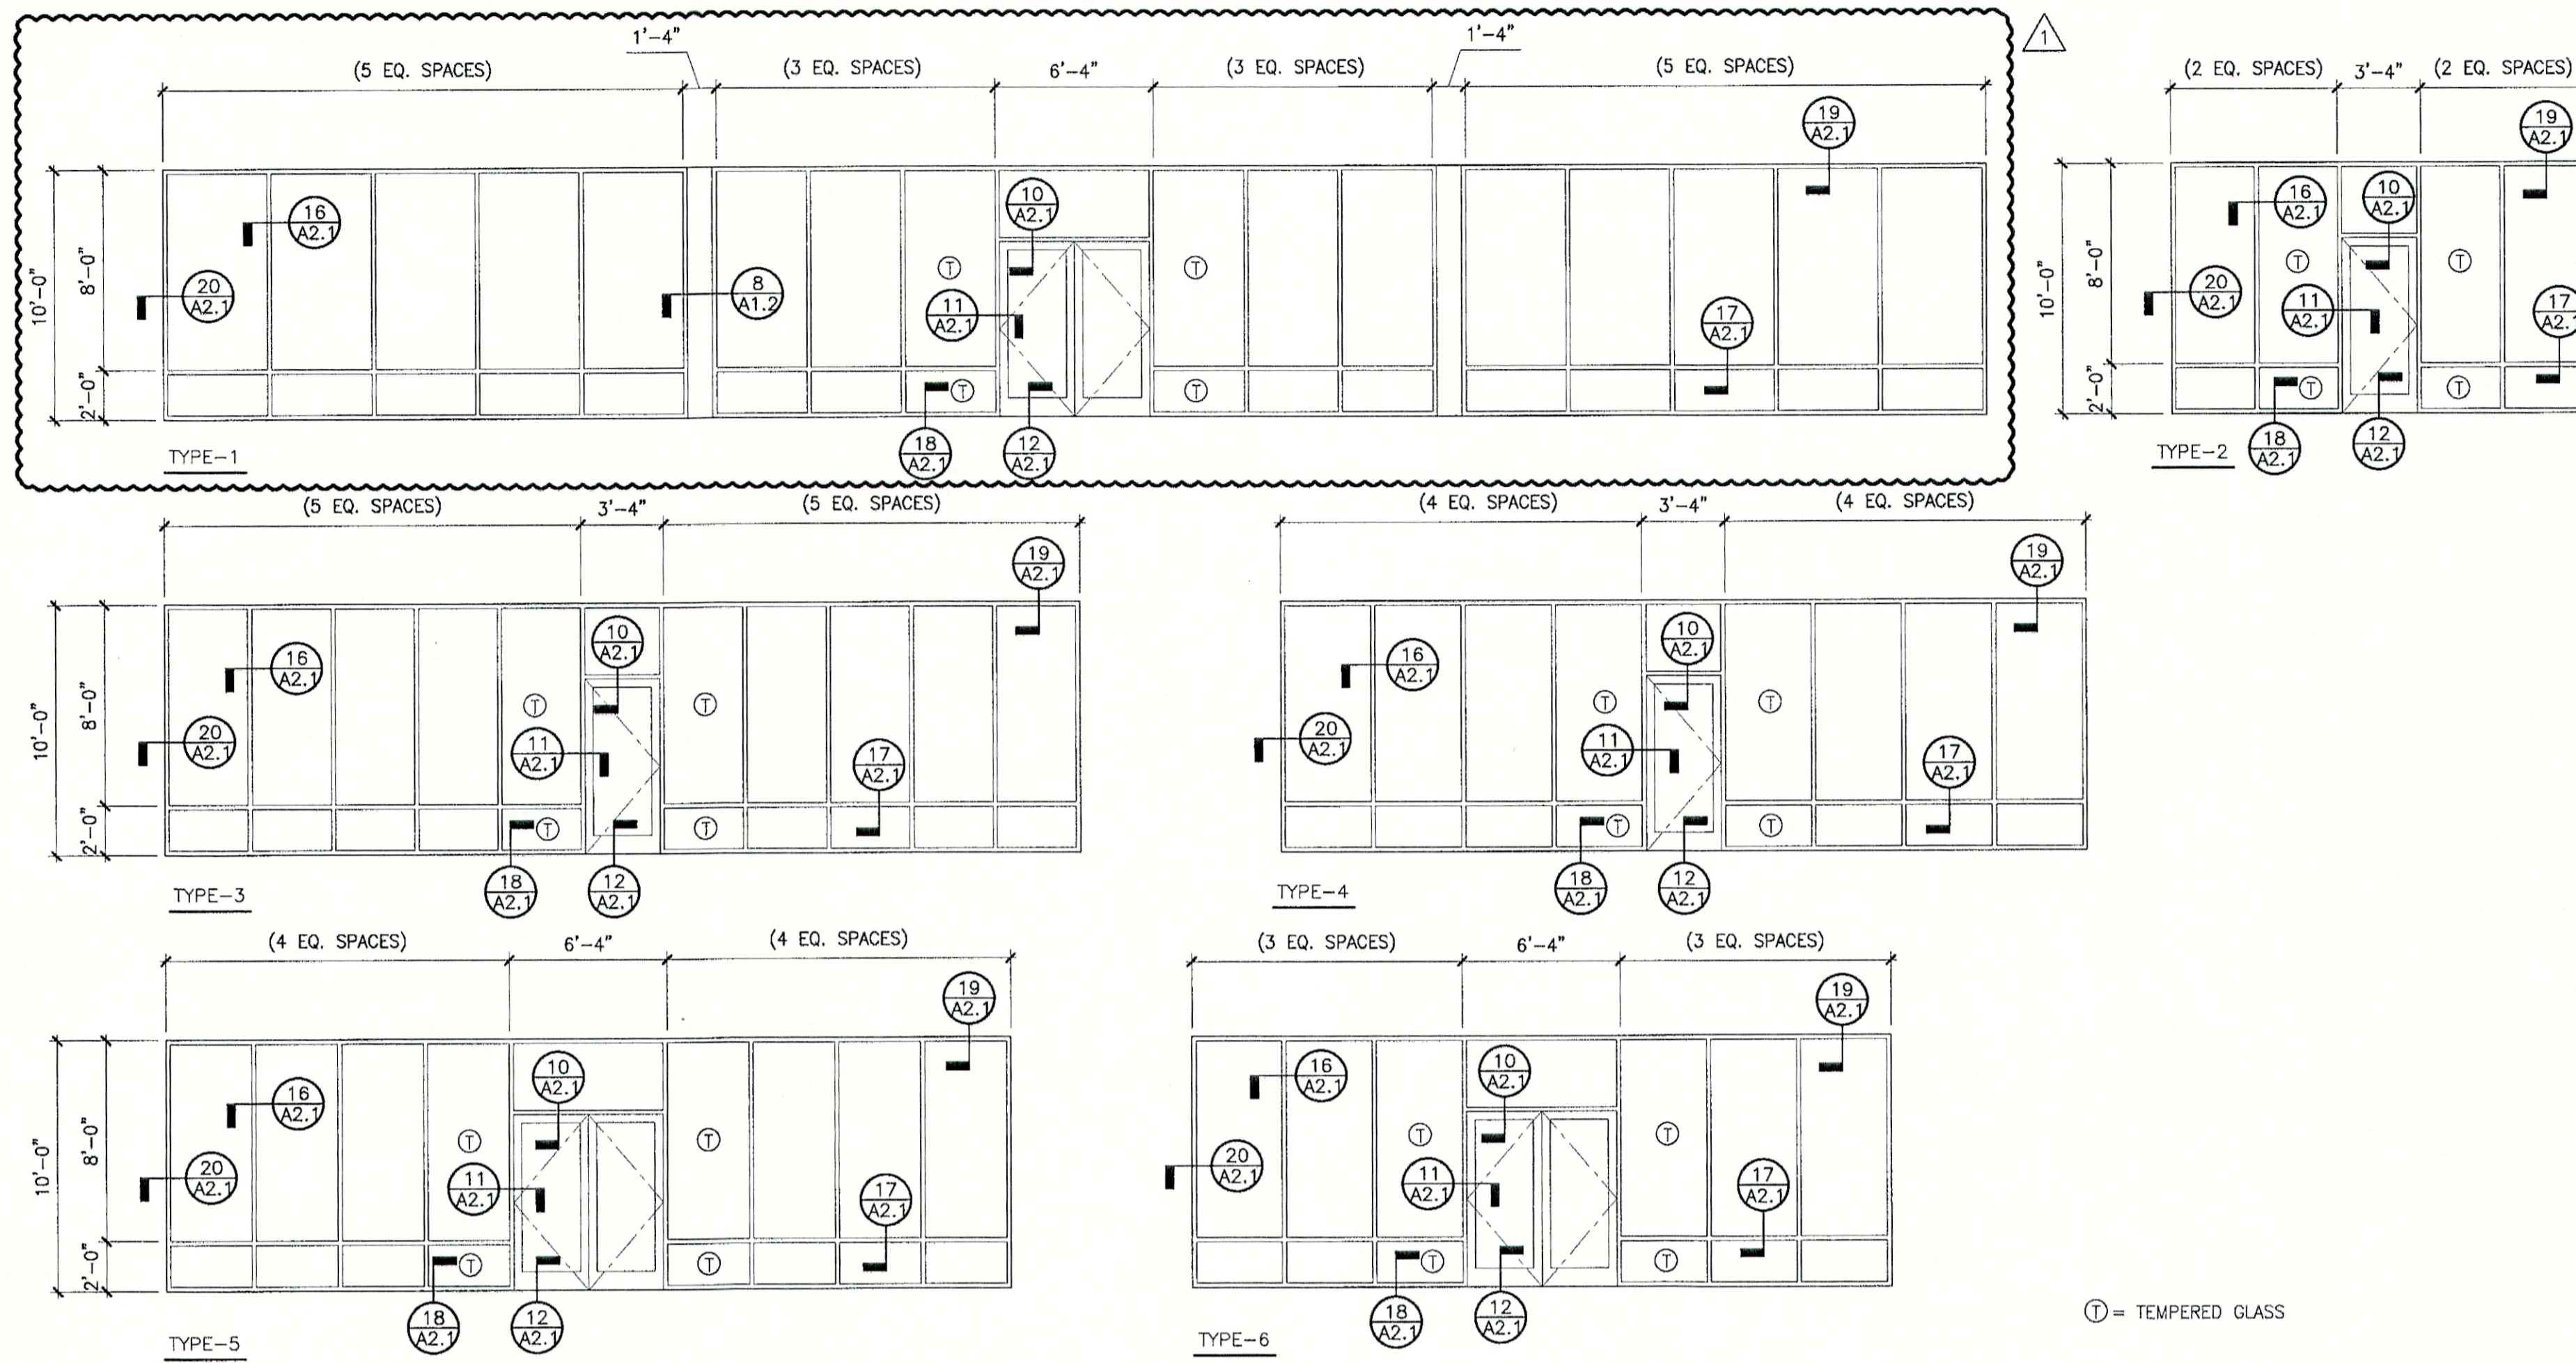

△ = TEMPERED GLASS

DATE	DESCRIPTION	BY
9/17/07	REVISION	LMR

DDG DUPLANTIS DESIGN GROUP, PC
 Respect • Integrity • Client Satisfaction • Excellence
 THIBODAUX, LOUISIANA
 Civil Engineering • Site Development • Land Planning • Public Works
 314 East Main Street • Phone: 985.447.0390
 Thibodaux, Louisiana 70301 • Fax: 985.447.7029

STAMP
 M. VIGIERIE
 ARCHITECT
 NO. 513
 STATE OF LOUISIANA
 REGISTERED
 SIGNATURE: *[Signature]*
 DATE: 9/17/07

PROPOSED RETAIL DEVELOPMENT
 CITY OF BOUTTE
 ST. CHARLES PARISH, LOUISIANA
 FOR THE SPECTRA GROUP, INC.
 MEMPHIS, TENNESSEE

DRAWN	LMR
CHECKED	SMV
DATE	8/13/07
SCALE	AS NOTED ON DWG
PROJECT NO.	07-205A
FILE:	REVISION 1\A2-2.DWG
SHEET	A2.2