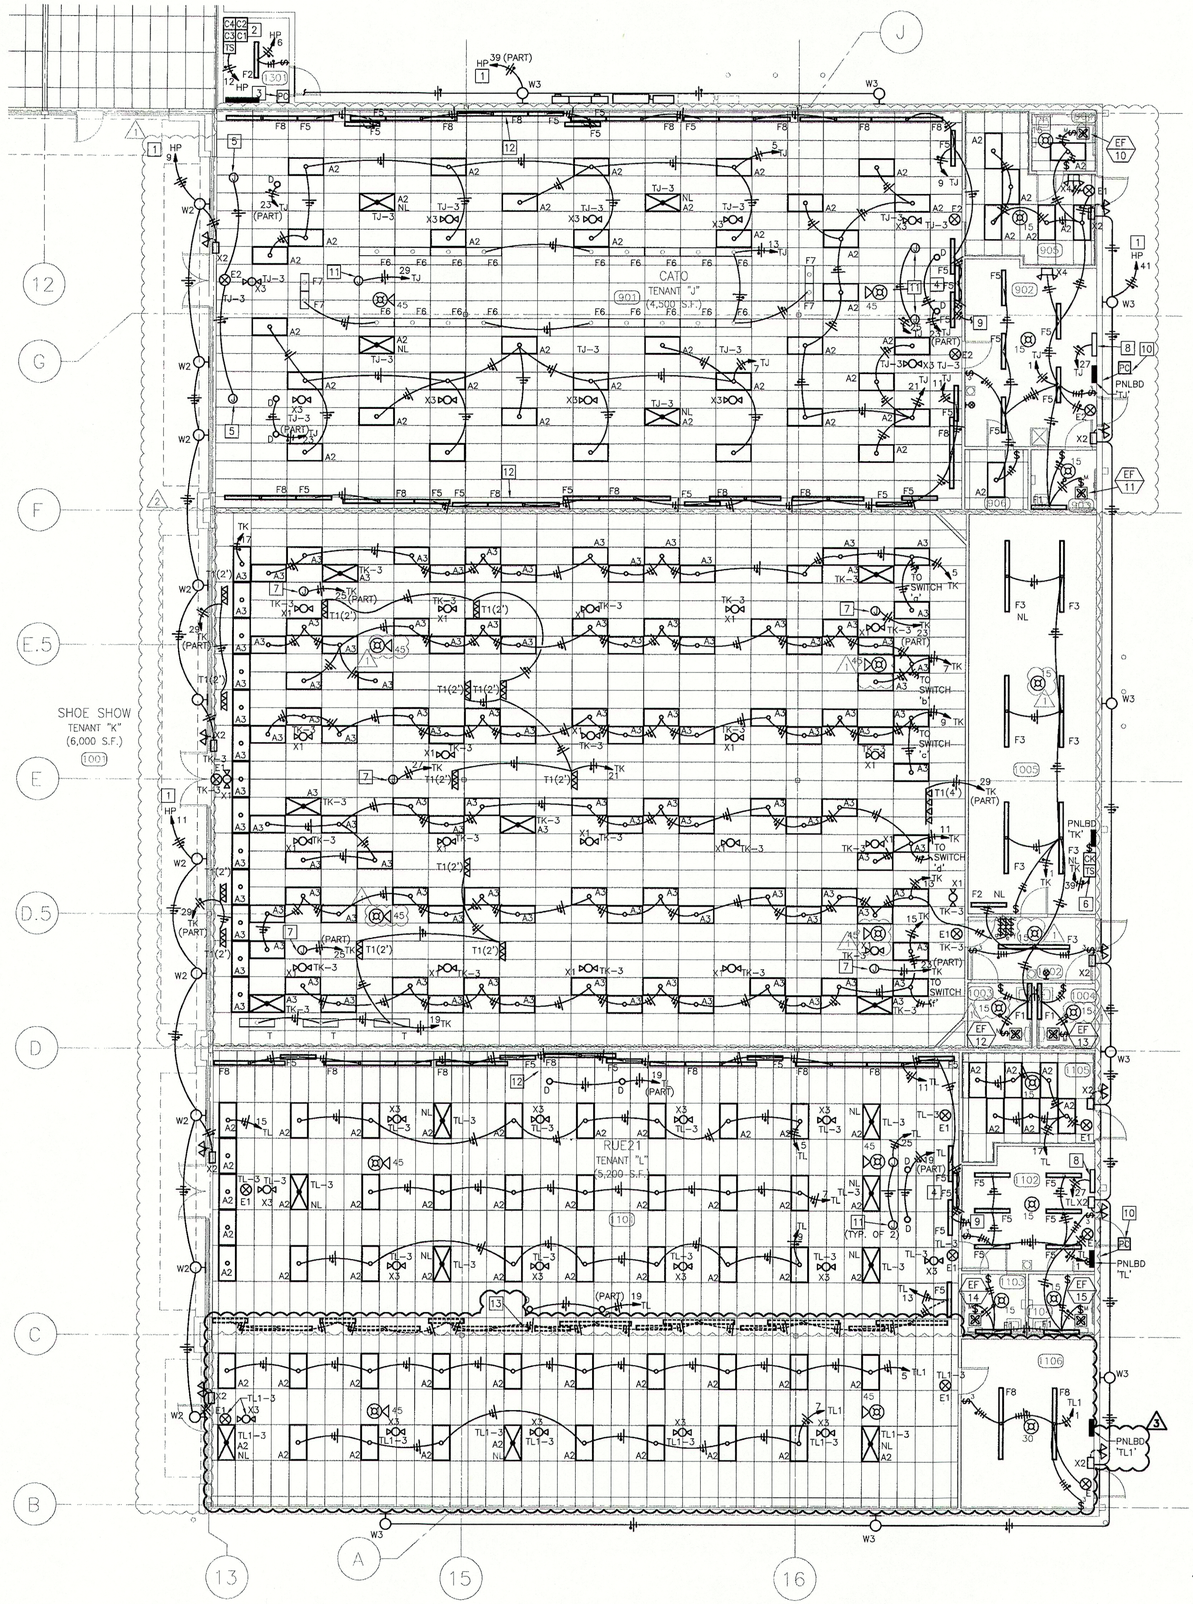

GENERAL ELECTRICAL NOTES:

1. PROVIDE UNSWITCHED CONDUCTOR FOR EMERGENCY FIXTURES AND EXIT SIGNS.
2. INSTALL ALL EMERGENCY EXIT LIGHTS AND EXIT SIGNS AT 9'-0" OR JUST BELOW CEILING IN CASES WHERE CEILING IS LOWER THAN 9'-0".
3. INTERCONNECT RESTROOM FAN WITH RESTROOM LIGHT AND SWITCH.
4. PROVIDE MINIMUM OF (2)#12, (1)#12 GND. FOR ALL CIRCUITS. 1
5. ADDITIONAL FIRE ALARM NOTIFICATION APPLIANCES WILL BE PROVIDED UNDER INDIVIDUAL TENANT FINISH CONTRACTS AS NECESSARY.

ELECTRICAL PLAN NOTES:

1. HOMERUN CIRCUIT(S) THRU CONTACTOR CONTROLLED BY PHOTOCELL AND/OR TIME SWITCH. REFER TO CONTACTOR SCHEDULE ON SHEET E5 FOR CONTROL SEQUENCE.
2. TIMESWITCH AND CONTACTORS FOR CONTROL OF EXTERIOR LIGHTS. REFER TO CONTACTOR SCHEDULE AND SPECIFICATIONS FOR ADDITIONAL INFORMATION.
3. MOUNT PHOTOCELL ON ROOF FACING NORTH.
4. PROVIDE LIGHT FIXTURES FOR BACK BAR SECTION. TOTAL OF THREE (3) TYPE F5 LIGHT FIXTURES ABOVE AND BELOW. PROVIDE FINAL INSTALLATION TO TENANT PROVIDED BACK BAR. 1
5. PROVIDE JUNCTION BOX AND FINAL CONNECTION OF TENANT (CATO) PROVIDED LIGHT FIXTURES.
6. PROVIDE CONTACTOR AND SWITCH FOR INTERIOR LIGHTING. REFER TO CONTACTOR SCHEDULE ON SHEET E9 AND PANELBOARD SCHEDULES ON SHEET E8 & E9.
7. PROVIDE JUNCTION BOX ABOVE ACCESSIBLE CEILING FOR CEILING FANS. LANDLORD CONTRACTOR TO INSTALL TENANT PROVIDED CEILING FAN. 1
8. PROVIDE "SMART STORE CONTROL CETER" HSSCC-12 FOR INTERIOR LIGHTING CONTROL FROM NESCO. CATO HAS A NATIONAL AGREEMENT AND WARRANTY WITH NESCO NATION ACCOUNTS FOR ALL GE SWITCHGEAR, ALL PANELBOARDS , BREAKERS DISCONNECTS, SWITCHES, AND CONTACTORS CAN BE PURCHASED FROM NESCO. CONTACT NESCO AT 800-244-6980 OR TRAVIS BRAMLETT AT 704-201-6146.
9. CONNECT TO (3) F5 FIXTURES BELOW ON BACK PANEL.
10. MOUNT PHOTOCELL FOR CATO/IT'S FASHION ON BUILDING FACING NORTH.
11. PROVIDE JUNCTION BOX FOR TENANT PROVIDED EQUIPMENT.
12. PROVIDE LIGHT FIXTURES MOUNTED ON TOP OF WALL FOCAL SECTION.
13. REMOVE ALL LIGHT FIXTURES MOUNTED ON TOP OF WALL FOCAL SECTION OF REMOVED WALL.

1 LIGHTING FLOOR PLAN
SCALE: 1/8"=1'-0"

HENDERSON ENGINEERS
8325 LENEXA DRIVE
LENEXA, KS 66214
TEL 913 742 5000 FAX 913 742 5001
www.hel-eng.com
0750001106

DATE	DESCRIPTION	BY
3/04/08	REVISION #3	FLS
6/05/08	REVISION #4	FLS
3/13/09	REVISION #6	DWL

REVISION

DDG DUPLANTIS DESIGN GROUP, PC
Respect • Integrity • Client Satisfaction • Excellence
THIBODAUX MANDEVILLE HOUSTON
Civil Engineering • Site Development • Land Planning • Public Works • Architecture
714 East Bayou Road
Thibodaux, Louisiana 70301
Phone: 985.447.5020
Fax: 985.447.5030

SIGNATURE:

DATE:

STAMP: STATE OF LOUISIANA — CRAIG R. LANHAM, REG. NO. 25358, REGISTERED PROFESSIONAL ENGINEER IN ELECTRICAL ENGINEERING — 3-12-09

PROPOSED RETAIL DEVELOPMENT
CITY OF BOUTTE
ST. CHARLES PARISH, LOUISIANA

FOR THE SPECTRA GROUP, INC.
MEMPHIS, TENNESSEE

DRAWN	FLS
CHECKED	DWL
DATE	6/13/07
SCALE	AS NOTED ON DWG
PROJECT NO.	0750001106
FILE.	0750001106E3.DWG
SHEET	E3

G:\Programs\Duplantis\0750001106 Spectra Retail Center - Boutte - LA\000\Elec\0750001106E3.dwg, Plot, 3/13/2009 4:01:32 PM, cheyenmarrock, 1:1