


Quinn #7452
Chalmette, LA

N = ↓

Roof
Survey

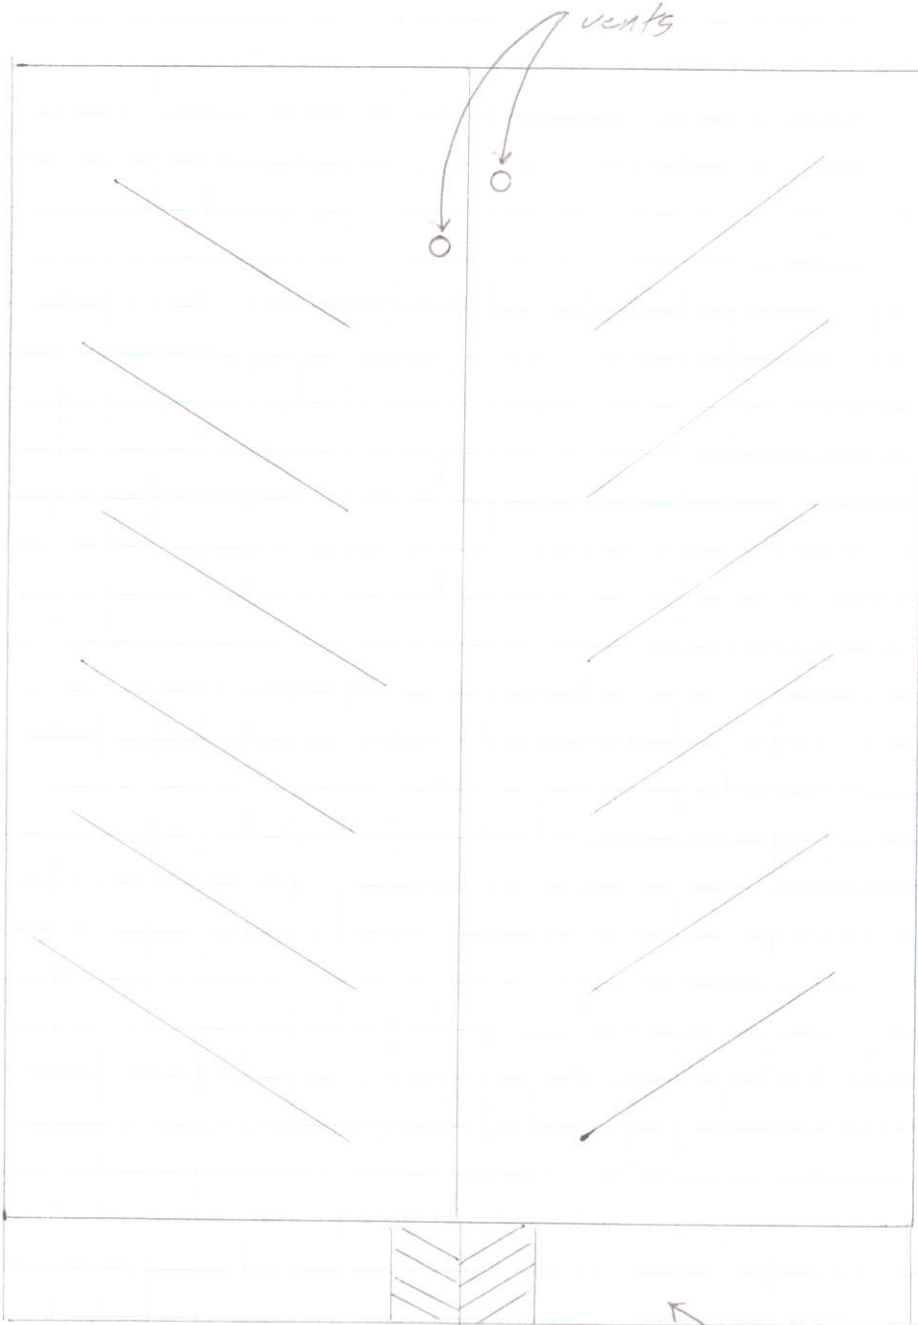

front signage
area of building