


CHANGES MADE: ADDED 2EA 18"X60" AND 2EA 18"X54" RACKS IN COOLER
 CHANGED 3 COMP TO 4 COMP SINK NEW MODEL # 314-16-4-24
 REPLACE 2 EA 24"X48" RACKS FOR 18"X48" RACKS

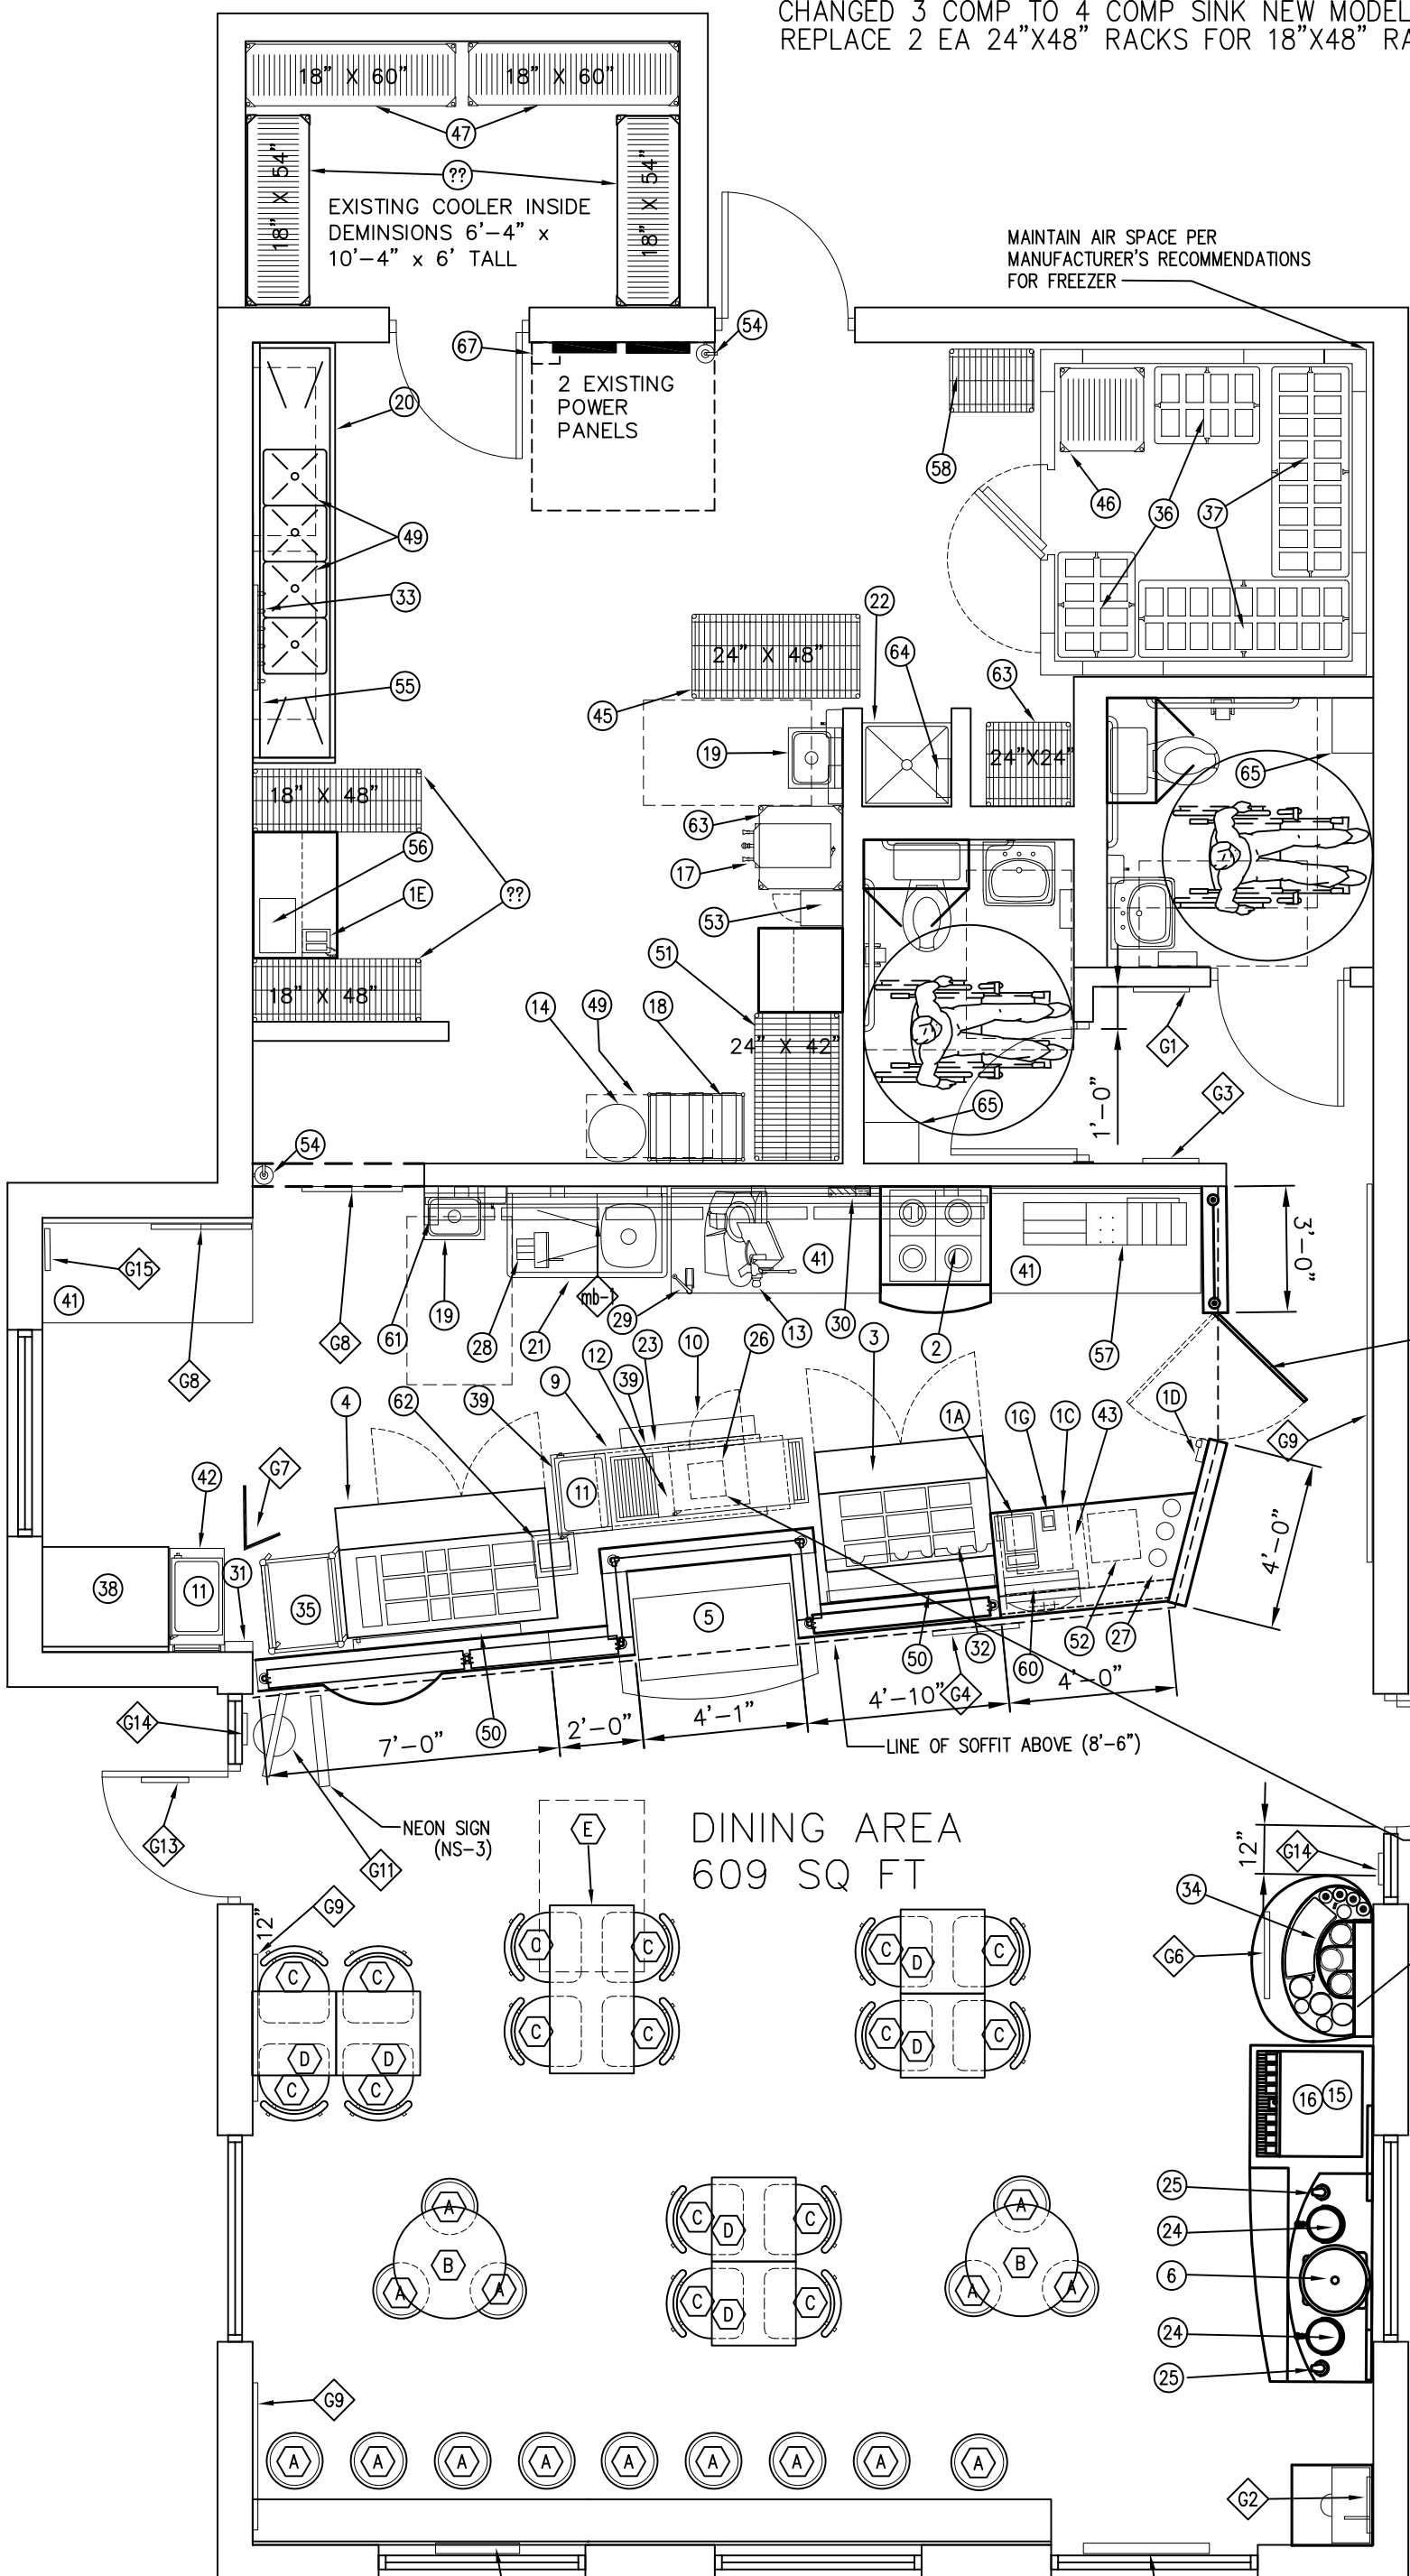

MAINTAIN AIR SPACE PER
 MANUFACTURER'S RECOMMENDATIONS
 FOR FREEZER

UNOBSTRUCTED
 CEILING HEIGHT
 9'-4"
 FREEZER HEIGHT IS 8'-6" A.F.F.
 THIS STORE WILL
 REQUIRE A REMOTE
 COMPRESSOR FOR
 THE FREEZER

3'-0" DOUBLE ACTION
 SWING GATE

THIS STORE WILL REQUIRE
 A TOASTER FOR 240V

240V TOASTER MUST BE LOCATED
 6" TO 8" AWAY FROM SNEEZE
 GUARD TO PREVENT GLASS
 FROM BREAKING

COMPACT PEPPER BAR

DINING AREA
 609 SQ FT

STORE #8336
 1444 TOTAL SF

(NS-2)
 NEON SIGN

(NS-1)
 NEON SIGN