

## CONSTRUCTION DOCUMENTS REVIEW

May 10, 2007

Dammon Engineering Inc  
1095 Florida Ave  
Slidell, LA 70458

RE: QUIZNOS SUB #11329  
Meridian Crossroads  
Highway 19 and I20 Shop 204  
Meridian, MS 39301

Dear David:

I have reviewed the construction documents for the above location, based on The Quiznos Master LLC design criteria, equipment standards, material and general information, and have the following comments and/or concerns:

The construction documents for the above project are:

**APPROVED** OM  
(Based on compliance with the below comments, concerns, issues)

**NOT APPROVED (RESUBMIT)** \_\_\_\_\_  
(Because of the below comments, concerns, issues)

- 
- a. This store will use the materials, methods and general information that is found and detailed in the **Q2006 Architectural and Construction Manual Version One**.
  - b. **All construction documents must reflect Addendum #4 and the Cost Reduction Program.** If the construction documents were sent to our department prior to Addendum #4 the architect is responsible for revising all plans affected by the changes.
  - \*c. **Refer to prototype for correct wall covering placement.** "V2" to be place behind the soda and ice machine.
  - d. A standard Q-Vent will be ordered per the QVent worksheet.
  - e. **An 8'x8'x9'-6" freezer, remote compressor, will be ordered per the Kolpak worksheet. Verify.**
  - f. **A 6'x'6x7'-6" cooler, remote compressor, will be ordered. Verify.**
  - g. **A 208V toaster will be ordered. Verify.**
  - h. **Effective immediately- Place the toaster oven 6" to 8" away from the FRP to prevent the FRP from melting due to high temperatures from the toaster oven.**
  - i. **Verify clearance of service line due to toaster moving.**
  - j. **Verify two (2) 20-amp circuits are provided for the soup station.**
  - k. All millwork will be ordered as standard prototype sizes.
  - l. Note: all sneeze guard glass must be angled 15 degrees, VERIFY.


m) The electrical panel has been noted as existing and will not be ordered.

This review is performed solely for Quizno's benefit to ensure that the schematic layout meets the requirements of The Quiznos Master LLC and complies with the design and specifications. It shall become incumbent upon you, the Project Architect to insure that the Franchisee have a final architectural plan set that complies with all applicable codes and regulations, as well as mechanical and electrical requirements suited to the restaurant needs.

During the Construction Drawing and Construction Administration phase of the project, keep us informed of any substantial changes and/or problems to the schematic. Copies of any clarifications or addenda's issued, should be sent to The Quiznos Master LLC Design and Construction Department as soon as they are issued.


Should any questions or concerns arise during this project, please contact me at [amiller@quiznos.com](mailto:amiller@quiznos.com), if I can be of any assistance.

Respectfully,  
**THE QUIZNO'S MASTER LLC**

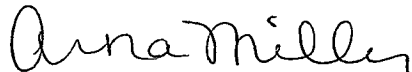

Arna Miller  
Design & Construction Department

cc: David Lake  
Shaun Polak

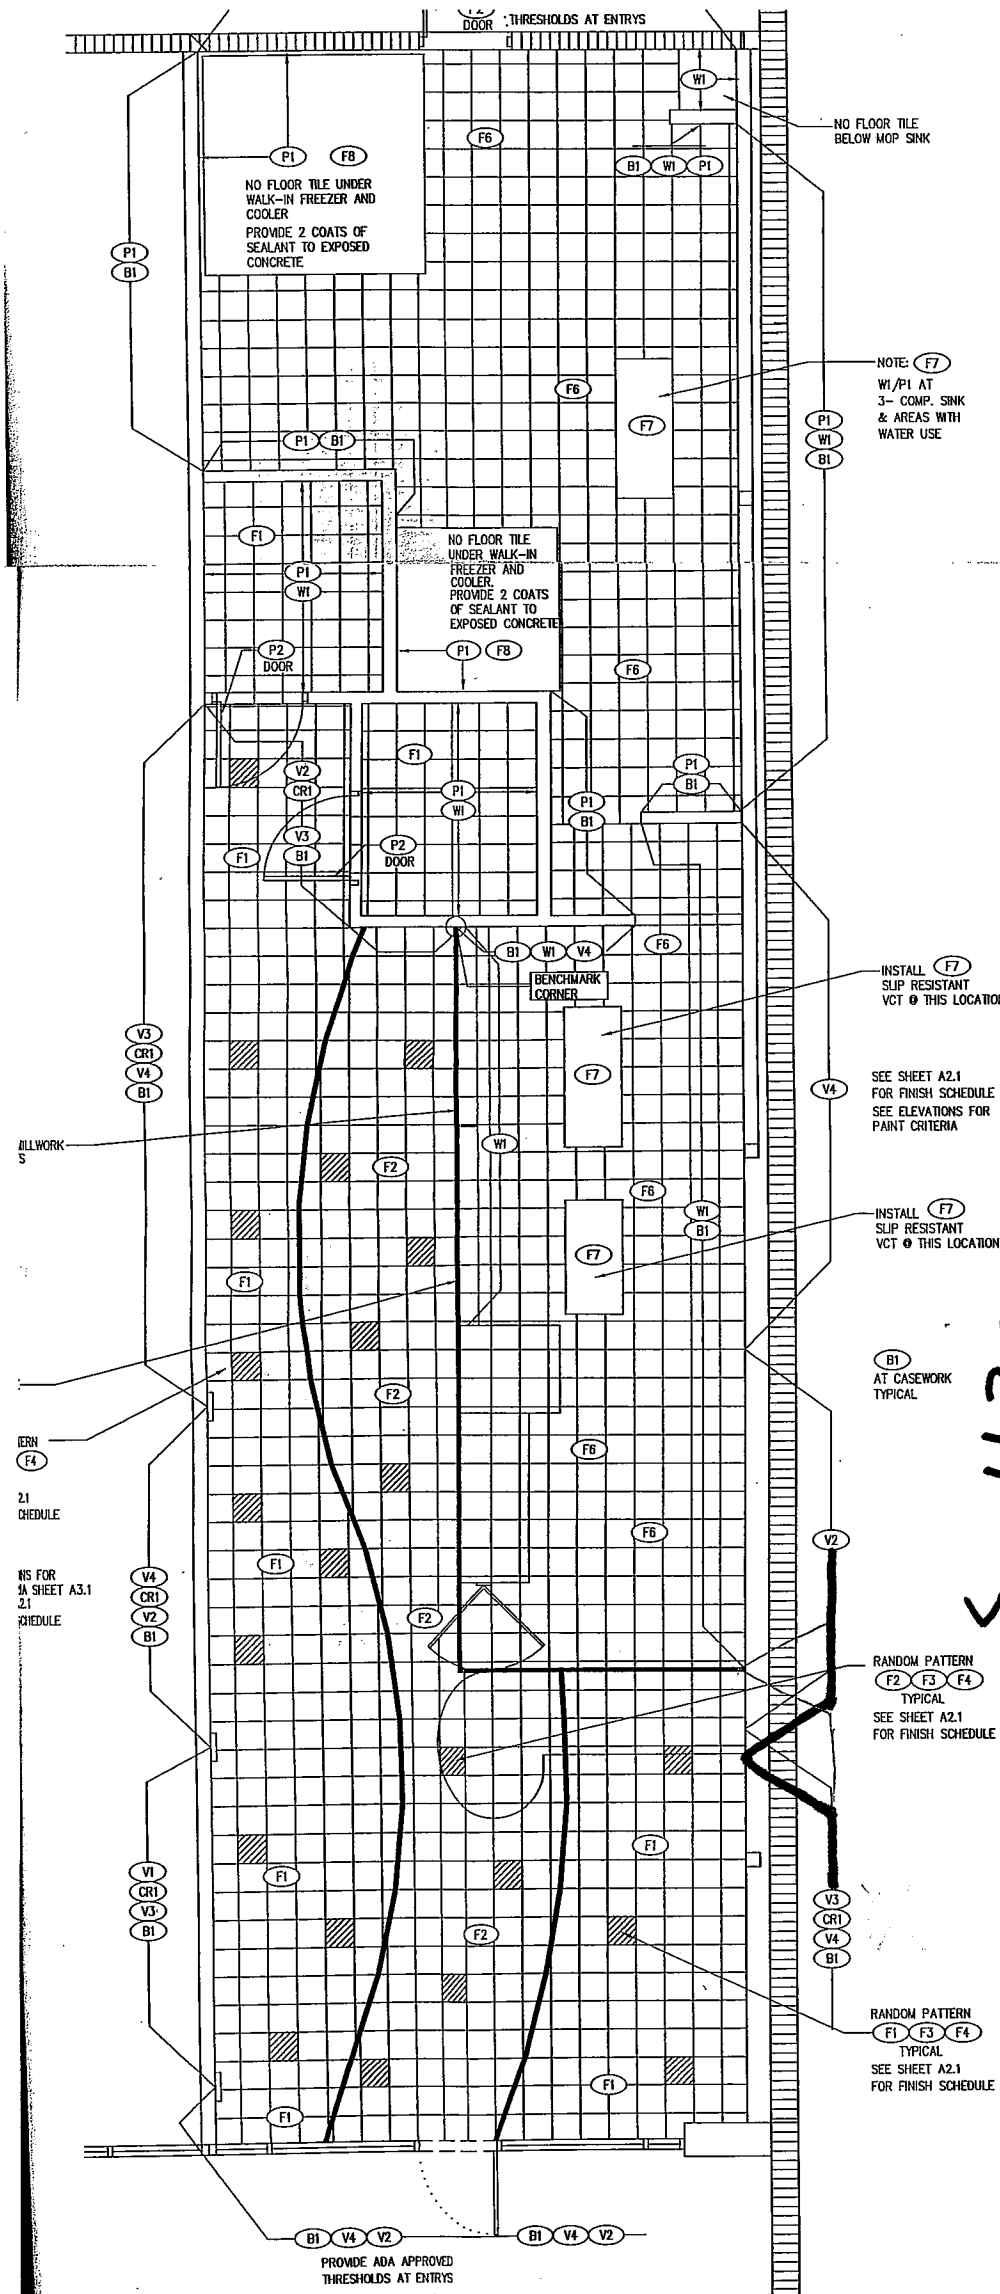

11329

V2 behind soda machine

FINISHES PLAN  
SCALE: 1/4" = 1'-0"

FINISHING & FINISH P.L.  
PROJECT #11329  
SC  
FIL  
JO  
DA  
SH  
0