EQUIPMENT SCHEDULE ⓧ

MARK	QTY	DESCRIPTION	MANUFACTURER	MODEL NO	WATER C	WATER H	WATER DR	GAS	ELECTRICAL V	ELECTRICAL PH	ELECTRICAL A	ELECTRICAL HP	FURN BY	INSTALL BY	REMARKS
1A	1	ORDER TERMINAL							120	1	20		KEC *	OWNER	
1B	1	CASH TRAY DRAWER											KEC *	OWNER	SEE INTERIOR ELEVATIONS ON SHEET A3.1 FOR PLACEMENT
1C	2	TELEPHONE											KEC *	OWNER	SERVICE COUNTER, MANAGERS DESK
POS 1D	1	FAX MACHINE							120	1			KEC *	OWNER	SEE INTERIOR ELEVATIONS ON SHEET A3.1 FOR PLACEMENT
1E	1	RECEIPT PRINTER							120	1			KEC *	OWNER	
SEE SHEET A1.2 FOR ADDITIONAL POS NOTES															
2	2	SOUP STATION	APWyott	CW-2A					120	1	(2) 16		KEC *	GC	
3	1	SANDWICH TABLE (72")	DELFIELD	DEL4460N-30M-DZN1					115	1	10.5	1/2	KEC *	GC	FLAT LID
4	1	SANDWICH TABLE (48")	DELFIELD	DEL4460N-24M-DZN1					115	1	8.6	1/3	KEC *	GC	FLAT LID
5	1	MERCHANDISER	STRUCTURAL CONCEPTS	URS54646					120		12		KEC *	GC	SELF-CONTAINED
6	1	SINGLE FLAVOR DRINK DISPENSER	CORNELIUS	EJ1					115	1	5		KEC *	GC	
7	1	WALK IN COOLER	KOLPAK	5'-9"x5'-9"x9'-6" H			3/4" ID		115	1		1/2	KEC *	GC	PROVIDE CLEARANCE ACCORDING
8	1	WALK IN FREEZER	KOLPAK	6'-9"x5'- 9"x9'-6" H			3/4" ID		208	1	1		KEC *	GC	VERIFY OVERHEAD CLEARANCE
9	1	CONVEYOR TOASTER	HOLMAN	QT114C					208	1	37.5		KEC *	GC	GC TO PROVIDE TWIST LOCK PLUG & ELECTRICAL WHIP & SEE NOTE 3
10	1	MICROWAVE OVEN	AMANA	RCS10D					120	1	15.0		KEC *	GC	ON LOWER SHELF OF 39, PROVIDE 6' CORD
11	2	COOKER/WARMER	APW WYOTT	W-3V					120	1	10		KEC *	GC	LOCATE ON 39 AND 42
12	1	EXHAUST HOOD	JOHNSON DIVERSIFIED	QVENT					115	1		1/6	KEC *	GC	SUPPLIED W/ SEPARATE 8"x8" SS DUCT
13	1	SLICER	HOBART	2912					120	1	6.2	1/2	KEC *	GC	
14	1	C02 TANK											VENDOR	GC	VENDOR TO PROVIDE ATTACHMENT APPARATUS TO WALL
15	1	ICE MAKER	MANITOWOC	QY-0454A	1/2"		1/2" ID		115	1	12.8		KEC *	GC	LOCATED ON 15, ID TO FLOOR SINK
16	1	DRINK DISPENSER	CORNELIUS	ENDURO 250	1/2"		1" ID		115	1	3.5		KEC *	GC	FURNISHED BY PEPSI , ID TO FLOOR SINK
17	1	TEA BREWER	CURTIS	CBS 10000	1/2"				120	1	18		KEC *	GC	SUPPLIED W/ FILTER.
18	1	BAG-IN-BOX/PUMPS	PROFIT MASTER 4						115	1	7		KEC *	GC	FURNISHED BY PEPSI
19	2	HAND SINK	EAGLE	HSA-10-F	1/2"	1/2"	1 1/2"						KEC *	GC	SILICONE SEALANT AT WALL, PROVIDED W/ SS SPLASH GUARDS.
20	1	3 COMPARTMENT SINK W/ 24" DB	EAGLE/METAL MASTERS	314-16-3-24	1/2"	1/2"	2" ID						KEC *	GC	SEE NOTE 2., SILICONE SEALANT AT WALL
21	1	VEGETABLE SINK	EAGLE/METAL MASTERS	314-16-1-24L, LH DB	1/2"	1/2"	2" ID						KEC *	GC	NOTE 5, SILICONE SEALANT AT WALL, ID TO FLOOR SINK
22	1	SERVICE SINK (MOP SINK)	JONESPEC	MB-2600-24	1/2"	1/2"	3" DD						GC	GC	PROVIDE BUCKET HOLDER
23	1	RACK RAIL (FOR TOASTER)	PRECISION INDUSTRIES INC.	RACK RAIL									KEC *	GC	SUPPLIED BY SOURCE ONE DIST.
24	1	TEA DISPENSER	CURTIS	TC0421									KEC *	GC	
25	2	STAINLESS STEEL CORNER GUARD	BOBRICK	B-833 - 48" TALL									GC	GC	SET ATOP WALL BASE
26	1	Q VENT COVER	QUIZNOS	STAINLESS STEEL									KEC *	GC	DECORATIVE EXHAUST DUCT WRAP
27	1	CUP DISPENSERS	SAN JAMAR	C2410C									KEC *	GC	MATCH ANGLE OF ADJACENT CASEWORK
28	1	VEGETABLE SLICER	NEMCO	N55200AN									KEC *	GC	GC TO MOUNT ON LEFT SIDE OF DRAIN BOARD
29	1	CAN OPENER	EDLUND	NO 2									KEC *	GC	GC TO MOUNT ON LEFT SIDE OF TABLE SHOWN
30	1	KNIFE RACK	EDLUND	KR-99									KEC *	GC	WALL MOUNTED ABOVE WORK TABLE
31	2	SCALE STAND	QUIZNOS	STAINLESS STEEL									KEC *	GC	
32	1	STAINLESS STEEL SHELF	BOBRICK	B-296X18									KEC *	GC	TOP OF SHELF TO BE AT 4'-8" FOR STORAGE OF CLEANING SUPPLIES
33	0	STORAGE SHELF - 18" x 36"	EAGLE/METAL MASTERS	1836C									KEC *	GC	
34	SET	PEPPER BAR CONTAINERS	CARLISE										KEC *	GC	
35	1	BREAD RACK	PREMIER EUROCASE	QBR-5530									KEC *	GC	RACK WITH GRAPHICS AND BREAD BOXES
36	1	DUNNAGE RACK- FREEZER	METRO	HP2130PD									KEC *	GC	
37	1	DUNNAGE RACK- FREEZER	METRO	HP2160PD									KEC *	GC	
38	0	STORAGE SHELF - 24" x 30"	EAGLE/METAL MASTERS	2430C									KEC *	GC	
39	1	S/S TOASTER TABLE - 36" x 30"	EAGLE/METAL MASTERS	W/CASTERS									KEC *	GC	CUSTOM MADE
40	4	S/S WORK TABLE - 48" x 30"	EAGLE/METAL MASTERS										KEC *	GC	
41	0	S/S WORK TABLE - 60" x 30"	EAGLE/METAL MASTERS										KEC *	GC	
42	2	S/S CART W/ CASTERS	WIN-HOLT	1527H26									KEC *	GC	
43	1	STORAGE SHELF - 24" x 24"	EAGLE/METAL MASTERS	2424C									KEC *	GC	CHROME FINISH, 2 TIER SHELVING, 27" POLES
44	1	STORAGE SHELF - 24" x 36"	EAGLE/METAL MASTERS	2436C									KEC *	GC	CHROME FINISH, 5 TIER SHELVING, 86" POLES
45	0	STORAGE SHELF - 24" x 48"	EAGLE/METAL MASTERS	2448C									KEC *	GC	CHROME FINISH , 5 TIER SHELVING, 86" POLES
46	1	SHLF.-COOLER - 18" x 60"	METRO	1860-63NKS									KEC *	GC	EPOXY COATED, 4 TIER, 63" POLES-COOLER
47	2	SHLF.-COOLER - 18" x 42"	METRO	1842-63NKS									KEC *	GC	EPOXY COATED, 4 TIER, 63" POLES-COOLER
48	1	STORAGE SHELF - 24" x 24"	EAGLE/METAL MASTERS										KEC *	GC	CHROME FINISH , 5 TIER SHELVING, 86" POLES
49	4	SHELF - WALL HUNG 18" x 48"	EAGLE/METAL MASTERS	1848C									KEC *	GC	TOP OF SHELF 68" AND 79" AFF
50	1	MOP HOLDER	SPARTA	40731									KEC *	GC	
51	1	REFRIGERATED BOTTLE COOLER	ELECTROLUX	QUIZNOS BOTTLE COOLER					115	160W	1.8	60H	KEC *	OWNER	
52	1	DEPOSITORY SAFE	CORPORATE SAFE SPECIALISTS	B2020WDIGH-SGITD9-SG									KEC *	GC	BOLT TO FLOOR WITH 4 EXPANSION BOLTS (SUPPLIED)
53	1	EMPLOYEE LOCKERS	WINHOLT	WL66									KEC *	GC	ANCHOR TO WALL 6" MIN. CLEAR BELOW
54	2	FIRE EXTINGUISHERS	LOCAL SUPPLIER										GC	GC	VERIFY QUANTITY W/ LOCAL FIRE DEPT-PROVIDE "EXTINGUISHER" SIGNS
55	1	FIRST AID KIT	RESPOND	100164									KEC *	GC	WALL MOUNTED 60" AFF TO CENTERLINE
56	1	MUSIC SYSTEM	TBD										KEC *	OWNER	
57	1	SOUP AND SALAD ORGANIZER	MICROWIRE PRODUCTS										KEC *	GC	
58	1	CONDIMENT ORGANIZER	CAMBRO	12RS12									KEC *	OWNER	
59	1	STOR. SHLF FREEZER - 18" X 60"	EAGLE/METAL MASTERS	1860-74NKS									KEC *	OWNER	EPOXY COATED, 4 TIER, 74" POLES-FREEZER
60	4	WALL BRACKETS-END UNIT-18"X48"	EAGLE GROUP	WB18-C - END UNIT									KEC *	GC	BOTTOM OF SHELF 68" AND 19" AFF
61	2	WALL BRACKETS-MIDDLE UNIT-18"X48"	EAGLE GROUP	DWB18-C - MID UNIT									KEC *	GC	BOTTOM OF SHELF 68" AND 19" AFF
62	2	DIGITAL PORTION SCALE	TAYLOR	TE32					120				KEC *	GC	5 MILLIAMP TRIP GFI
63	1	STORAGE SHELF - 24" X 24"	EAGLE/METAL MASTERS	2424C									KEC *	GC	SHLF. FOR BREWER,CHROME FINISH , 3 TIER SHELVING, 86" POLES
64	1	SOAP & CHEMICAL DISPENSER											KEC *	GC	SUPPLIED BY SOURCE ONE DIST.
65	2	WASTE RECEPTACLE	AMERICAN SPECIALTIES	0825									KEC *	GC	
66	0	PANEL BOARD	GE INDUSTRIAL SYSTEMS	TYPE AQ (101)									KEC *	GC	
67	1	TIME CLOCK (EXTERIOR SIGNAGE)	GE INDUSTRIAL SYSTEMS	1 TORK 1103							20		KEC *	GC	SUPPLIED BY SOURCE ONE DIST. - SEE NOTE #8.
68	0	SAFETY SWITCH	GE INDUSTRIAL SYSTEMS	GE HD TH4324									KEC *	GC	SUPPLIED BY SOURCE ONE DIST. - (ONLY IF REQ'D.)
69	1	DUAL ORDER BOTTLE RACK	RESTAURANT INTERIORS	QUIZNOS DUAL ORDER BOTTLE RACK									KEC *	GC	SUPP. BY S1DIST, 304 EPQ WELDED S.S, 1 PIECE ELECTRO POLISHED
70	0	SANDWICH TABLE (48")	DELFIELD	DEL4460N-24M-DZN1									KEC *	GC	FLAT LID
102	1	STORAGE SHELF - 18" X 24"	EAGLE/METAL MASTERS										KEC *	GC	SHLF. FOR BREWER,CHROME FINISH , 3 TIER SHELVING, 86" POLES
103	2	STORAGE SHELF - 18" X 36"	EAGLE/METAL MASTERS										KEC *	GC	SHLF. FOR BREWER,CHROME FINISH , 3 TIER SHELVING, 86" POLES
104	2	STORAGE SHELF - 18" X 48"	EAGLE/METAL MASTERS										KEC *	GC	SHLF. FOR BREWER,CHROME FINISH , 3 TIER SHELVING, 86" POLES

REQUIRED SCHEMATIC INFORMATION

ITEM	DESCRIPTION	NOTES
ELECTRICAL PANEL	NEW _____ NEW BY LL __XX___ EXISTING _____	
SIZE OF WALK-INS	COOLER _5'-9"x5'-9"x9'-6" H_ FREEZER _5'-9"x6'-9"x9'-6" H_	
COMPRESSOR TYPE	TOP MOUNT_____ REMOTE __XX__	
MILLWORK DIMENSIONS	SHOWN __XX__	
LEFT HAND VEGGIE SINK	SHOWN __XX__	
3-COMPARTMENT SINK	CUSTOM MODEL # _314-16-3-24_	
CEILING HEIGHT	FRONT OF HOUSE __10'-0" __ BACK OF HOUSE _10'-0"_	
SQUARE FOOTAGE	TOTAL BUILD OUT __1800 S.F._	

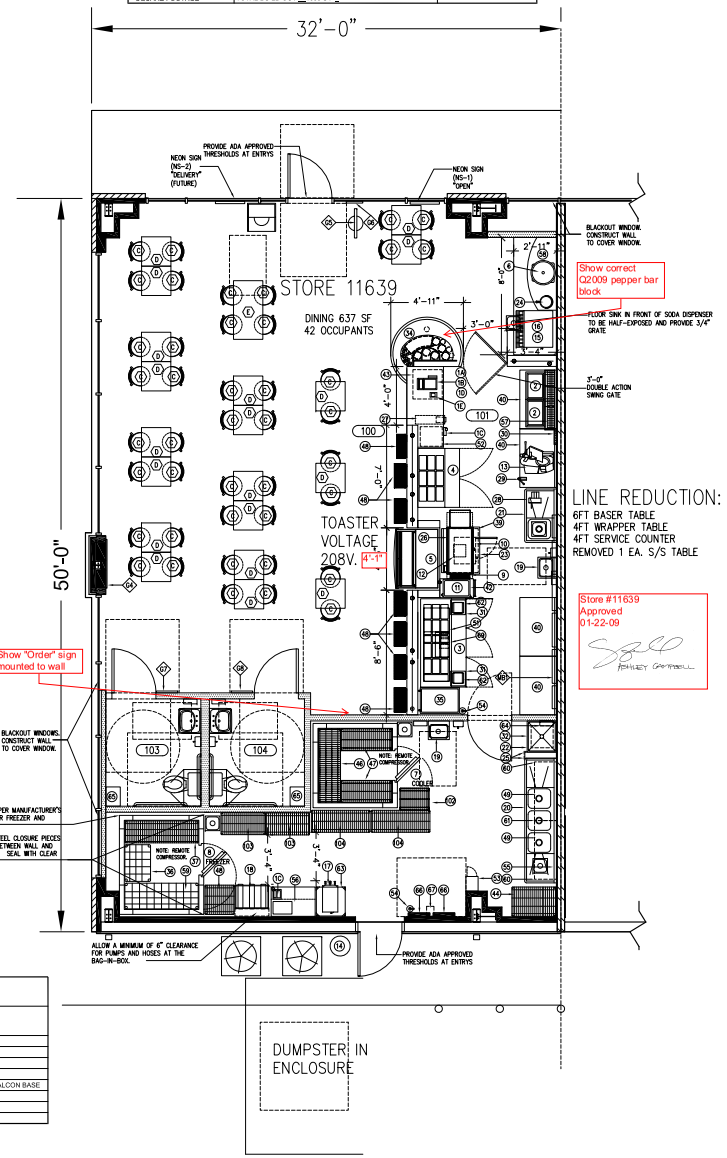

GRAPHICS SCHEDULE ◇

MARK	QTY	DESCRIPTION	FURN BY	INSTALLED BY	REMARKS
G1	1	ARTWORK - TOASTY PLAQUE	OWNER	GC	BOTTOM OF SIGN 4-0" AFF, CENTER HORIZ.
G2	1	ARTWORK - FRESH ACRONYM	OWNER	GC	2" ABOVE TOP OF TRASH, CENTER HORZ.
G3	1	ARTWORK - QUIZNO'S ACRONYM	OWNER	GC	BOTTOM OF SIGN 4-0" AFF, CENTER HORIZ.
G4	4	ARTWORK	OWNER	GC	CENTER HORIZONTALLY AND ROTATE 5°.
G5	1	BRAGGER STAND	OWNER	GC	TO BE IN CUSTOMER ENTRANCE VIEW, 5'-0" TALL.
G6	1	OPEN HOURS DECAL	OWNER	GC	TOP OF DECAL 5'-4" AFF.
G7	1 SET	WOMEN'S RESTROOM SIGN	OWNER	GC	1 ON DOOR AND 1 ON WALL ADJ. TO DOOR. - ADA COMPLIANT.
G8	1 SET	MEN'S RESTROOM SIGN	OWNER	GC	1 ON DOOR AND 1 ON WALL ADJ. TO DOOR. - ADA COMPLIANT.

SIGN SCHEDULE

SIGN SCHEDULE NOTES:
1. HANG FROM STOREFRONT HEAD WITH SUPPLIED CHAINS AND HOOKS.

MARK	DESCRIPTION	MANUFACTURER	FURN BY	INSTALL BY	VOLT	AMP	REMARKS
MB-1	MENU BOARD - 6 PANEL	POSTERLOID	OWNER	GC	120	3	TOP OF MENU BOARD 8'-6 1/4" AFF
NS-1	NEON SIGN - "Q OPEN"	ZEON	OWNER	GC	120	1.2	NOTE 1, TOP OF SIGN 8'-2" AFF
NS-2	NEON SIGN - "DELIVERY" (FUTURE)	ZEON	OWNER	GC	120	1.2	NOTE 1, TOP OF SIGN 8'-2" AFF
NS-3	NEON SIGN - "ORDER MMMM..	ZEON	OWNER	GC	120	1.2	NOTE 1, BOTTOM OF SIGN 84" A.F.F.
S-5	NEON SIGN - EXTERIOR		OWNER	OWNER	VERIFY	NOT SHOWN THIS SHEET- (NIC) SEE SHEET A3.1	

FURNITURE SCHEDULE ⓧ

ITEM	QTY	DESCRIPTION	MANUFACTURER	REMARKS
A	*	STOOLS	TOWER ASSOCIATES	NON-FIXED SEATING
B	*	6' BENCH SEATING	PREMIER EUROCASE	NON-FIXED SEATING
C	42	CHAIRS	TOWER ASSOCIATES	NON-FIXED SEATING
D	18	SQUARE TABLE	PREMIER EUROCASE	NON-FIXED WITH FALCON BASE
E	1	RECTANGLE TABLE	PREMIER EUROCASE	ADA COMPLIANT SEATING W/ FALCON BASE
F	*	SQUARE TABLE	PREMIER EUROCASE	42" TALL WITH FALCON BASE
G	*	EXTERIOR TABLE	EMU	32" SQUARE TABLE
H	*	EXTERIOR SEATING	AMERICAN TRADING	NON-FIXED SEATING

Q2008-PROTOTYPE

Quiznos

STORE # 11639

1880 Rees St.,
Suite A-101
Breaux Bridge, LA 70517

architect:

consultants:

revisions

submittals:

phase:

NOT FOR CONSTRUCTION

project no.
date
file

sheet title

EQUIPMENT PLAN SCHEDULES

sheet designation:

A1.1