


David,

This one works the best. I don't know about the soda counter but the basic layout appears to maximise the space around the columns.

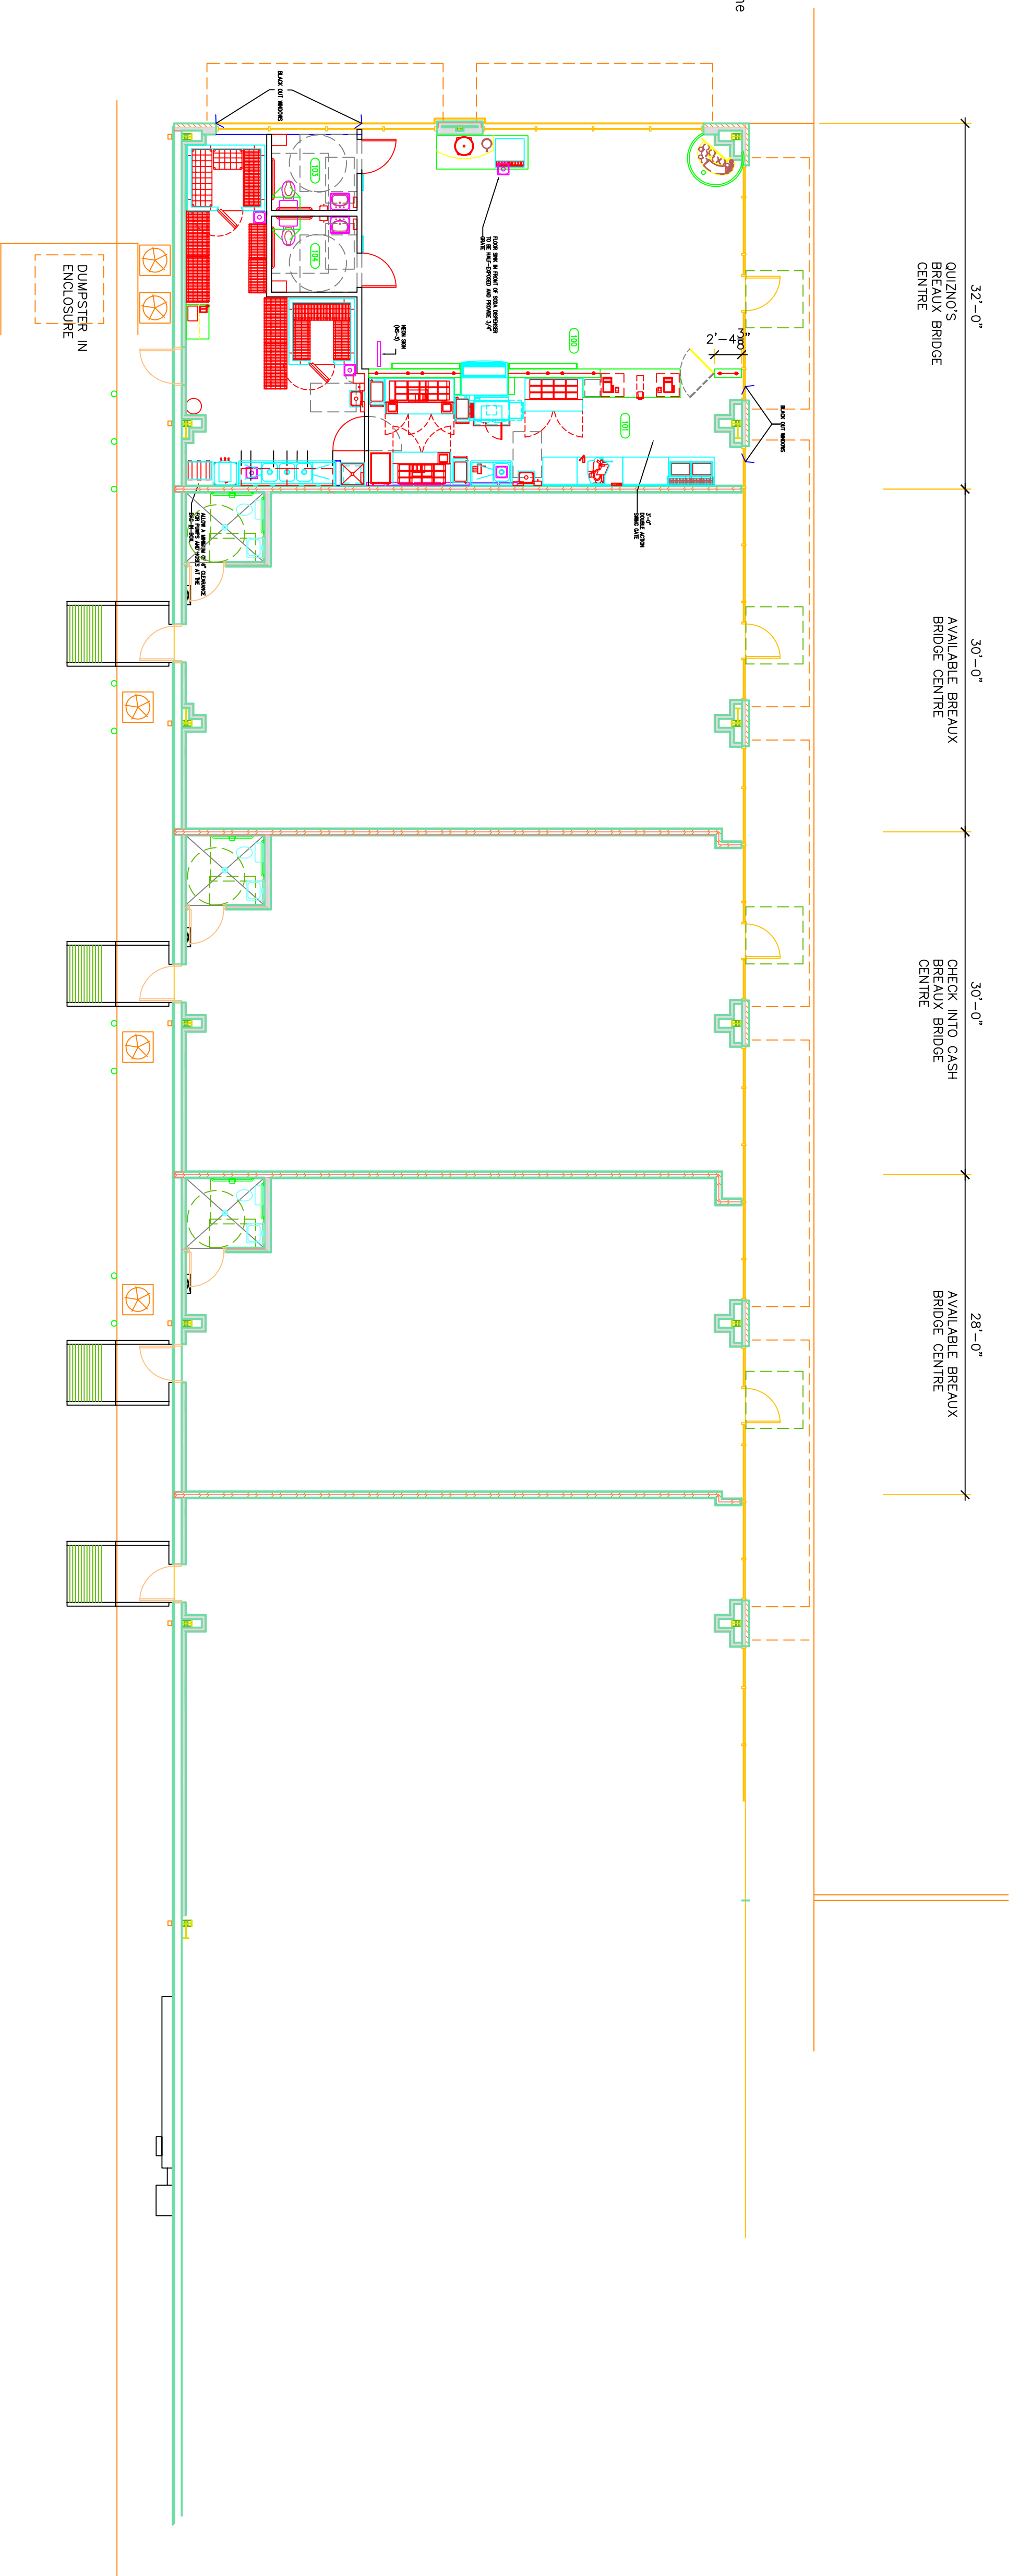

David,

This one has a smaller make table and smaller finish table. I follows the traditional store more but still has an issue with the soda counter.

