Store #12208
Approved with Changes
6-6-08
Richard Steighner

Show largest shelving units space will allow. 24" deep units are preferred.

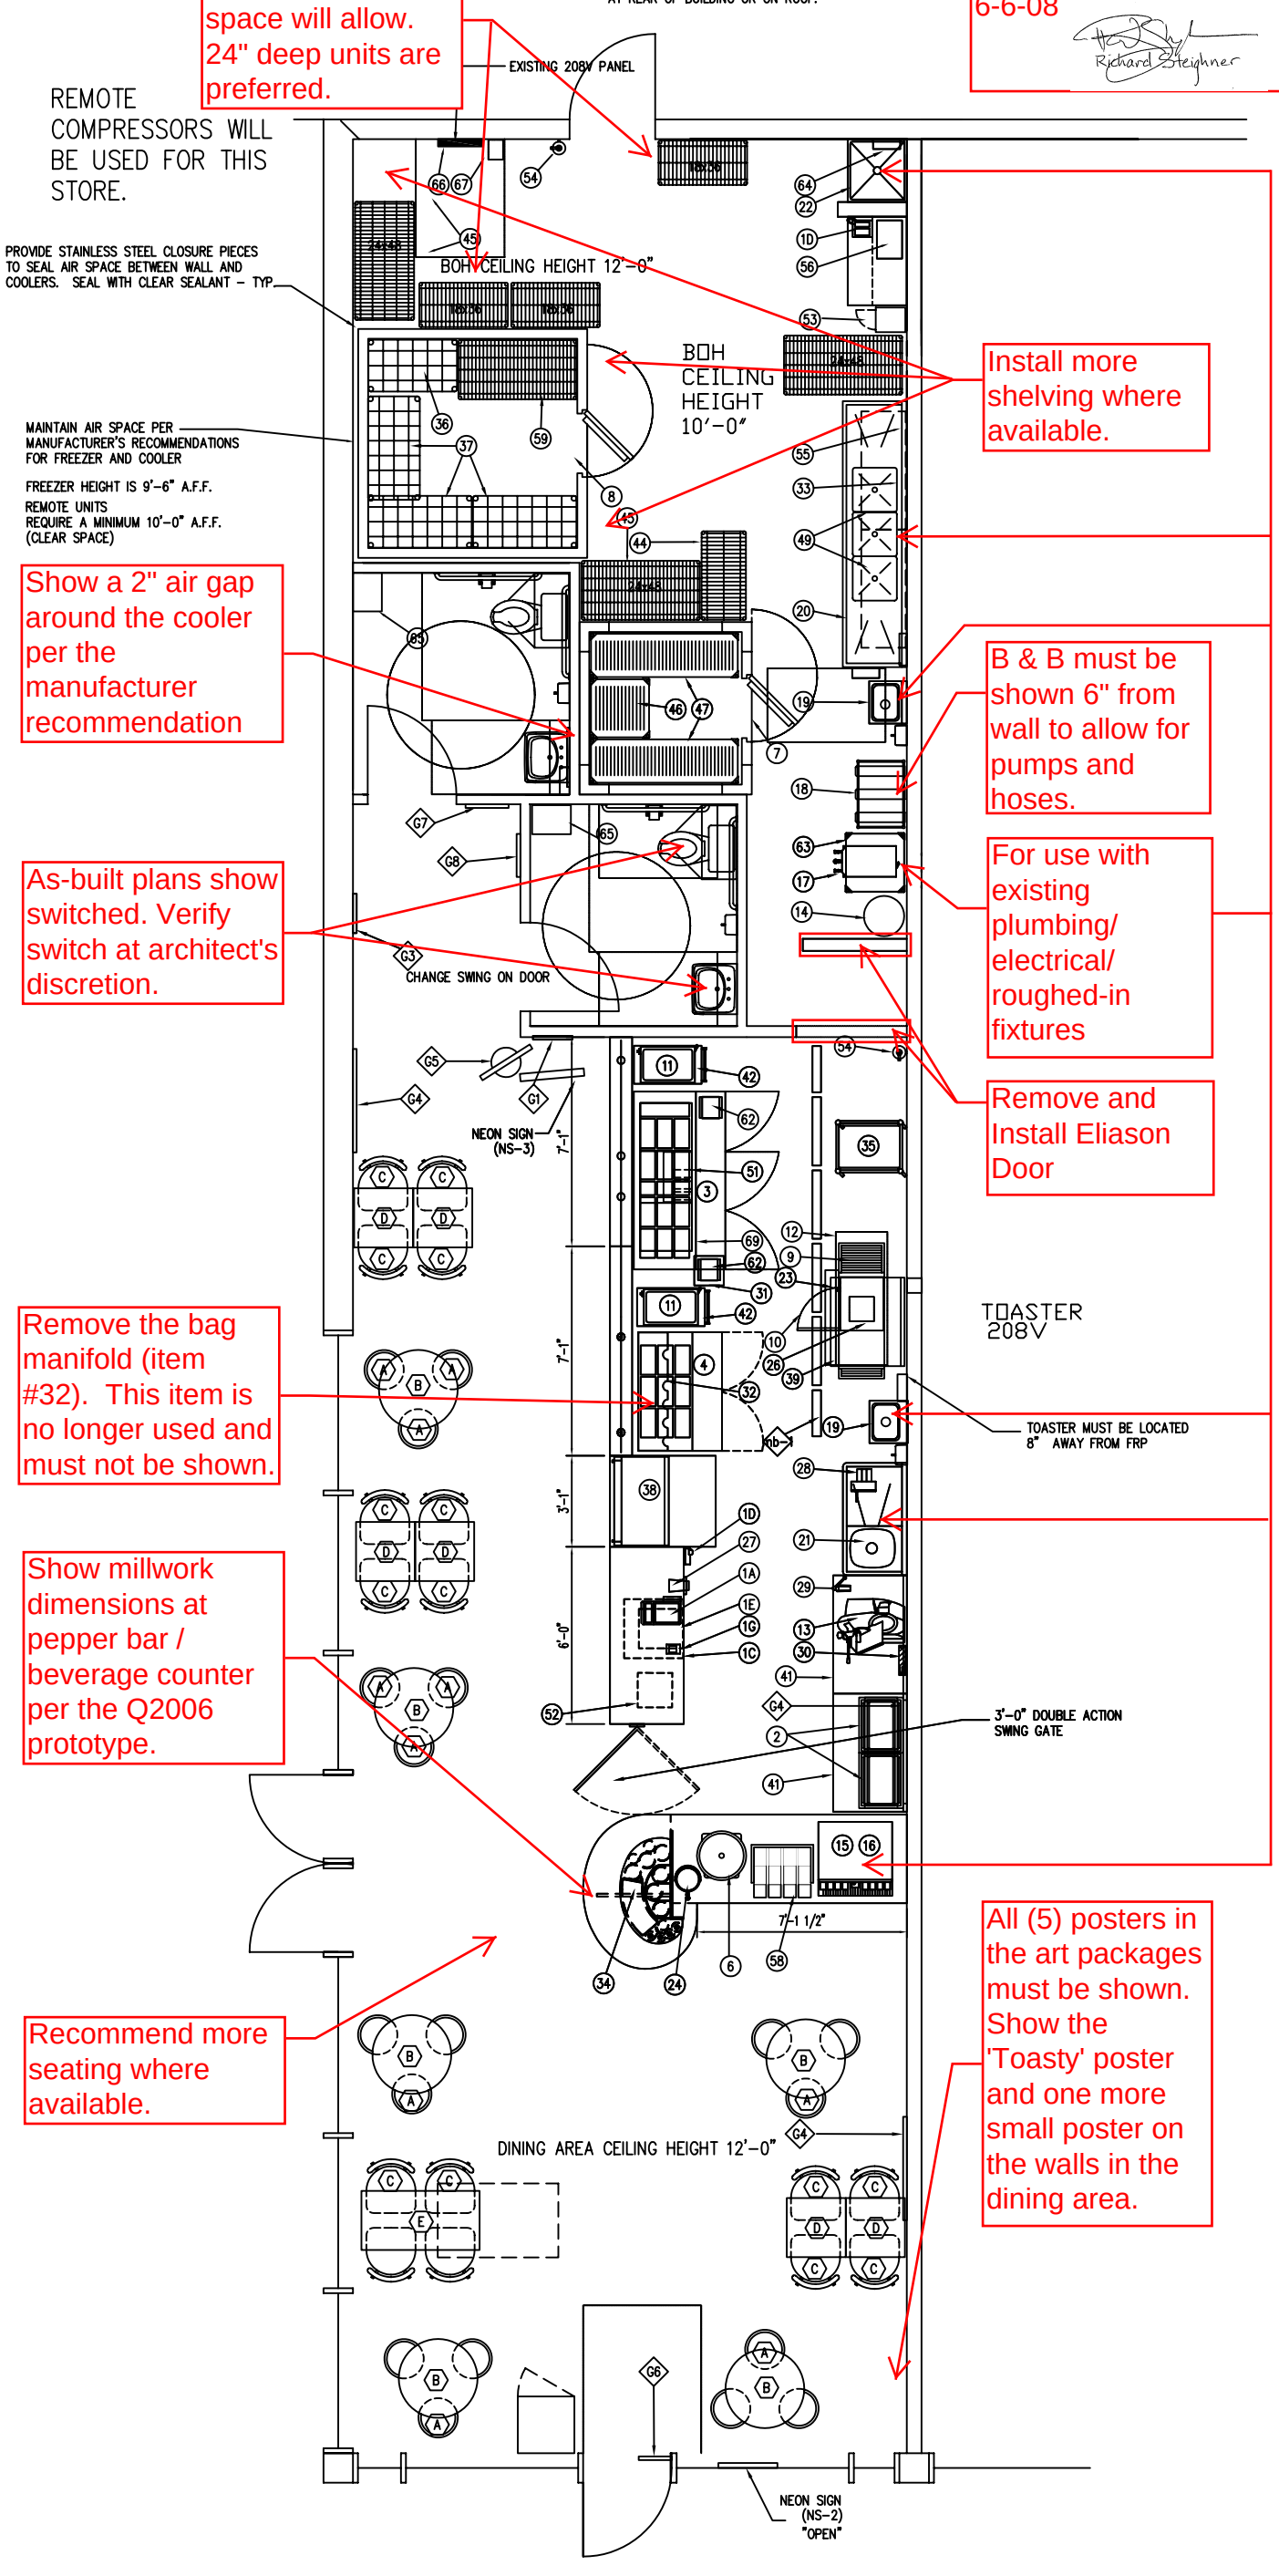

Install more shelving where available.

Show a 2" air gap around the cooler per the manufacturer recommendation

B & B must be shown 6" from wall to allow for pumps and hoses.

As-built plans show switched. Verify switch at architect's discretion.

For use with existing plumbing/ electrical/ roughed-in fixtures

Remove and Install Eliason Door

Remove the bag manifold (item #32). This item is no longer used and must not be shown.

Show millwork dimensions at pepper bar / beverage counter per the Q2006 prototype.

Recommend more seating where available.

All (5) posters in the art packages must be shown. Show the 'Toasty' poster and one more small poster on the walls in the dining area.

revised STORE

1600 S.F.

#12208 SCHEMATIC