

OPENING PROTECTION FROM WINDBORNE DEBRIS FASTENING SCHEDULE FOR WOOD STRUCTURAL PANELS			
FASTENER TYPE	FASTENER SPACING		
	PANEL SPAN ≤ 4 FOOT	4 FOOT PANEL SPAN ≤ 6 FOOT	6 FOOT PANEL SPAN ≤ 8 FOOT
2-1/2" #6 WOOD SCREWS	16"	12"	9"
2-1/2" #8 WOOD SCREWS	16"	16"	12"

WINDOWS IN BUILDINGS LOCATED IN WIND BORNE DEBRIS REGIONS SHALL HAVE GLAZED OPENINGS PROTECTED FROM WINDBORNE DEBRIS. WOOD STRUCTURAL PANELS WITH A MIN. THICKNESS OF 7/16" AND A MAX. SPAN OF 8 FEET SHALL BE PERMITTED FOR OPENING PROTECTION IN ONE AND TWO STORY BUILDINGS. PANELS SHALL BE PRECUT TO COVER THE GLAZED OPENINGS WITH ATTACHMENT HARDWARE PROVIDED.

NOTE:
INSTALL ALL COMPONENTS AND CLADDING IN
ACCORDANCE WITH SCHEDULES AND NOTES ON
SHT. A-7

3-TAB ASPHALT SHINGLES TO
MATCH EXISTING STRUCTURE.
COORDINATE WITH OWNER.

CREMATOR HOT AIR DUCT
STACK THRU ROOF AS
REQ'D BY MFR.

RIDGE VENT TO MATCH
SHINGLES

FLASHING

2x WOOD SUBFASCIA
W/ VINYL WRAPPED FINISH FASCIA
VERIFY COLOR WITH OWNER (TYP)

VENTED VINYL
BEAD-BOARD
SOFFIT. (TYP)

VINYL SIDING OVER TYVEK VAPOR
BARRIER AND 1/2" DENSGLASS
SHEATHING. COORDINATE COLOR
AND STYLE WITH OWNER (TYP)

12'
CLG. HEIGHT

10'-10"
EAVE HEIGHT

SOUTH ELEVATION

SCALE: 3/8" = 1'-0"

3-TAB ASPHALT SHINGLES TO
MATCH EXISTING STRUCTURE.
COORDINATE WITH OWNER.

CREMATOR HOT AIR DUCT
STACK THRU ROOF AS
REQ'D BY MFR.

RIDGE VENT TO MATCH
SHINGLES

PREP ROOM
VENTILATION THROUGH
ROOF. SEE MECH

PREP ROOM
VENTILATION THROUGH
ROOF. SEE MECH

VINYL SIDING OVER TYVEK VAPOR
BARRIER AND 1/2" DENSGLASS
SHEATHING. COORDINATE COLOR
AND STYLE WITH OWNER (TYP)

2x WOOD SUBFASCIA
W/ VINYL WRAPPED FINISH FASCIA
VERIFY COLOR WITH OWNER (TYP)

VENTED VINYL
BEAD-BOARD
SOFFIT. (TYP)


11'-10"
EAVE HEIGHT

12'
CLG. HEIGHT

NORTH ELEVATION

SCALE: 3/8" = 1'-0"

371441
REVIEWED FOR
STATE FIRE MARSHAL
AS PER REVIEW LETTER
BY WILLIAM D. JONES, ARCHITECT, CBO
William D. Jones

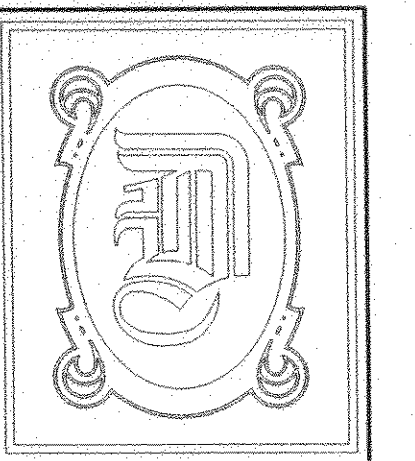

**DAMMON
ENGINEERING, INC.**

CHIEF ENGINEER
EMMETT
DAMMON, P.E.

CHIEF ARCHITECT
ROBERT
WILTSE

1095 FLORIDA AVENUE
SLIDELL, LA. 70458
OFFICE: 985-649-5832
FAX: 985-641-5950

WEBSITE:
WWW.DAMMONENGINEERING.COM

EMAIL:
DAMMONENG@BELLSOUTH.NET

ARCHITECTURE

ENGINEERING

STUDIES

PLANNING


INVESTIGATION

EXPERT WITNESS

**NEW
CREMATORY
AND EMBALMING
FACILITY**

HONAKER FUNERAL
HOME
TERRY TRANCHINA
1751 W. GAUSE BLVD.
SLIDELL, LA

**EXTERIOR
ELEVATIONS**

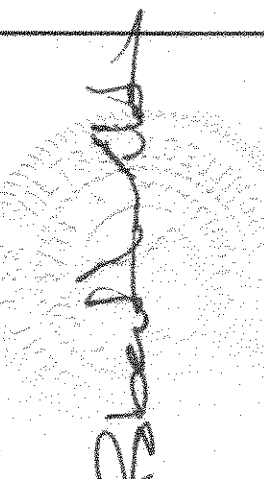

REV: 12-04-09

SCALE: AS NOTED

JOB#: 1999

DATE: 6-9-09

SHEET 11

A-5

OF 19