

**DAMMON**  
ENGINEERING, INC.

CHIEF ENGINEER  
EMMETT  
DAMMON, P.E.

CHIEF ARCHITECT  
ROBERT  
WILTSE

1095 FLORIDA AVENUE  
SLIDELL, LA. 70458  
OFFICE: 985-649-5832  
FAX: 985-641-5950

WEBSITE:  
WWW.DAMMONENGINEERING.COM


EMAIL:  
DAMMONENG@BELLSOUTH.NET

- ARCHITECTURE
- ENGINEERING
- STUDIES
- PLANNING
- INVESTIGATION
- EXPERT WITNESS

**NEW**  
**CREMATORY**  
**AND EMBALMING**  
**FACILITY**

HONAKER FUNERAL  
HOME  
TERRY TRANCHINA  
1751 W. GAUSE BLVD.  
SLIDELL, LA

**EXTERIOR**  
**ELEVATIONS**

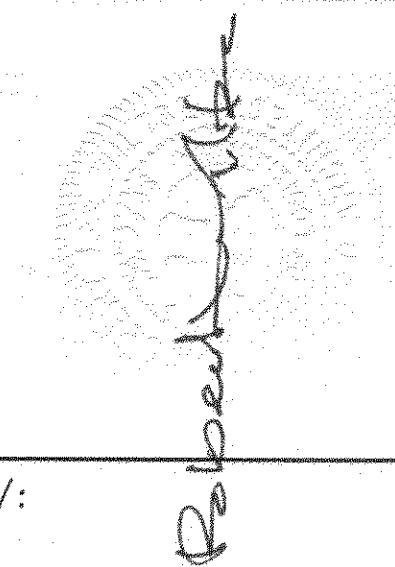

REV:

SCALE: AS NOTED


JOB#: 1999

DATE: 6-9-09


SHEET 11

**A-5**

OF 19

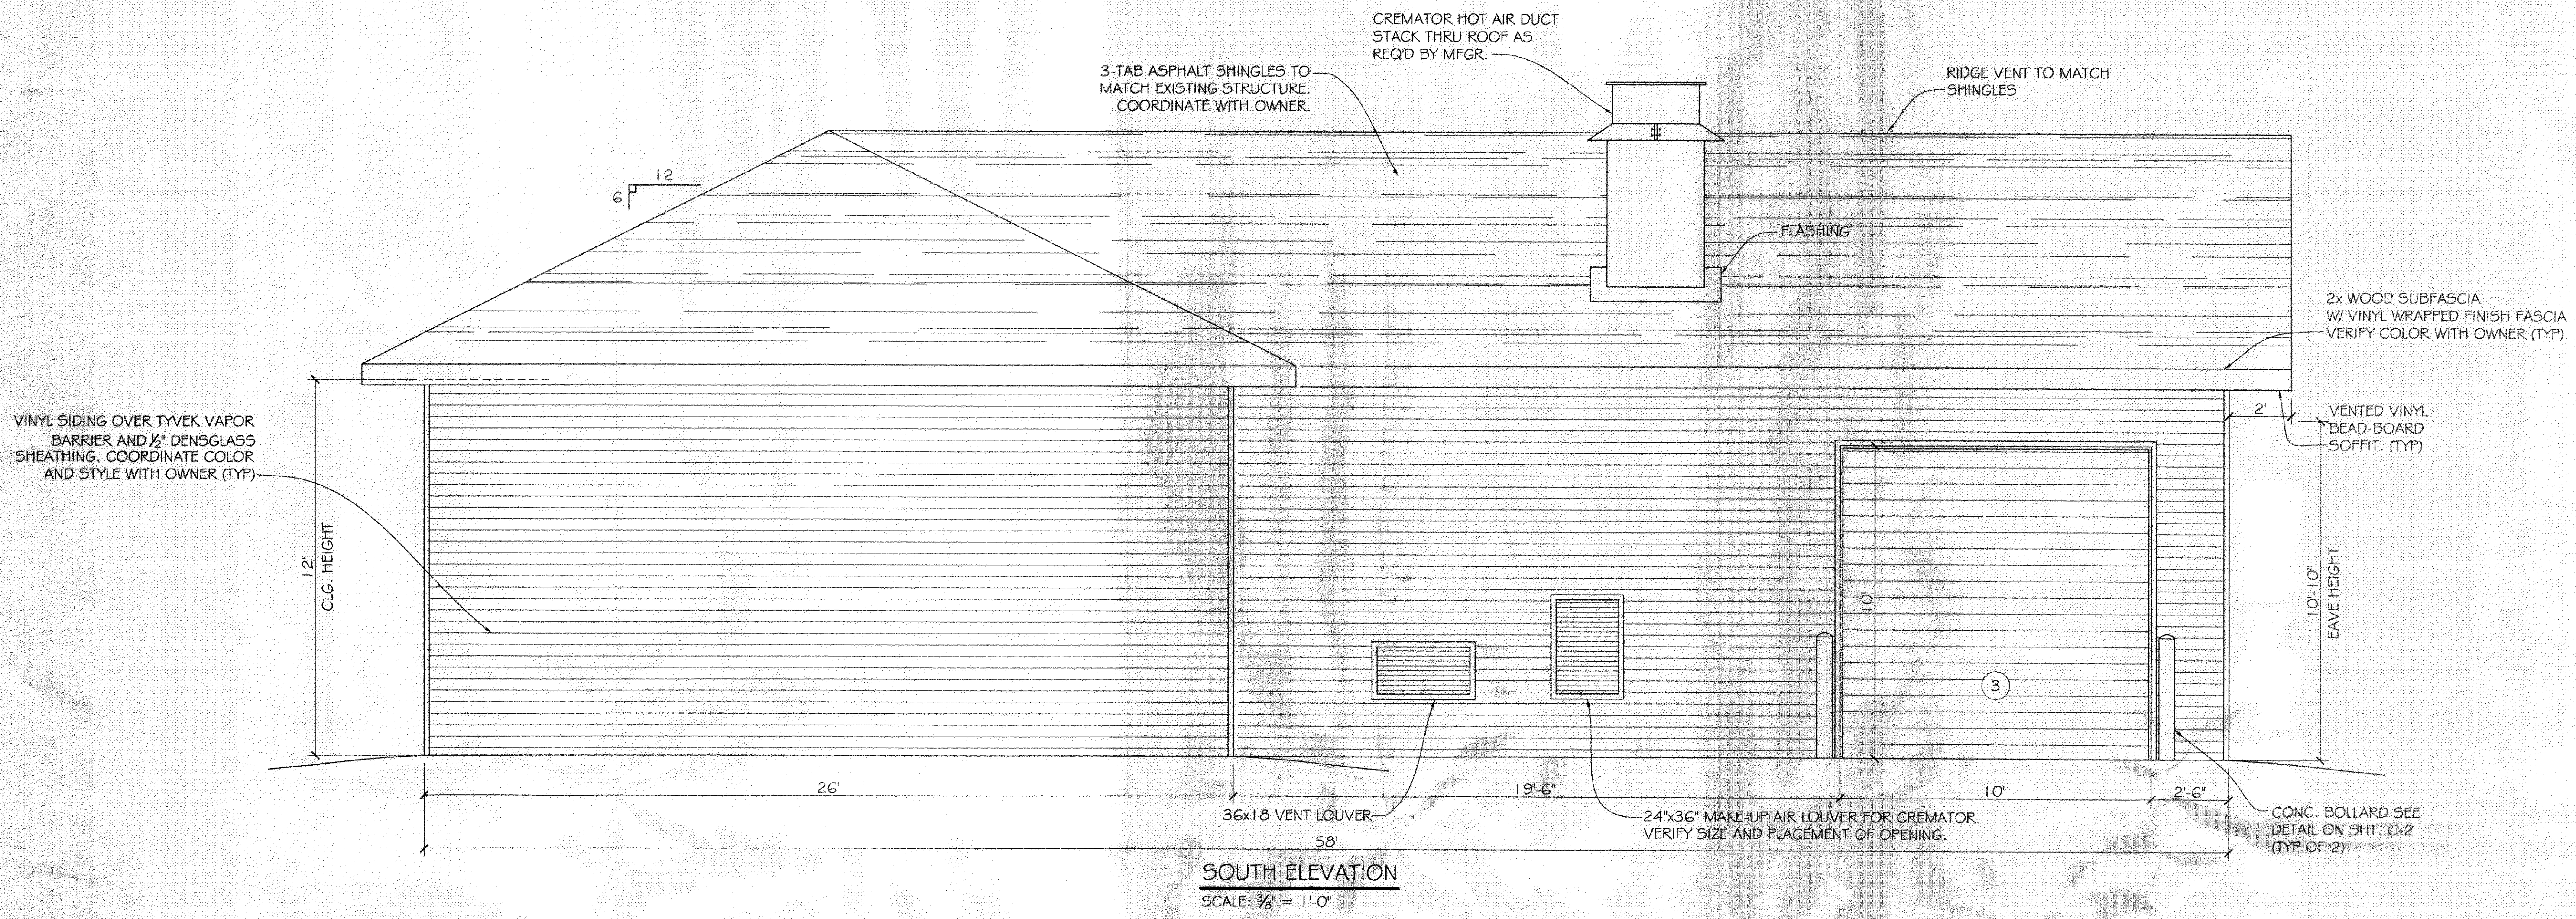

**SOUTH ELEVATION**  
SCALE: 3/8" = 1'-0"

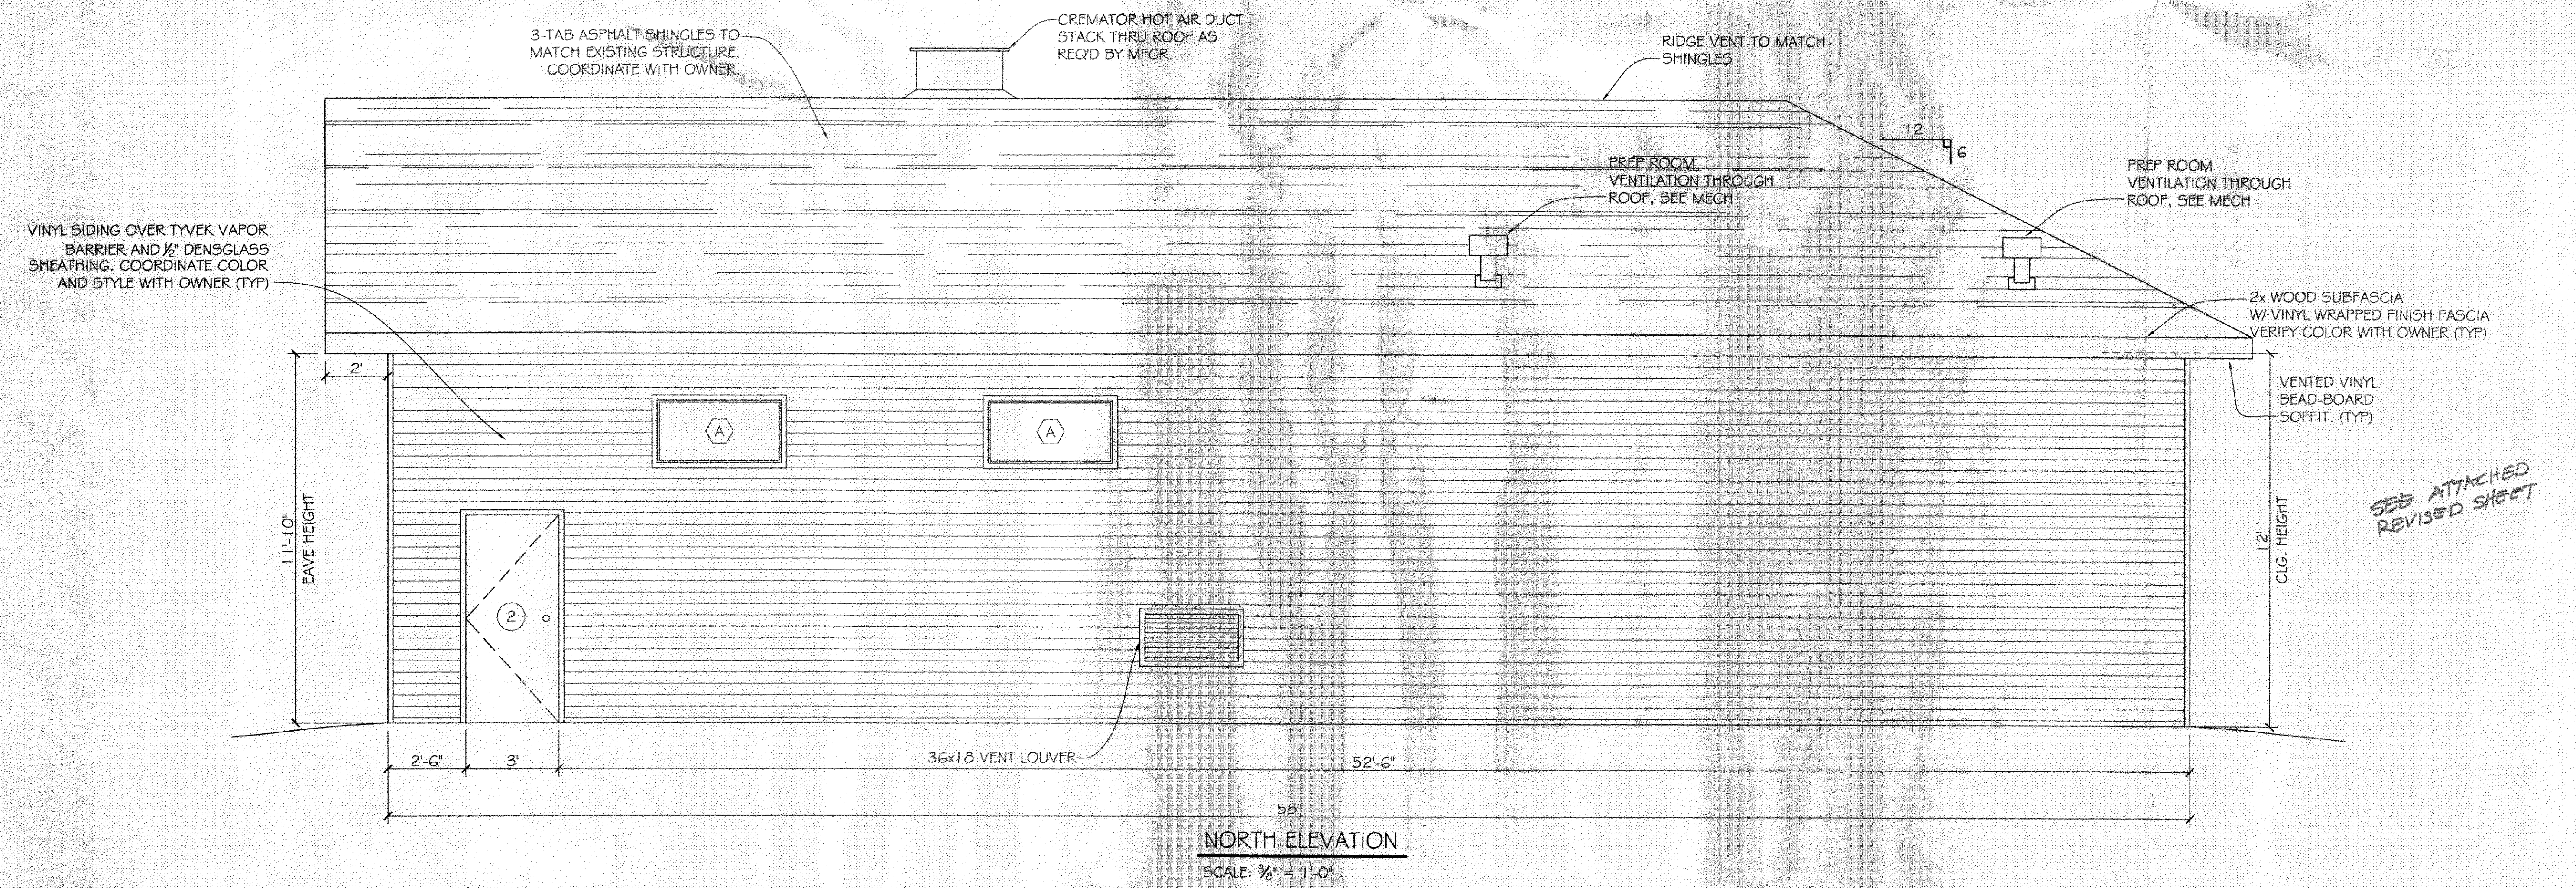

**NORTH ELEVATION**  
SCALE: 3/8" = 1'-0"

SEE ATTACHED  
REVISED SHEET