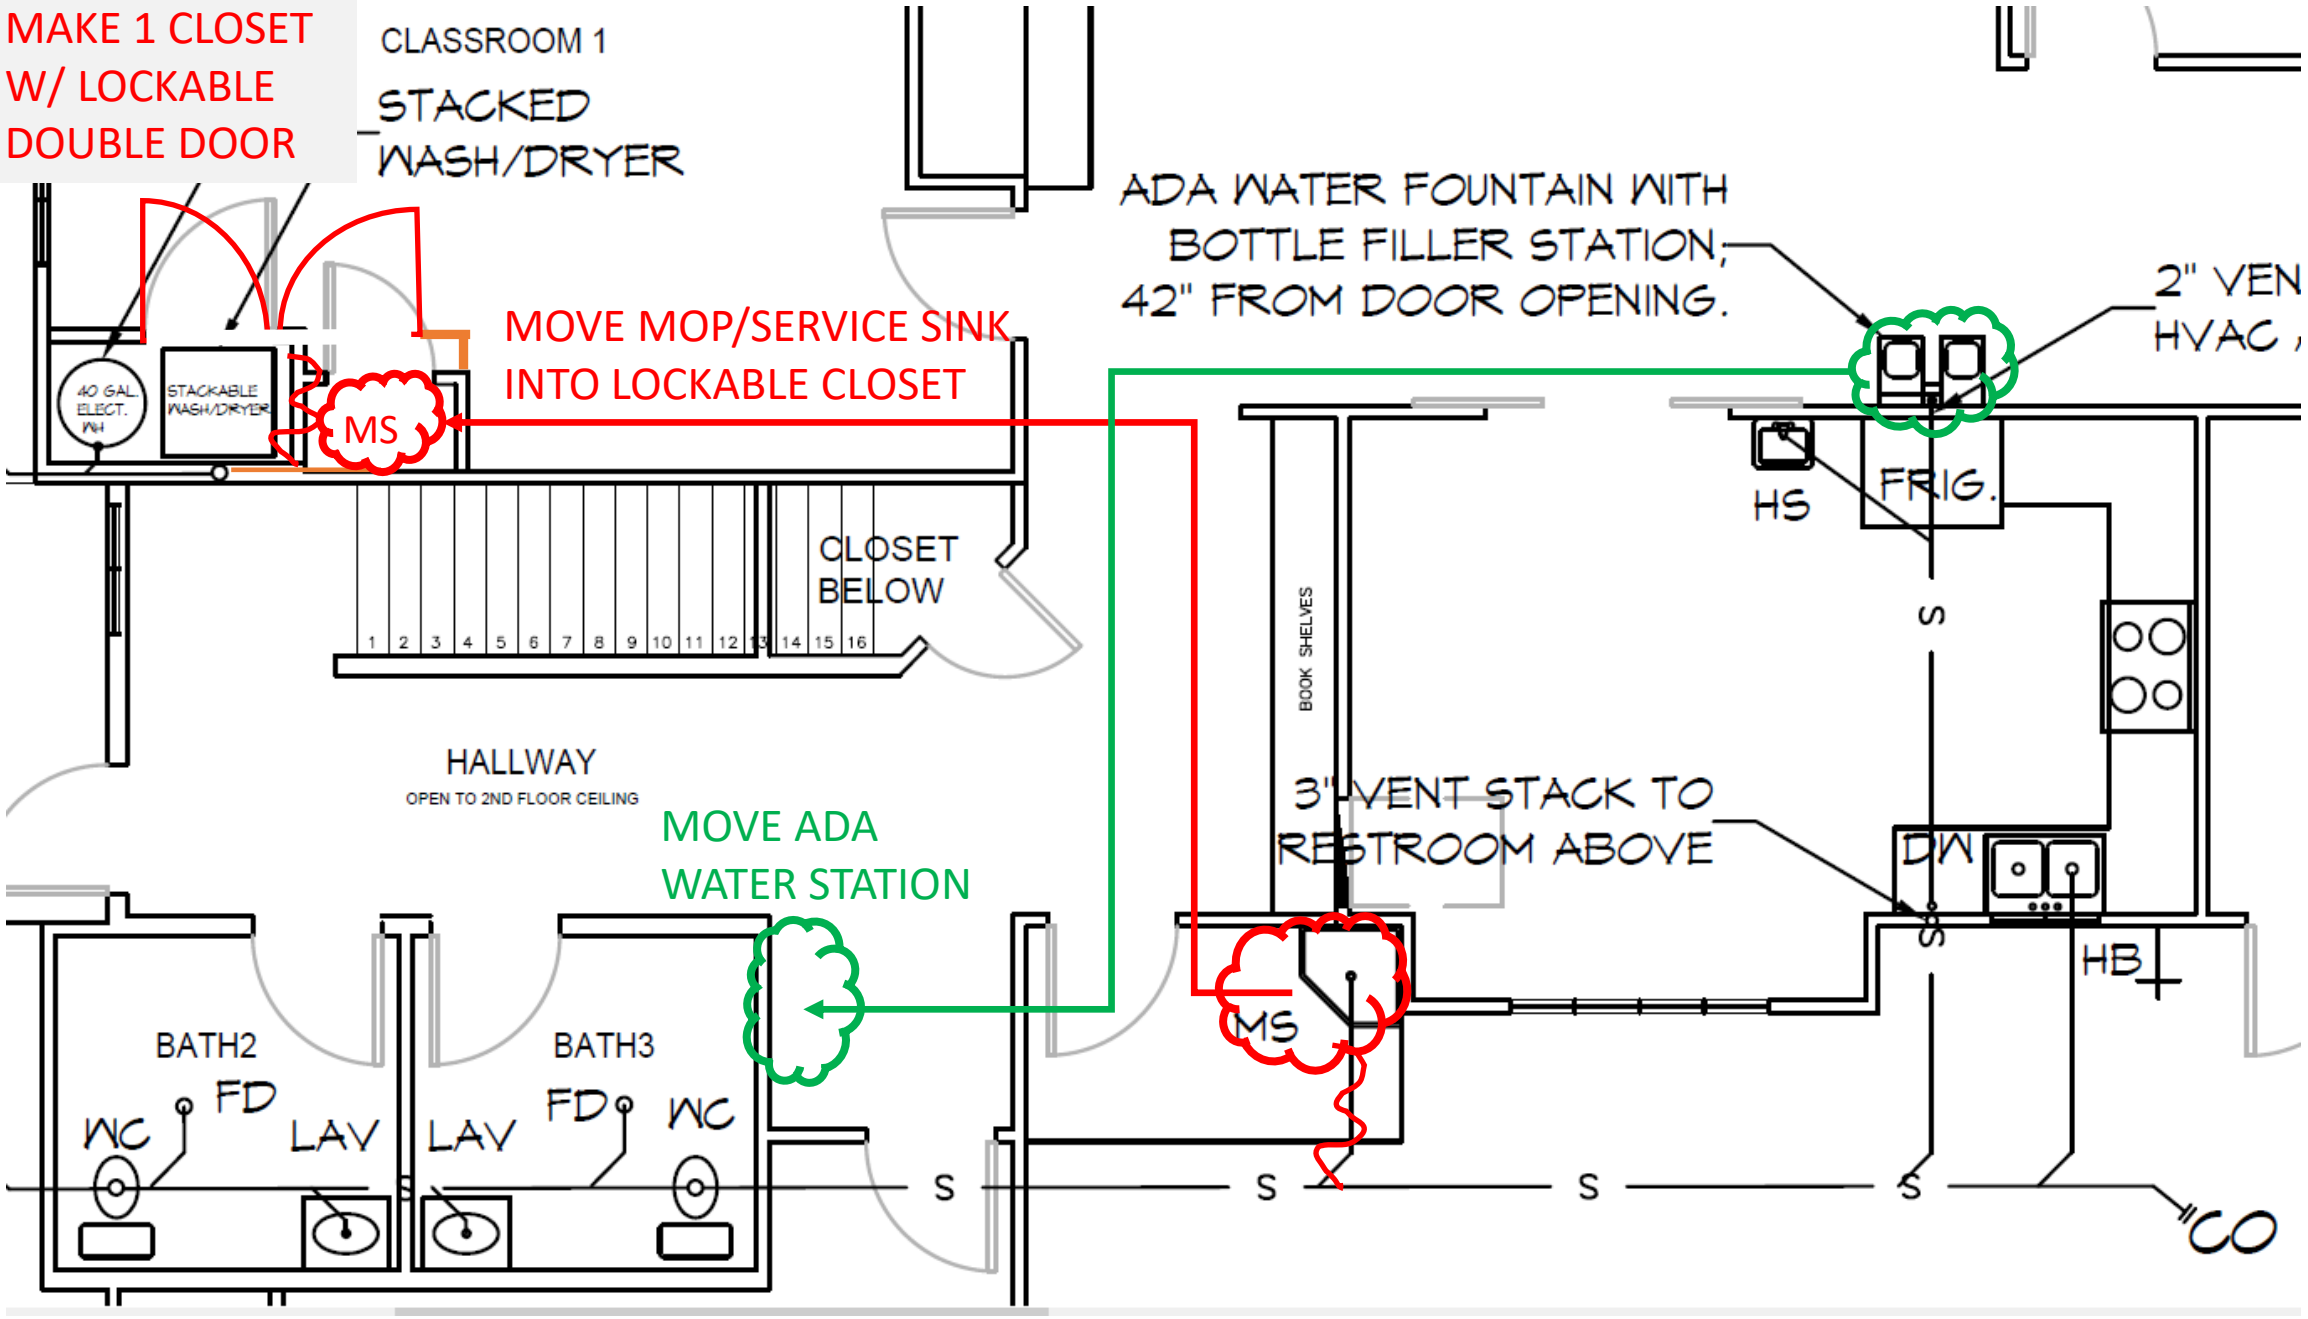
MAKE 1 CLOSET W/ LOCKABLE DOUBLE DOOR
CLASSROOM 1
STACKED WASH/DRYER
40 GAL. ELECT. WH
STACKABLE WASH/DRYER
MS
MOVE MOP/SERVICE SINK INTO LOCKABLE CLOSET
ADA WATER FOUNTAIN WITH BOTTLE FILLER STATION, 42" FROM DOOR OPENING.
2" VEN
HVAC
HS
FRIG.
CLOSET BELOW
1 2 3 4 5 6 7 8 9 10 11 12 13 14 15 16
BOOK SHELVES
HALLWAY
OPEN TO 2ND FLOOR CEILING
MOVE ADA WATER STATION
3" VENT STACK TO RESTROOM ABOVE
DW
HB
MS
BATH2
FD
WC
LAV
BATH3
LAV
FD
WC
S
CO