


C:\SDSK\PROJ\9602\01 Wed Feb 26 12:02:46 1997

ROOF PLAN - SHOWING DEMOLITION WORK, KEY TO ELEVATIONS & ROOF SECTION CUTS

D-1 1" = 20'-0"

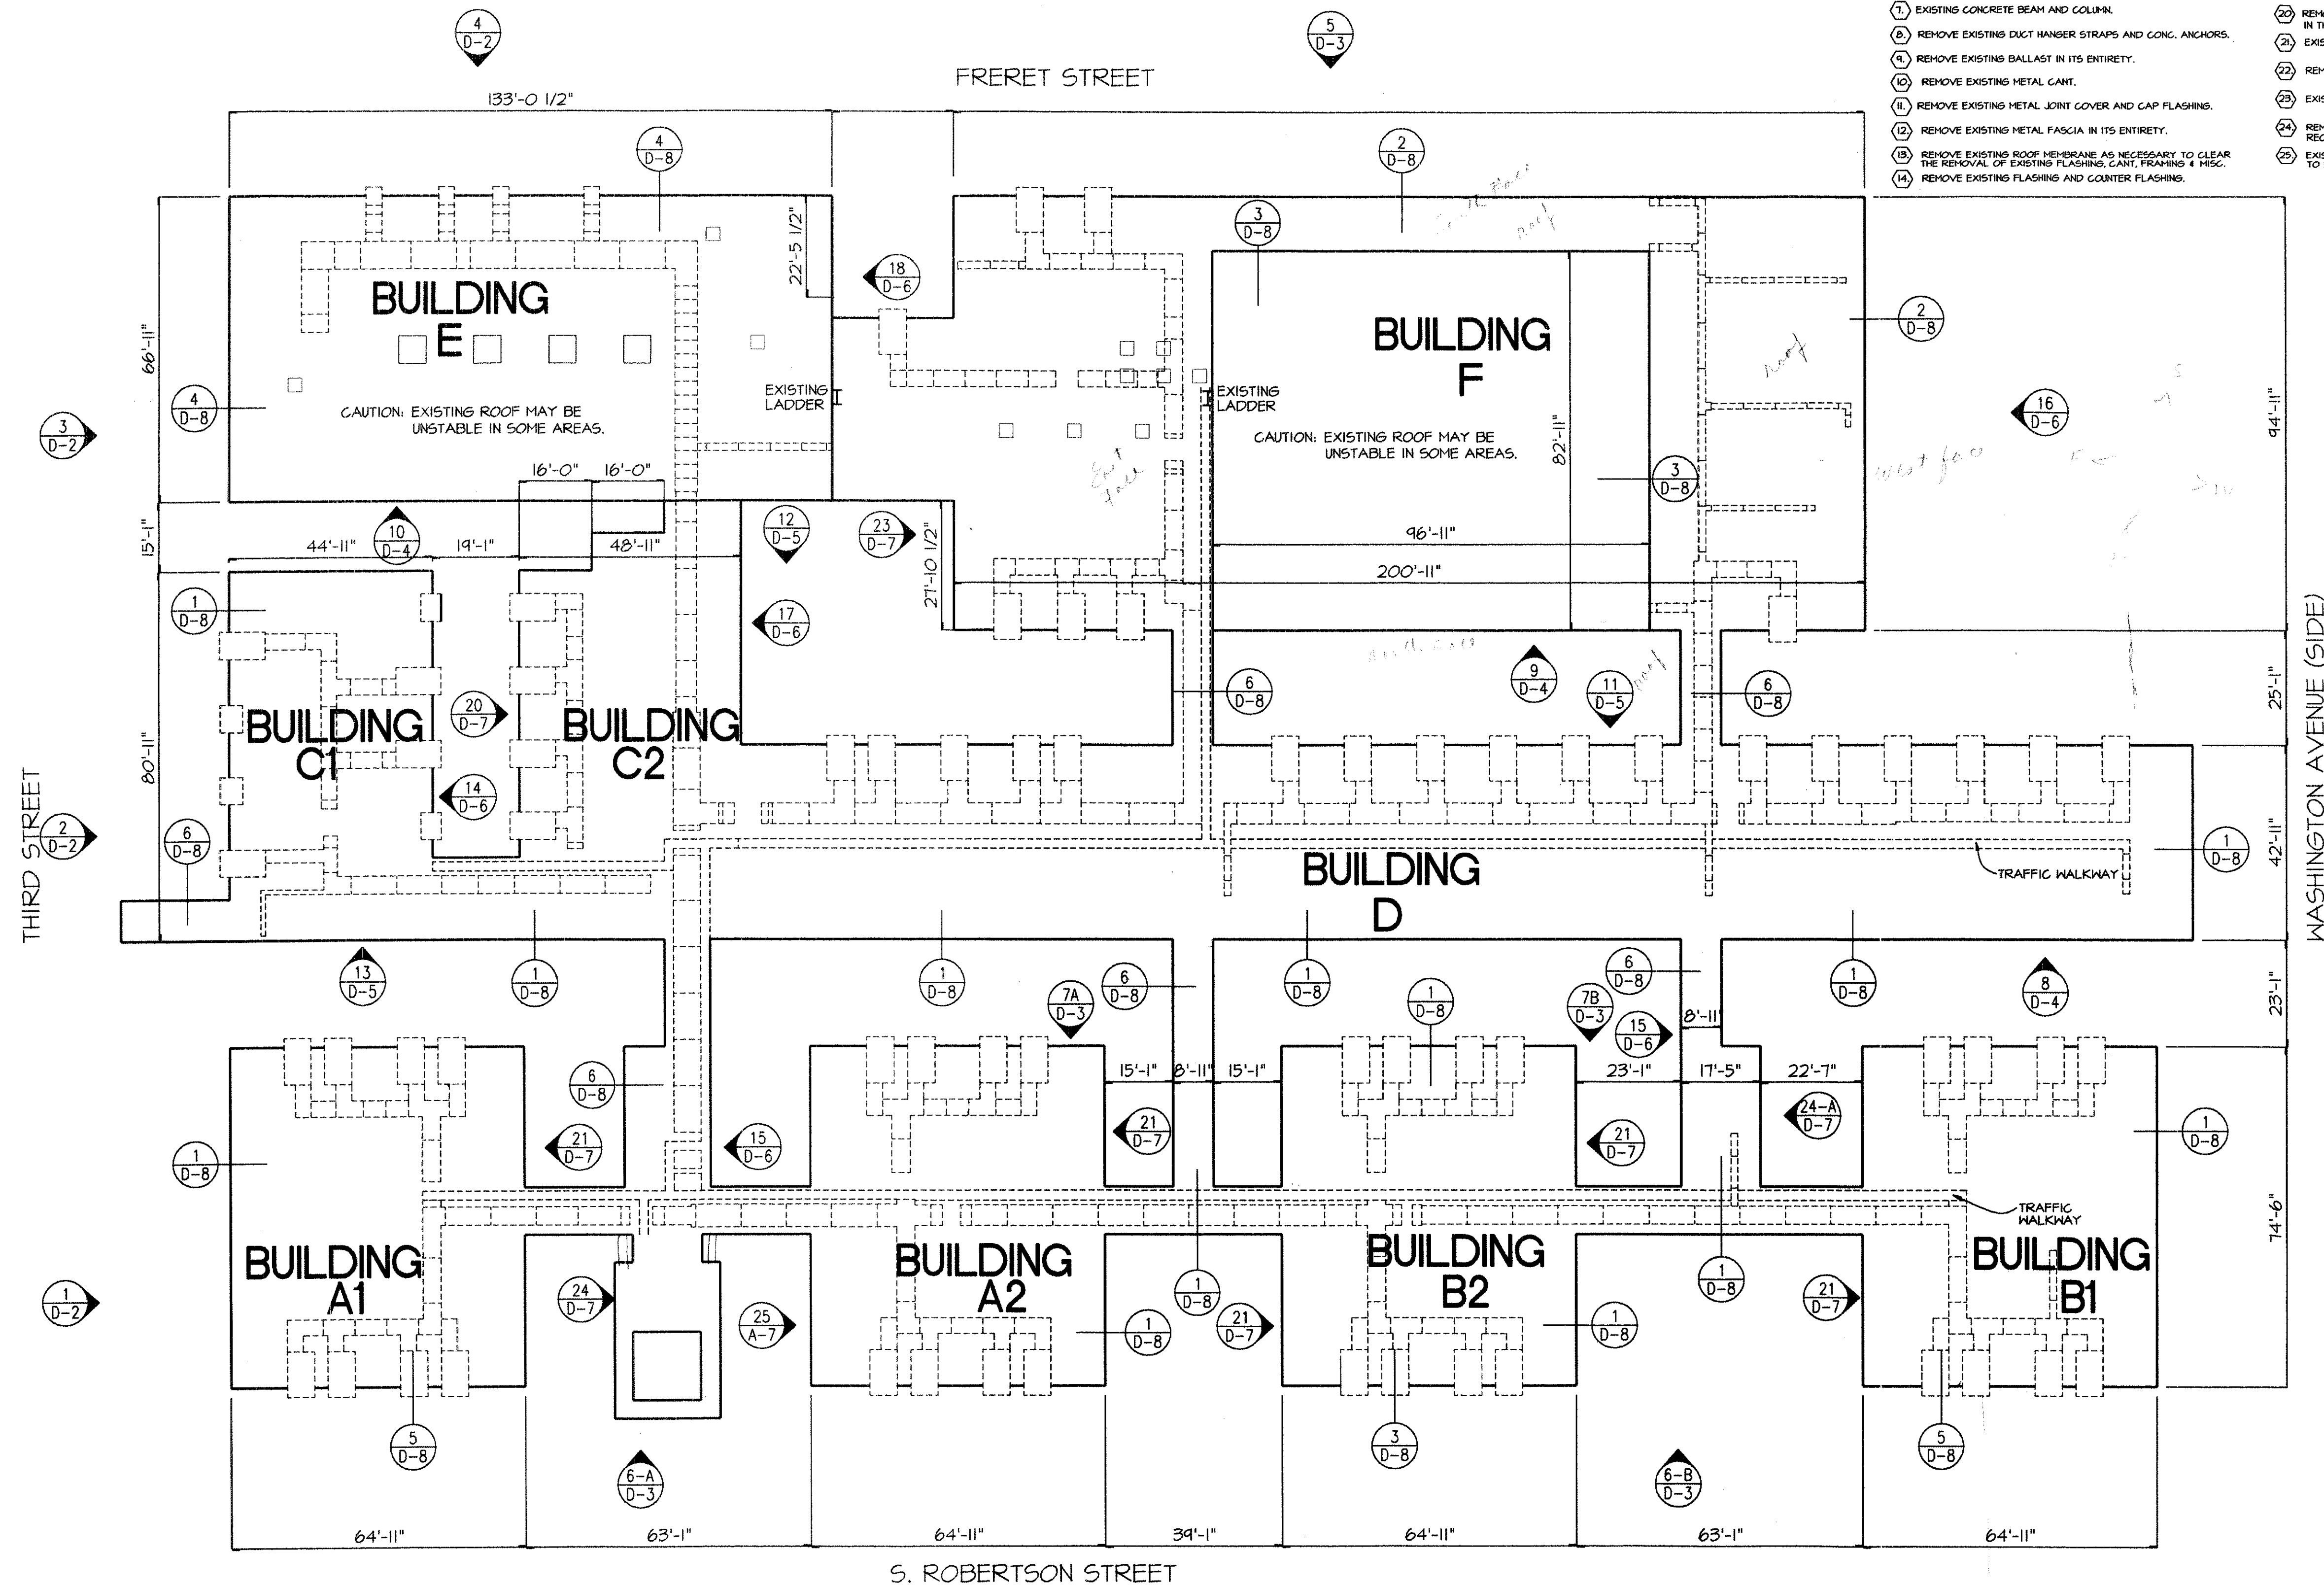

DEMOLITION NOTATION LEGEND

- 1 REMOVE EXISTING METAL DUCT CHASES, STRAP COVER, FRAMING AND MISC. MATERIAL CONNECTING DUCT CHASE TO EXISTING TO REMAIN IN THEIR ENTIRETY.
- 2 PATCH OR REPLACE BRICK, CONCRETE SLAB, COLUMN AND WALL-CANEL SYSTEM REQUIRED TO MATCH EXISTING.
- 3 EXISTING TO REMAIN.
- 4 EXISTING HALL PANEL SYSTEM TO REMAIN.
- 5 REMOVE EXISTING SUPPORT CHANNEL.
- 6 REMOVE EXISTING FILLER PIECE NEXT TO DUCT AND BEAM.
- 7 EXISTING CONCRETE BEAM AND COLUMN.
- 8 REMOVE EXISTING DUCT HANGER STRAPS AND CONC. ANCHORS.
- 9 REMOVE EXISTING BALLAST IN ITS ENTIRETY.
- 10 REMOVE EXISTING METAL CANT.
- 11 REMOVE EXISTING METAL JOINT COVER AND CAP FLASHING.
- 12 REMOVE EXISTING METAL FASCIA IN ITS ENTIRETY.
- 13 REMOVE EXISTING ROOF MEHRANE AS NECESSARY TO CLEAR THE REMOVAL OF EXISTING FLASHING, CANT, FRAMING & MISC.
- 14 REMOVE EXISTING FLASHING AND GOUNTER FLASHING.
- 15 CUT OUT AND REMOVE EXISTING MEHRANE ROOFING SYSTEM & INSULATION ONLY AT NEW METAL ROOF SYSTEM FRAMING SUPPORTS, ANCHORS & FASTENER LOCATIONS WHEN CONNECTION TO EXISTING DECKING/ SUBSTRATE & DEMOLITION AREAS WHEN NECESSARY.
- 16 VERIFY THE CONDITION OF EXISTING HOOD BLOCKING. REMOVE IF DAMAGED DURING DEMOLITION OR ROTTEN. REPLACE WITH NEW TO MATCH EXISTING.
- 17 EXISTING HOOD DECKING TO REMAIN.
- 18 REMOVE EXISTING DUCTS IN THEIR ENTIRETY.
- 19 EXISTING ALUM. FRAME CLEARSTORY TO REMAIN. REPLACE TO MATCH EXISTING IF DAMAGE DURING DEMOLITION.
- 20 REMOVE EXISTING AIR HANDLER, DUCT WORK, EQUIPMENT SUPPORT IN THEIR ENTIRETY.
- 21 EXISTING FACE OF BUILDING.
- 22 REMOVE EXISTING HOOD FRAMING & SHEATHING IN ITS ENTIRETY.
- 23 EXISTING CONCRETE DECK TO REMAIN.
- 24 REMOVE EXISTING ROOF INSULATION IN ITS ENTIRETY @ ROOF AREAS TO RECEIVE MODIFIED BITUMENOUS ROOFING SYSTEM.
- 25 EXISTING STRUCTURAL INSULATION TO REMAIN. REPAIR OR REPLACE TO MATCH EXISTING IF DAMAGED DURING DEMOLITION.

NOTES:

1. ROOF EQUIPMENT CURBS NOT BEING USED SHALL BE CUT FLUSH W/ EXISTING DECK @ FLAT ROOF AREAS.
2. EXISTING TRAFFIC WALKWAY PADS SHALL BE GATHERED AND STORED FOR REUSE.
3. SEE MECHANICAL DRAWING FOR ADDITIONAL INFORMATION.

SHOW NORTH ARROW

BYRON J. STEWART & ASSOC.
ARCHITECTS & PLANNERS
2800 MARENGO ST.
NEW ORLEANS, LA 70115
(504) 877-5537

NEW ORLEANS PARISH
SCHOOL BOARD
4800 ALMONASTER AVE
NEW ORLEANS, LA

PROJECT
CARTER G. WOODSON JUN. HIGH SCHOOL
RE-ROOFING
F.D.P. # 92034

JOB NUMBER:	9602
DATE:	4-21-97
DRAWN BY:	M.A.
CHECKED BY:	B.J.S.

REVISIONS		
NO.	DATE	REVISION

SHEET
D-1
OF SHEETS