DEMOLITION NOTATION LEGEND

CONSTRUCTION NOTE

1. REMOVE EXISTING METAL DUCT CHASES, STRAP COVER, FRAMING AND MISC. MATERIAL CONNECTING DUCT CHASE TO EXISTING TO REMAIN ~~IN THEIR ENTIRETY~~.
2. PATCH OR REPLACE BRICK, CONCRETE SLAB, COLUMN AND WALL PANEL SYSTEM REQUIRED TO MATCH EXISTING.
3. EXISTING TO REMAIN.
4. EXISTING WALL PANEL SYSTEM TO REMAIN.
5. REMOVE EXISTING SUPPORT CHANNEL.
6. REMOVE EXISTING FILLER PIECE NEXT TO DUCT AND BEAM.
7. EXISTING CONCRETE BEAM AND COLUMN.
8. REMOVE EXISTING DUCT HANGER STRAPS AND CONC. ANCHORS.
9. REMOVE EXISTING BALLAST IN ITS ENTIRETY.
10. REMOVE EXISTING METAL CANT.
11. REMOVE EXISTING METAL JOINT COVER AND CAP FLASHING.
12. REMOVE EXISTING METAL FASCIA IN ITS ENTIRETY.
13. REMOVE EXISTING ROOF MEMBRANE AS NECESSARY TO CLEAR THE REMOVAL OF EXISTING FLASHING, CANT, FRAMING & MISC.
14. REMOVE EXISTING FLASHING AND COUNTER FLASHING.
15. CUT OUT AND REMOVE EXISTING MEMBRANE ROOFING SYSTEM & INSULATION ONLY AT NEW METAL ROOF SYSTEM FRAMING SUPPORTS, ANCHORS & FASTENER LOCATIONS WHEN CONNECTION TO EXISTING DECKING/ SUBSTRATE & DEMOLITION AREAS WHEN NECESSARY.
16. VERIFY THE CONDITION OF EXISTING WOOD BLOCKING. REMOVE IF DAMAGED DURING DEMOLITION OR ROTTEN. REPLACE WITH NEW TO MATCH EXISTING.
17. EXISTING WOOD DECKING TO REMAIN.
18. REMOVE EXISTING DUCTS IN THEIR ENTIRETY.
19. EXISTING ALUM. FRAME CLEARSTORY TO REMAIN. REPLACE TO MATCH EXISTING IF DAMAGE DURING DEMOLITION.
20. REMOVE EXISTING AIR HANDLER, DUCT WORK, EQUIPMENT SUPPORT IN THEIR ENTIRETY.
21. EXISTING FACE OF BUILDING.
22. REMOVE EXISTING WOOD FRAMING & SHEATHING IN ~~IT~~ ITS ENTIRETY.
23. EXISTING CONCRETE DECK TO REMAIN.
24. REMOVE EXISTING ROOF INSULATION IN ~~IT~~ ITS ENTIRETY @ ROOF AREAS TO RECEIVE MODIFIED BITUMIONOUS ROOFING SYSTEM.
25. EXISTING STRUCTURAL INSULATION TO REMAIN. REPAIR OR REPLACE TO MATCH EXISTING IF DAMAGED DURING DEMOLITION.

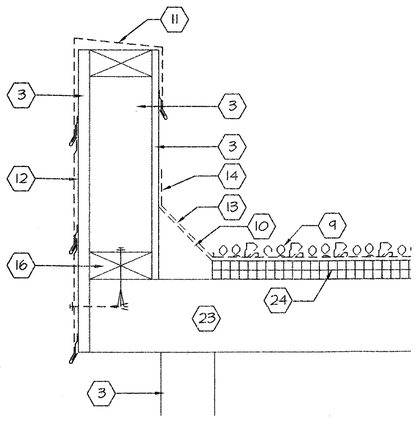

6 ROOF DETAIL
D-8 3"=1'-0" (TYP. @ COVERED WALKWAYS)

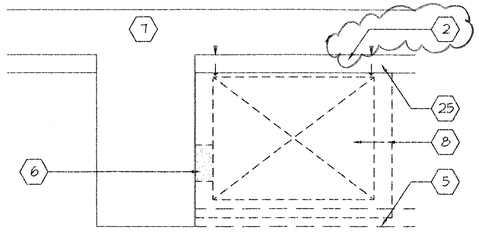

7 EXISTING DUCT & FURRING DETAIL
D-8 1 1/2"=1'-0" (TYPICAL AGAINST BEAM)

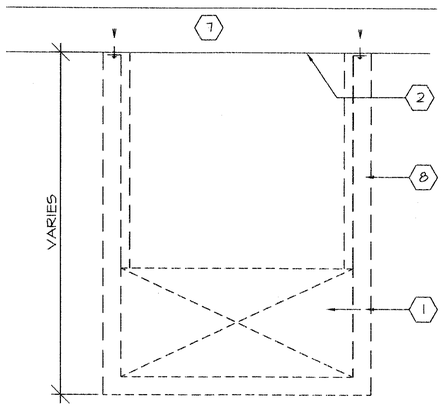

8 EXISTING EXPOSED DUCT JOINT COVERS (TYPICAL FREE HANGING)
D-8 1 1/2"=1'-0"

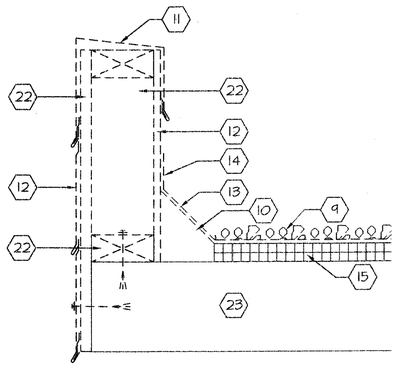

1 ROOF DETAIL
D-8 3"=1'-0"

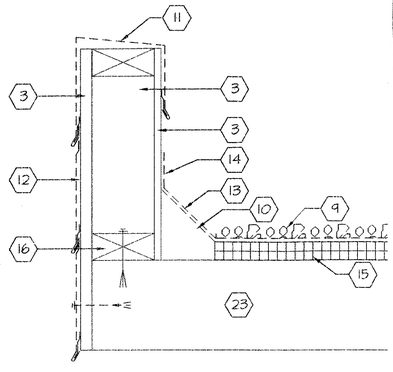

2 ROOF DETAIL
D-8 3"=1'-0"

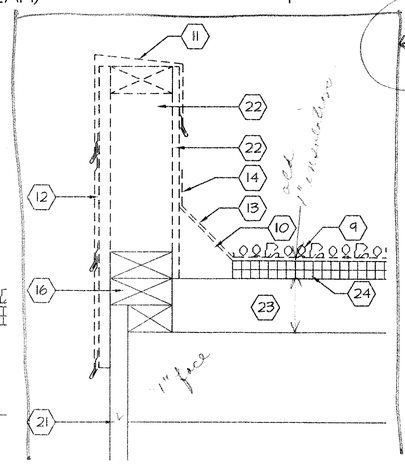

3 ROOF DETAIL
D-8 3"=1'-0"

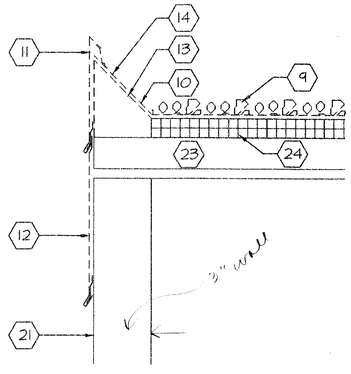

4 ROOF DETAIL
D-8 3"=1'-0"

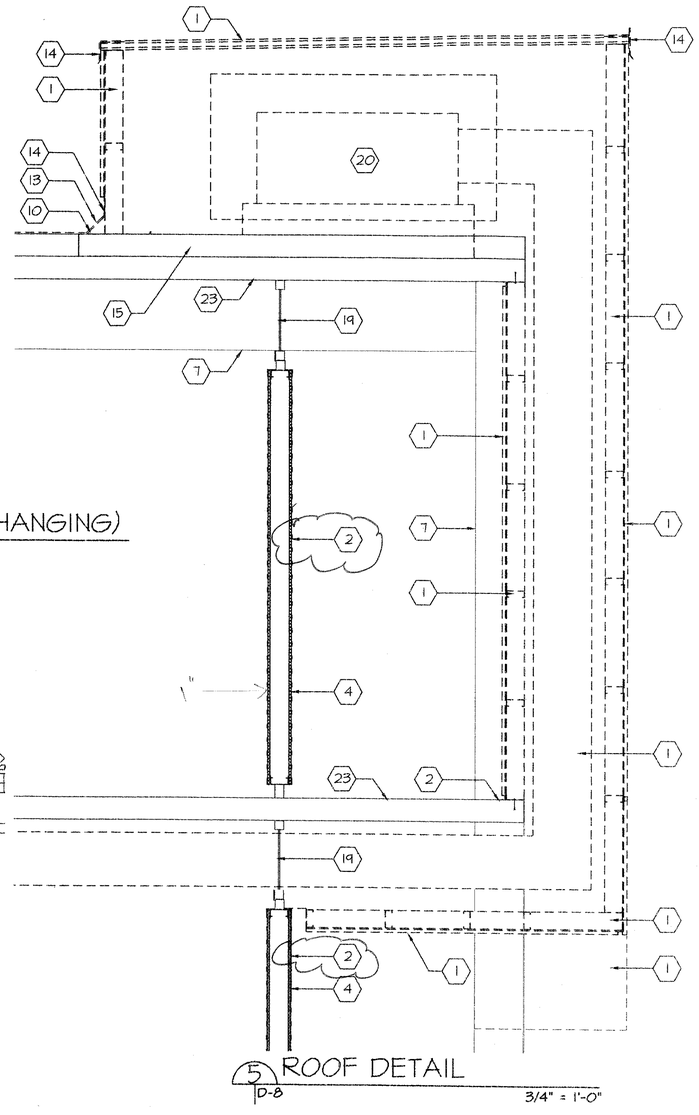

5 ROOF DETAIL
D-8 3/4" = 1'-0"

CONSULTANT
BYRON J. STEWART & ASSOC.
ARCHITECTS & PLANNERS
2300 MARENGO ST
NEW ORLEANS LA 70115
(504) 897-5339

CLIENT
NEW ORLEANS PARISH SCHOOL BOARD
4300 ALMONASTER AVE
NEW ORLEANS, LA.

PROJECT
CARTER G. WOODSON JUN. HIGH SCHOOL
RE-ROOFING AND MECH. REPAIRS
F.D.P. # 92034

JOB NUMBER: 9602
DATE: 4-21-97
DRAWN BY: M.A.
CHECKED BY: B.J.S.

REVISIONS		
NO.	DATE	REVISION

SHEET
D-8
OF SHEETS

C:\SDSKPROJ\9602\D-8 Thu Feb 27 09:27:06 1997