



SANITARY SEWER LINE RISER
SCALE: N.T.S.

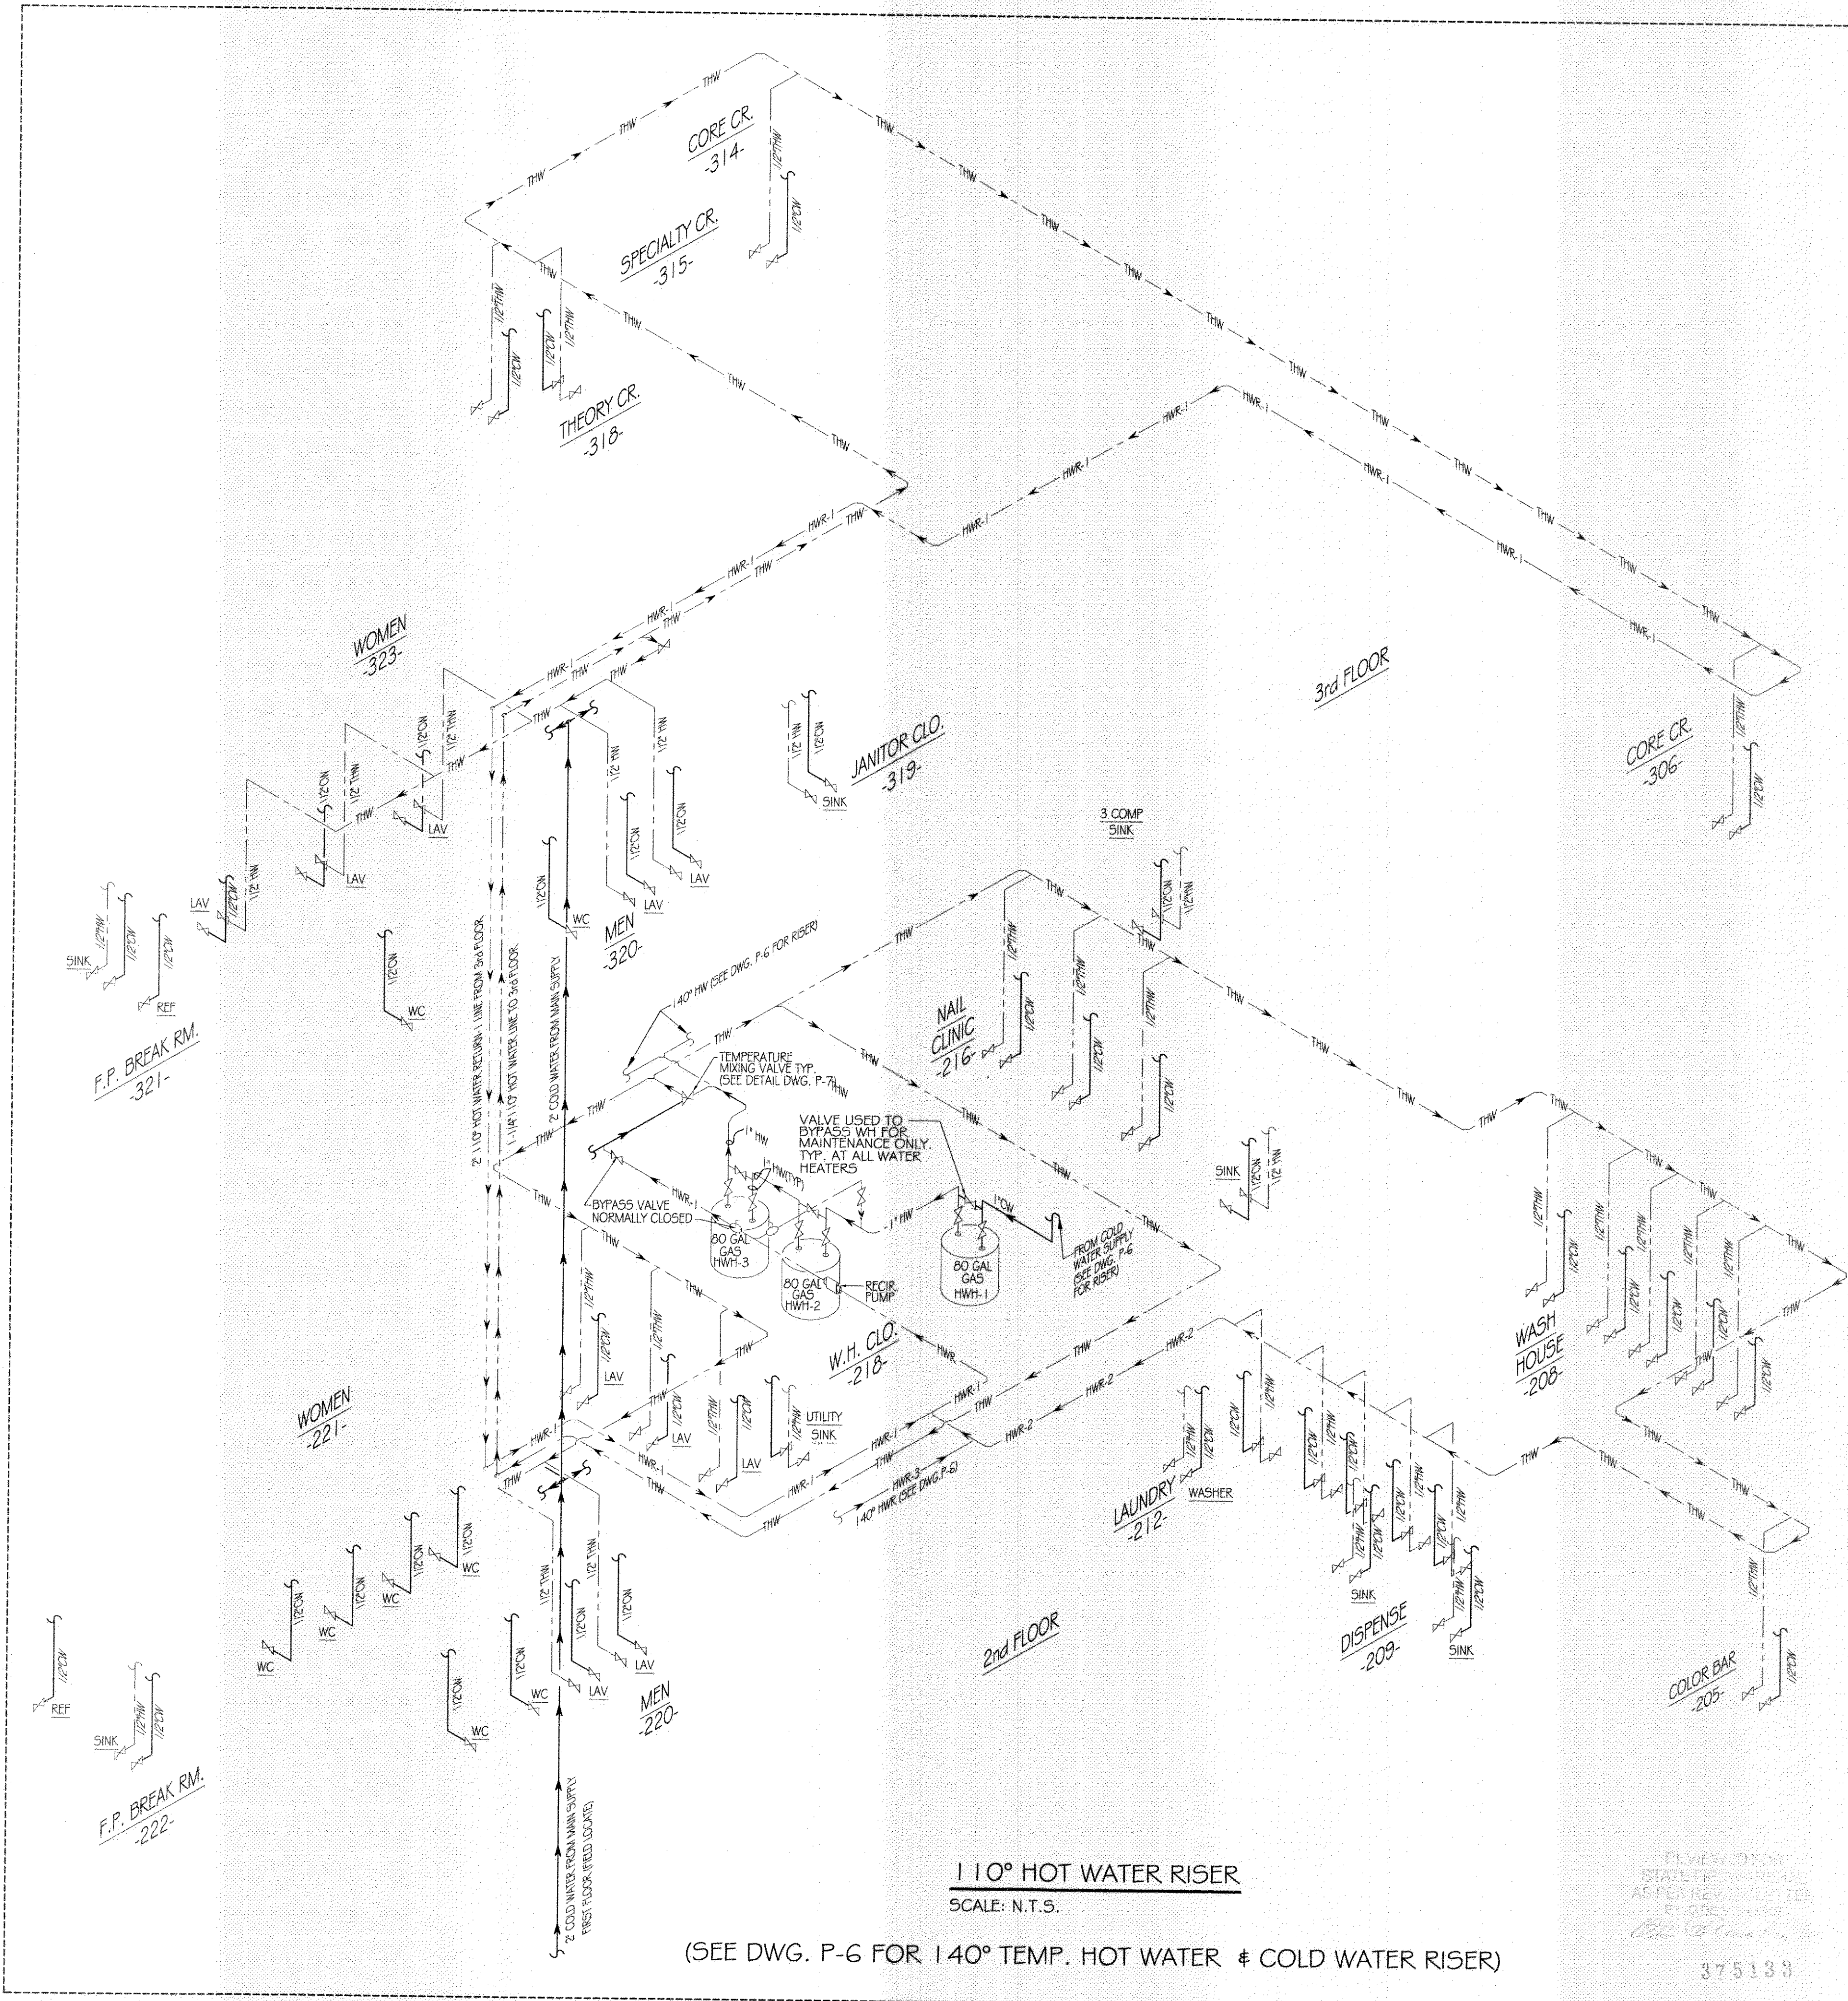

110° HOT WATER RISER
SCALE: N.T.S.

(SEE DWG. P-6 FOR 140° TEMP. HOT WATER & COLD WATER RISER)

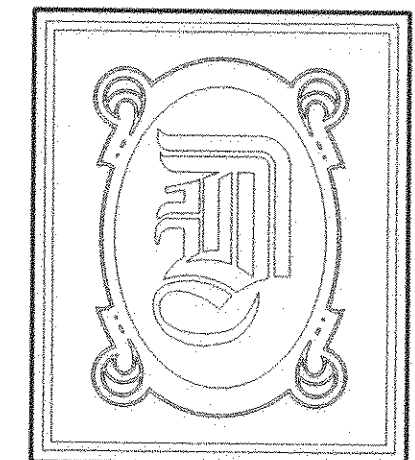

DAMMON ENGINEERING, INC.

CHIEF ENGINEER
EMMETT DAMMON, P.E.

CHIEF ARCHITECT
ROBERT WILTSE

1095 FLORIDA AVENUE
SLIDELL, LA. 70458
OFFICE: 985-649-5832
FAX: 985-641-5950


WEBSITE:
WWW.DAMMONENGINEERING.COM

EMAIL:
DAMMONENG@BELLSOUTH.NET

- ARCHITECTURE
- ENGINEERING
- STUDIES
- PLANNING
- INVESTIGATION
- EXPERT WITNESS

PAUL MITCHELL
SCHOOL
3321 HESSMER AVE.
METAIRIE, LA
70002

110° WATER &
SEWER LINE
RISERS

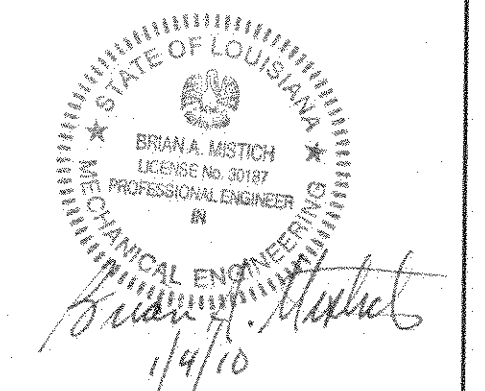

REV:
SCALE: AS NOTED
JOB#: 2051
DATE: 01-04-10
SHEET

375138
P-5
OF