

1 KEYNOTE PLAN - SECOND FLOOR  
 A102a SCALE: 1/8"=1'-0"

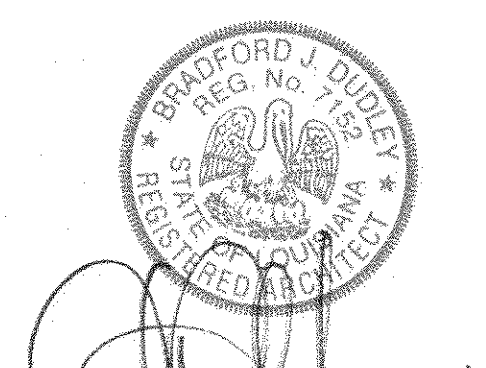
NOTES:  
 1. REFER TO SHEET A 101a FOR ALL KEYNOTES.

PERMIT ISSUE SET: 12.30.09

ARCHITECTS OF RECORD:  
 BRADFORD J. DUDLEY  
 345 THIRD STREET  
 LAGUNA BEACH, CALIFORNIA 92651  
 T: 949.376.3076 F: 949.376.3078

**PAUL MITCHELL**  
**PARTNER SCHOOL**  
 METAIRIE, LA  
 3321 HESSMER AVENUE  
 METAIRIE, LA 70002

CLIENT:  
 MARK AND USA PALERMO

PROFESSIONAL SEAL:  
  
 SIGNATURE: \_\_\_\_\_ DATE: 12-24-2009

SUBMISSION	DATE
CONCEPT PLAN	12.01.09
CONSULTANT COORDINATION	12.14.09
PERMIT ISSUE SET	12.30.09

PROJECT NO: 0921  
 SCALE: \_\_\_\_\_

**SECOND FLOOR KEYNOTE PLAN**  
 REVIEWED FOR  
 STATE FIRE MARSHAL  
 AS PER REVIEW LETTER  
 BY CITY ENGINEER  
 A. C. ...  
 375133  
**A 102a**