


1 LIGHTING PLAN AND RCP - THIRD FLOOR
 A 223 SCALE: 1/8"=1'-0"

GENERAL NOTES:

1. GENERAL CONTRACTOR TO COORDINATE A PRE-CONSTRUCTION SITE WALK THROUGH MEETING TO FIELD VERIFY OUTLET AND FIXTURE LOCATIONS AND TYPES WITH ARCHITECT, OWNER AND ELECTRICAL SUBCONTRACTOR PRIOR TO COMMENCING ELECTRICAL WORK AND PURCHASE OF FIXTURES.
2. VERIFY POWER REQUIREMENTS OF ALL APPLIANCES WITH SELECTED APPLIANCE MANUFACTURER.
3. RECESSED LIGHTING FIXTURES RECESSED INTO INSULATED CEILINGS MUST BE APPROVED FOR ZERO CLEARANCE INSULATION COVER (IC) BY UNDERWRITER LABORATORIES OR OTHER TESTING/RATING LABORATORIES RECOGNIZED BY THE INTERNATIONAL CONFERENCE OF BUILDING OFFICIALS (ICBO).
4. EXHAUST FAN TO BE CAPABLE OF PROVIDING 5 FULL VOLUME AIR CHANGES PER HOUR.
5. WIRING DEVICES: SWITCHES AND CONVENIENCE OUTLETS SHALL BE "LEVITON" SPEC. GRADE. COLOR: WHITE, NOT IVORY. INSTALL AT HEIGHTS REQUIRED BY CURRENT CODE.
6. EXTENT: COMPLETE WIRING INSTALLATION FOR POWER, LIGHTING, SIGNAL SYSTEM AND TELEPHONE. CODES: ALL WIRING AND MATERIAL SHALL BE IN FULL ACCORDANCE WITH NATIONAL, STATE AND LOCAL ELECTRICAL CODES INCLUDING TITLE 24.
7. GENERAL CONTRACTOR TO PROVIDE SUBMITTAL PACKAGE FOR ARCHITECT TO REVIEW PRIOR TO ORDERING ANY LIGHT FIXTURES.

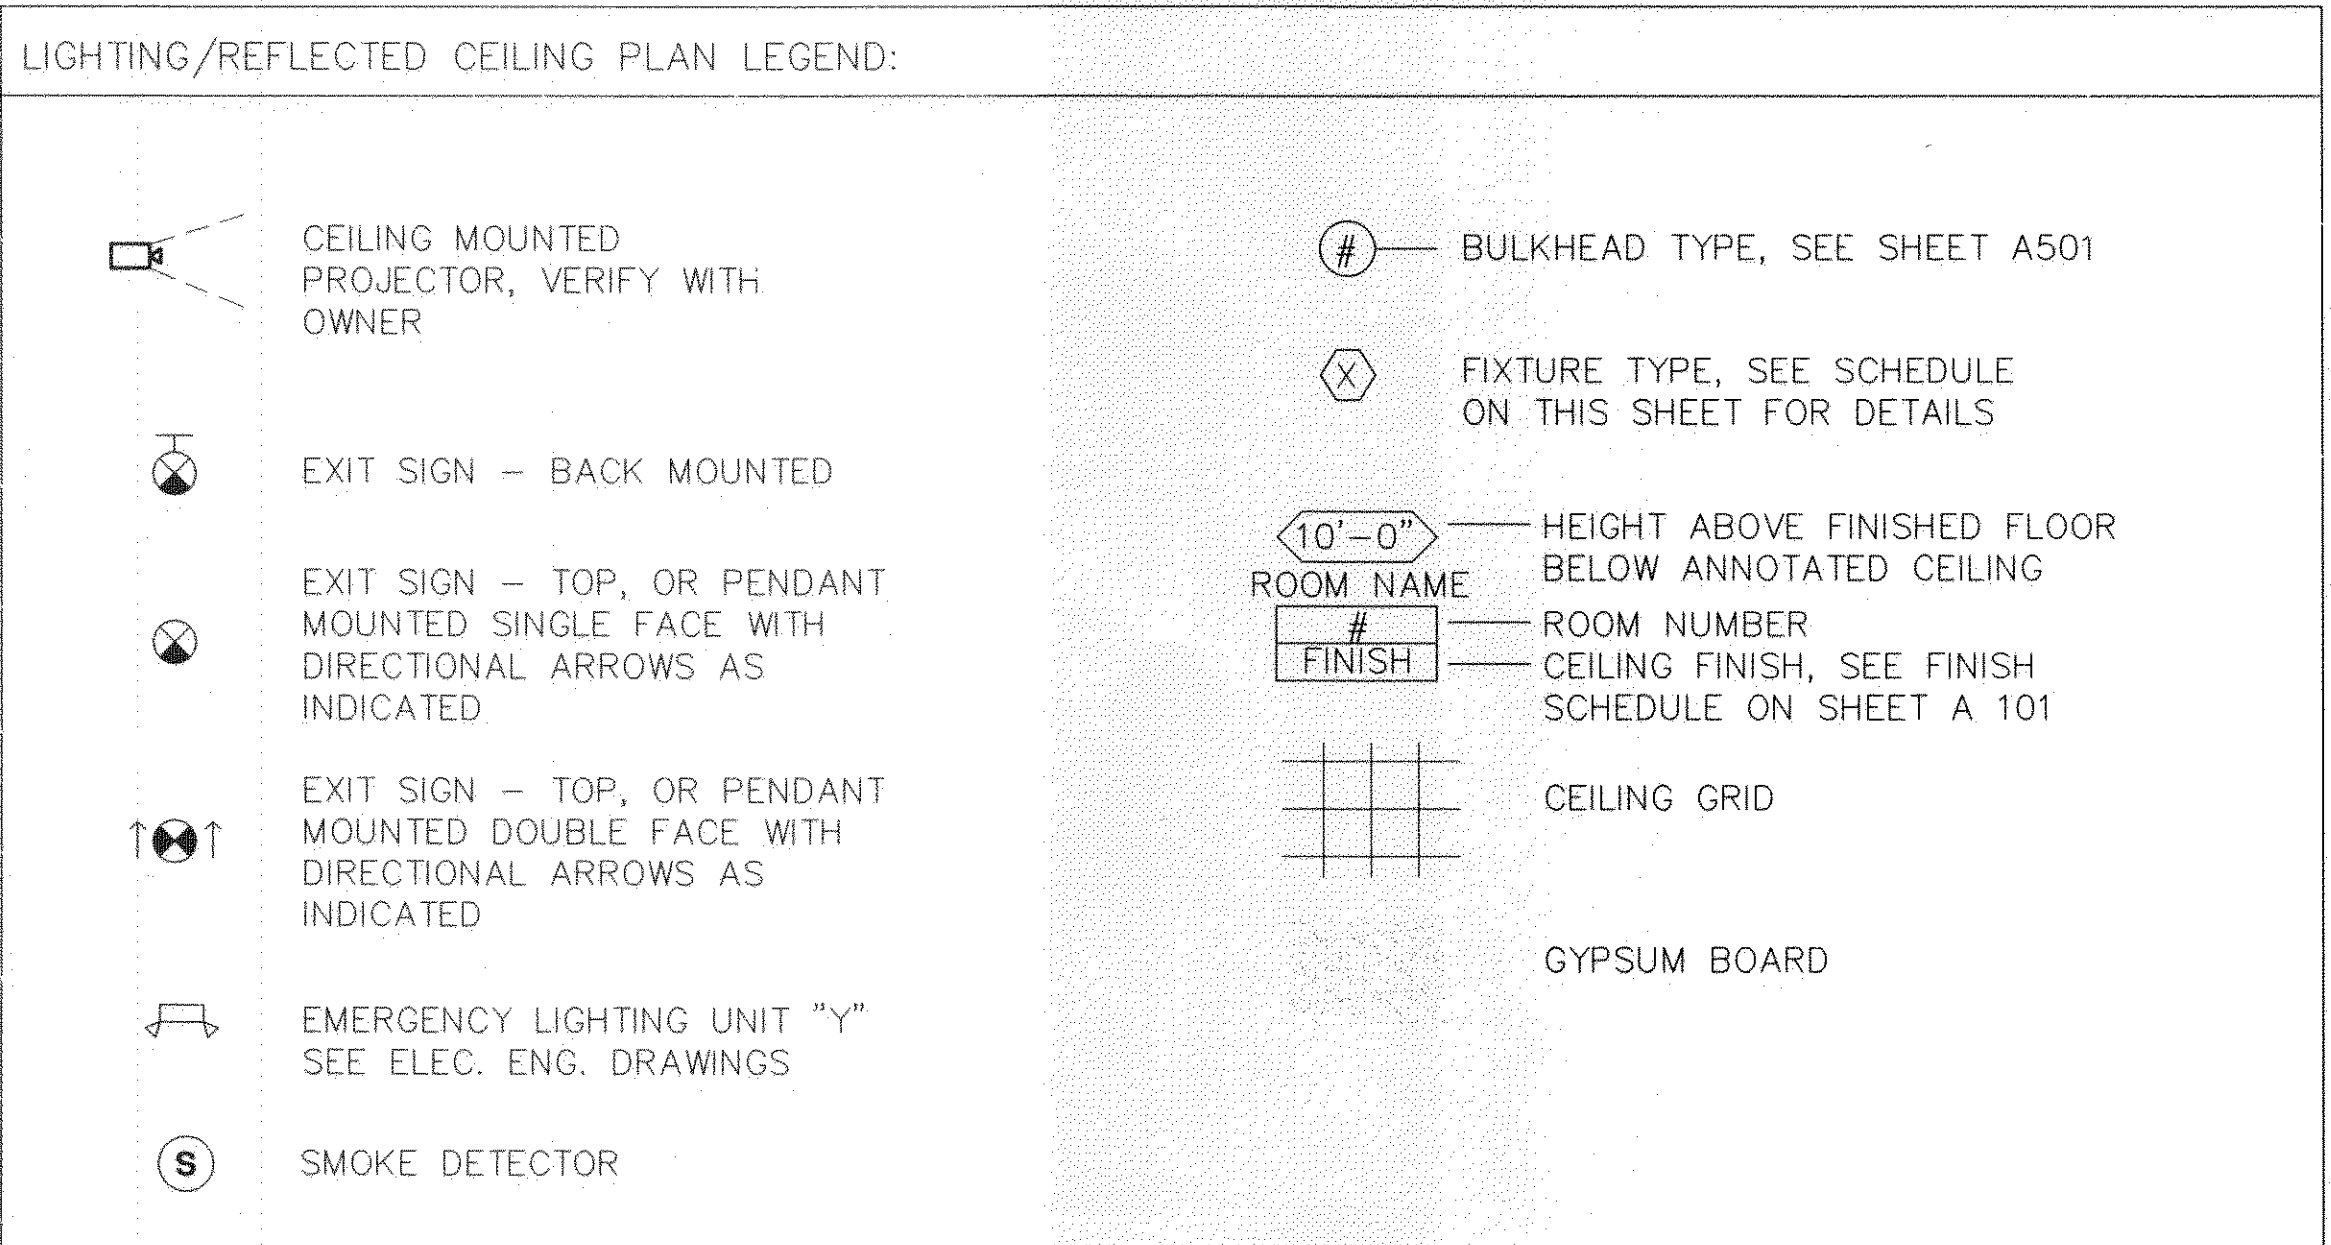

ARCHITECTS OF RECORD:

 BRADFORD J. DUDLEY
 345 THIRD STREET
 LAGUNA BEACH, CALIFORNIA 92651
 T: 949.376.3076 F: 949.376.3078

PAUL MITCHELL
 PARTNER SCHOOL

METAIRIE, LA

 3321 HESSMER AVENUE
 METAIRIE, LA 70002

CLIENT:
 MARK AND USA PALERMO

PROFESSIONAL SEAL:

 SIGNATURE DATE 12-24-2009

| SUBMISSION | DATE |
|-------------------------|----------|
| CONCEPT PLAN | 12.01.09 |
| CONSULTANT COORDINATION | 12.14.09 |
| PERMIT ISSUE SET | 12.30.09 |

PROJECT NO: 0921
 SCALE:

THIRD FLOOR REFLECTED CEILING PLAN

 A 223

REVIEWED FOR STATE FIRE MARSHAL AS PER REVIEW LETTER BY OUIS V. RANKE
 375133

PERMIT ISSUE SET: 12.30.09