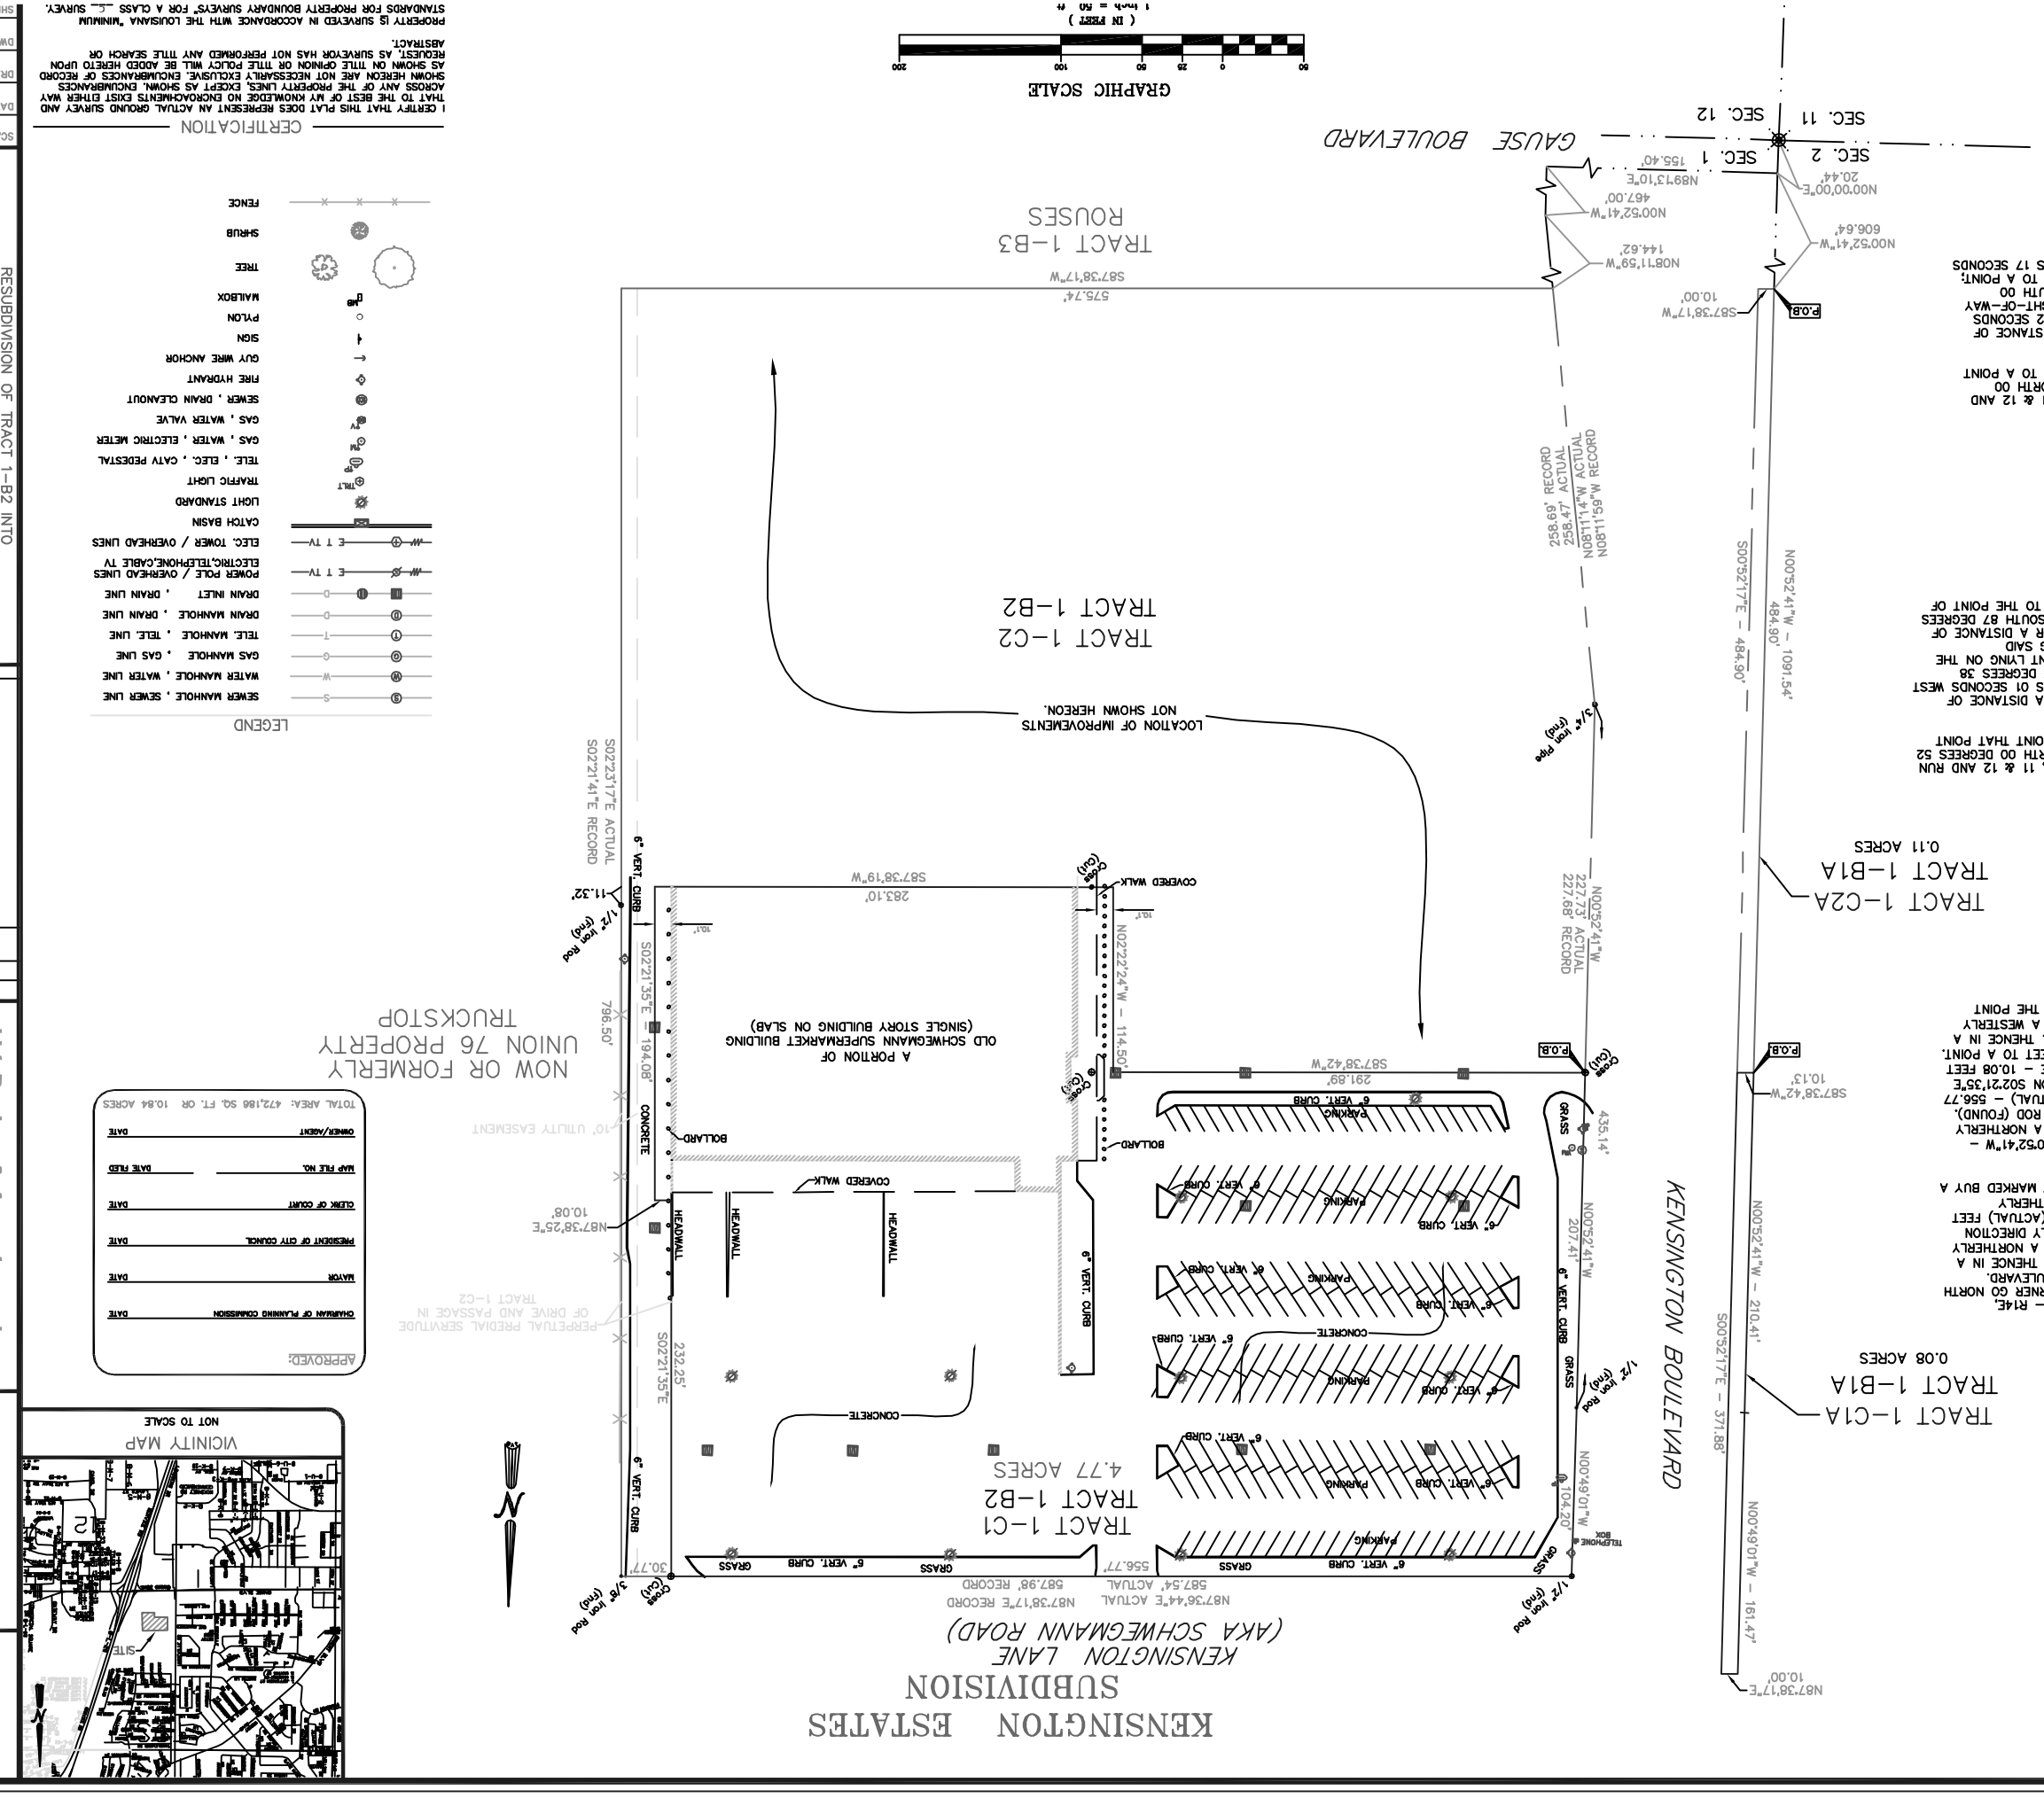
KENSINGTON ESTATES SUBDIVISION
KENSINGTON LANE (AKA SCHWEGMANN ROAD)
KENSINGTON BOULEVARD
GAUSE BOULEVARD
TRACT 1-C1 TRACT 1-B2 4.77 ACRES
TRACT 1-C2 TRACT 1-B2
TRACT 1-B3 ROUSES
TRACT 1-C2A TRACT 1-B1A 0.11 ACRES
TRACT 1-C1A TRACT 1-B1A 0.08 ACRES
NOW OR FORMERLY UNION 76 PROPERTY TRUCKSTOP
A PORTION OF OLD SCHWEGMANN SUPERMARKET BUILDING (SINGLE STORY BUILDING ON SLAB)
LOCATION OF IMPROVEMENTS NOT SHOWN HEREON.
GRAPHIC SCALE
(IN FEET)
1 inch = 50 ft
LEGEND
VICINITY MAP
NOT TO SCALE
CERTIFICATION
GENERAL NOTES
BOUNDARY DESCRIPTION
TRACT 1-C1A
BOUNDARY DESCRIPTION
TRACT 1-C2A
BOUNDARY DESCRIPTION
TRACT 1-C1
APPROVED:
TOTAL AREA: 472,186 SQ. FT. OR 10.84 ACRES
OWNER/AGENT DATE
MAP FILE NO. DATE FILED
CLERK OF COURT DATE
PRESIDENT OF CITY COUNCIL DATE
MAYOR DATE
CHAIRMAN OF PLANNING COMMISSION DATE
J.V. Burkes & Associates, Inc.
SURVEYING ENGINEERING ENVIRONMENTAL
1805 Shortcut HWY.
Slidell, Louisiana 70458
E-mail: jvbassoc@jvburkes.com
Phone: 985-649-0275 Fax: 985-649-0154
Mississippi Phone: 228-435-5800
SEAL M. BURKES
LA. REG. NO. 4785
DATE BY PARTS
DESCRIPTION
REVISIONS
NORTHSHORE CHURCH
SCALE: 1" = 50'
DATE: 02/20/2008
DRAWN BY: BPT
CHECKED BY: SMB
DWG. NO. 20080220
SHEET