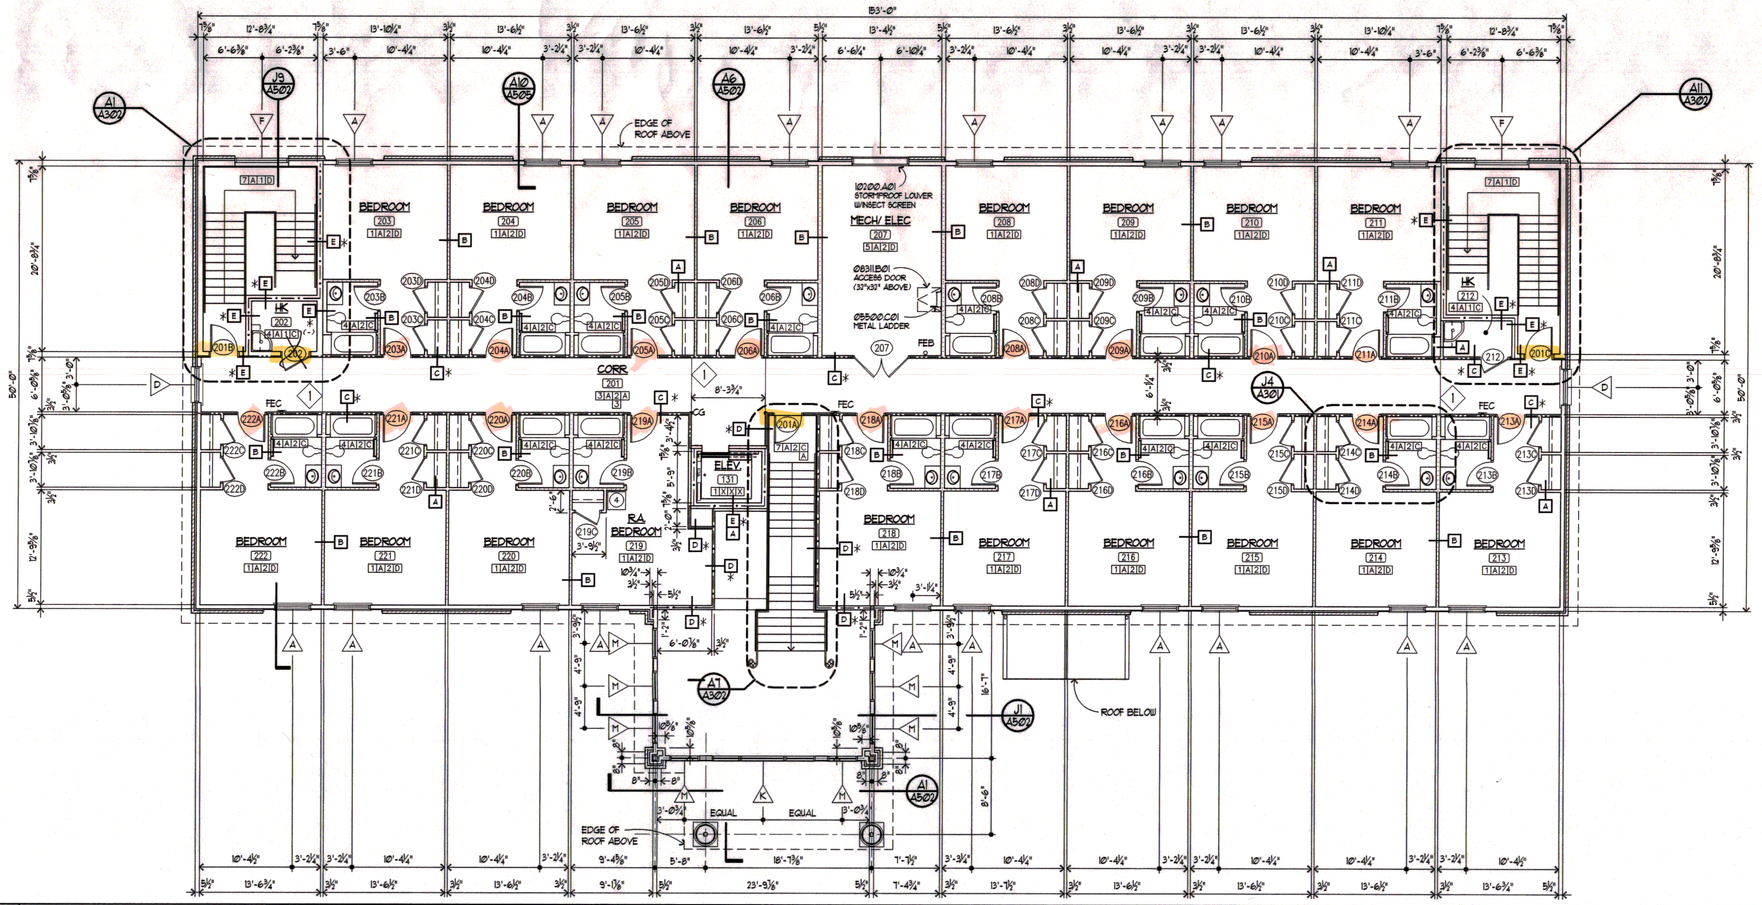

J1 BUILDING "C" - RESIDENCE HALL - SECOND FLOOR PLAN

1/8" = 1'-0" | 7,610 GROSS SQUARE FEET

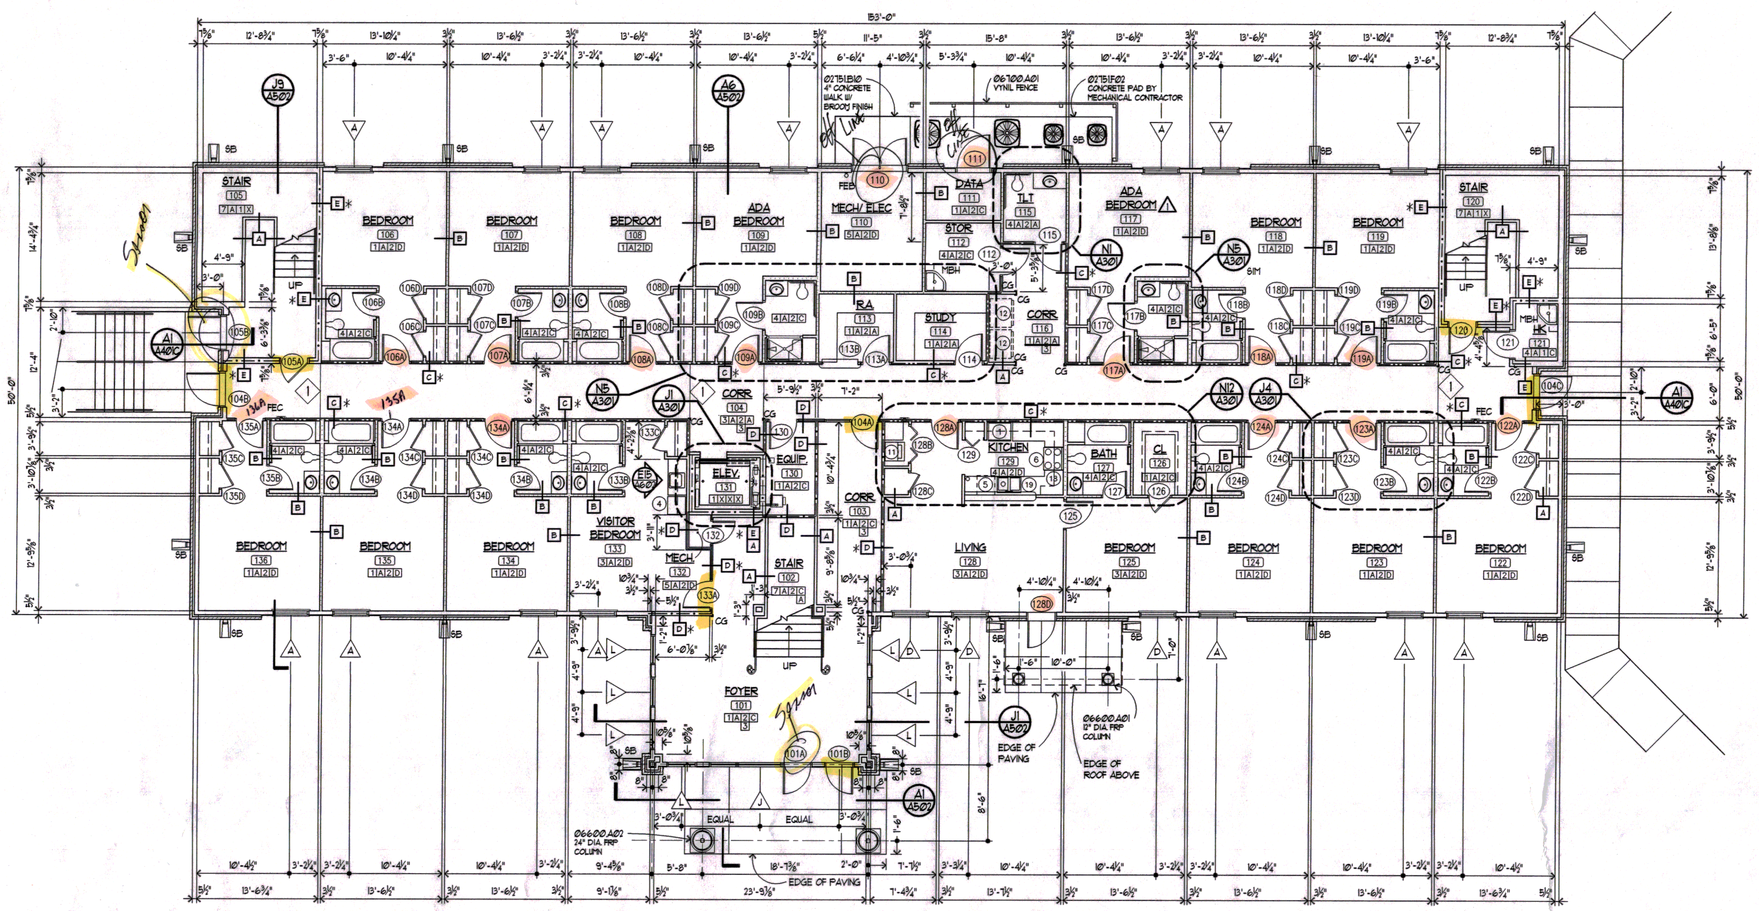

A1 BUILDING "C" - RESIDENCE HALL - GROUND FLOOR PLAN

1/8" = 1'-0" | 7,160 GROSS SQUARE FEET

FLOOR | CEILING | BASE | WALLS

FINISH KEY

I FLOOR

1	VINYL COMPOSITION TILE
2	PORCELAIN CERAMIC TILE
3	CARPET
4	RESILIENT SHEET VINYL
5	SEALED CONCRETE
6	SPECIAL VINYL FLOOR
7	RUBBER TREAD/ RISER/ LANDING
X	NO FINISH

A BASE

A	4" RUBBER BASE
B	PORCELAIN CERAMIC TILE INTEGRAL SANITARY BASE
C	SPECIAL RUBBER BASE
X	NO BASE

I WALLS

1	CMU (PAINT)
2	GYPSUM BOARD (PAINT)
3	PAINTED CHAIR RAIL UM #0001 @ 32" AFF.
X	NO FINISH

A CEILING

A	2X2 ACOUSTIC LAY-IN
B	NOT USED
C	GYPSUM BOARD (PAINT)
D	GYPSUM BOARD (ACOUSTICAL FINISH)
X	NO CEILING FINISH

KEYNOTES

1. HIGH TRAFFIC AREAS SHOWN TO BE VINYL COMPOSITION TILE

EQUIPMENT LIST

MARK	DESCRIPTION	PROVIDE	ROUGH IN	INSTALL
1	REFRIGERATOR	OWNER	GC	OWNER
2	DUEL FUEL RANGE	OWNER	GC	GC
3	REFRIGERATOR (UNDER COUNTER)	OWNER	GC	OWNER
4	MICROFRIDGE	OWNER	GC	OWNER
5	DISHWASHER	OWNER	GC	GC
6	RANGE	OWNER	GC	GC
7	ICE MAKER (UNDER COUNTER)	OWNER	GC	GC
8	MICROWAVE	OWNER	GC	GC
9	COMMERCIAL DRYER (STACKED)	OWNER	GC	GC
10	COMMERCIAL WASHER	OWNER	GC	GC
11	STACKED WASHER / DRYER	OWNER	GC	GC
12	VENDING MACHINE	OWNER	GC	OWNER
13	WORK TABLE	OWNER	GC	OWNER
14	COPIER	OWNER	GC	OWNER
15	PAPER SHREDDER	OWNER	GC	OWNER
16	CHANGE MACHINE	OWNER	GC	OWNER
17	SAFE	OWNER	-	OWNER
18	VENT HOOD	GC	GC	GC
19	GARBAGE DISPOSAL	GC	GC	GC

SPECIALTIES LEGEND

- 5B — 07185G10 CONCRETE SPLASH BLOCK
- CG — 10265.A01 CORNER GUARD
- FEC — 10530.C01 60H-RECESSED FIRE EXT. CABINET
- FED — 10530.D01 FIRE EXT. BRACKET
- MBH — 10950.L01 MOP AND BROOM HOLDER

MATERIALS KEYING

DIV 07 SITE CONSTRUCTION

07185G10	4" CONCRETE WALK W/ BROOM FINISH
07185P20	CONCRETE PAD BY MECHANICAL CONTRACTOR
07185G10	CONCRETE SPLASH BLOCK

DIV 05 METALS

05500.C01	METAL LADDER

DIV 06 WOOD AND PLASTICS

06400.A01	12" DIA. FRP COLUMN
06400.A02	24" DIA. FRP COLUMN
06100.A01	VINYL FENCE

DIV 08 DOORS AND WINDOWS

08310.B01	ACCESS DOOR

DIV 10 SPECIALTIES

10100.A01	STORMPROOF LOUVER W/INSECT SCREEN
10265.A01	CORNER GUARD
10530.C01	60H-RECESSED FIRE EXT. CABINET
10530.D01	FIRE EXT. BRACKET
10950.L01	MOP AND BROOM HOLDER

WALL TYPES

A — STUD WALL NR (NON RATED)

06100D32	2 x 4 STUDS @ 16" O.C.
06100D42	2 x 6 STUDS @ 16" O.C.
09250.B01	5/8" TYPE "X" GYP. BD.

B — SOUND STUD WALL NR (NON RATED)

06100D32	2 x 4 STUDS @ 16" O.C.
06100D42	2 x 6 STUDS @ 16" O.C.
09250.B01	5/8" TYPE "X" GYP. BD.
09250.P20	ACOUSTICAL SEALANT
07100.G01	3" SOUND ATTENUATION BATTS

C — 1/2 HOUR RATED WALL STUD

06100D32	2 x 4 STUDS @ 16" O.C.
06100D42	2 x 6 STUDS @ 16" O.C.
09250.B01	5/8" TYPE "X" GYP. BD.
07100.G01	3" SOUND ATTENUATION BATTS

# INDICATES 1/2 HOUR RATED WALL STUD WITH 3" SOUND ATTENUATION BLANKET

D — 1 HOUR RATED STUD WALL

06100D32	2 x 4 STUDS @ 16" O.C.
06100D42	2 x 6 STUDS @ 16" O.C.
09250.B01	5/8" TYPE "X" GYP. BD.
07100.K01	FIRE CAULKING
07100.G01	3" SOUND ATTENUATION BATTS

# INDICATES 1 HOUR RATED WALL STUD WITH 3" SOUND ATTENUATION BLANKET

E — 1 HOUR RATED CMU WALL

04810.G01	8" CONCRETE BLOCK
06100D35	2 X 4 STUDS STAGGERED @ 16" O.C.
09250.B01	5/8" TYPE "X" GYPSUM BOARD
07100.K01	FIRE CAULKING
07100.K01	FOAM INSULATION

# INDICATES SOUND ATTENUATION

(-) INDICATES NOT FIRE RATED

GENERAL NOTES

1. ALL DIMENSIONS ARE TO FACE OF BLOCK, STUD, CONCRETE, OR TO COLUMN GRID LINE UNLESS OTHERWISE NOTED. SEE ENLARGED PLANS FOR CONTINUATION OF DIMENSIONS. ALL NON-PERPENDICULAR WALLS ARE 45° RELATIVE TO BASELINE DIMENSIONS UNLESS OTHERWISE NOTED.
2. CONTRACTOR SHALL PROTECT ALL CONCRETE SURFACES THAT ARE TO REMAIN EXPOSED UPON COMPLETION OF CONSTRUCTION. CONCRETE SHALL BE FREE OF STAINS, SCRATCHES, RUST, PAINT, PATCH MATERIAL, AND ETC.
3. IN GYPSUM WALLBOARD APPLICATIONS INSTALL CONTROL JOINTS IN ACCORDANCE WITH ASTM C840 AT LOCATIONS INDICATED. WHERE GYPSUM WALLBOARD IS ADHERED DIRECTLY TO CMU SUBSTRATE, PROVIDE CONTROL JOINTS TO ALIGN WITH THOSE IN SUBSTRATE. IN SOUND PARTITIONS, PROVIDE SOUND INSULATION BEHIND CONTROL JOINT TO MAINTAIN SOUND RATING.
4. PROVIDE COMPLETE FIRESTOP AT ALL STRUCTURAL, MECHANICAL, AND ELECTRICAL PENETRATIONS THROUGH ALL FIRE RATED ASSEMBLIES.
5. ADJACENT WALL TYPE CONSTRUCTION APPLIES TO DOOR HEADERS.
6. CONTRACTOR TO PROVIDE BLOCKING AS NECESSARY IN GYPSUM BOARD WALLS FOR CABINETS, ACCESSORIES, EQUIPMENT, AND ETC. COORDINATE WITH PLANS AND INTERIOR ELEVATIONS.
7. WALL TYPE A , 3 1/2" WOOD STUD, 16 TYPICAL WALL CONSTRUCTION UNLESS OTHERWISE NOTED.
8. AT ALL HOUSE KEEPING FLOOR SINKS, PROVIDE 24"x24"x48" HIGH IMPACT PLASTIC WALL PROTECTION. USING FULL BED OF ADHESIVE AND CAULK ALL JOINTS.
9. FLUSH FLOOR ELECTRICAL/ DATA OUTLETS TO BE 12'-0" O.C. AND CENTERED WITHIN MULTI-PURPOSE ROOMS.

COMPUTER GRAPHICS by THE McCARTY COMPANY DESIGN GROUP, P.A.

Plot Date: BID DOCUMENTS – 21 FEB 2006

THE McCARTY COMPANY DESIGN GROUP, P.A.

MAILING ADDRESS: P.O. BOX 440 TUPELO, MS 38802

OFFICE ADDRESS: 533 WEST MAIN STREET TUPELO, MS 38804

TELEPHONE: (662) 844-8400 FAX: (662) 844-0500

PROJECT NO: 2005060

CAD FILE NO: 5060A101C

DATE ISSUED: 21 FEB 2006

DRAWN BY: jph

CHECKED BY: TDS

REVISION/DATE: 1 15 MAR 2006

PROJECT TITLE
THE VILLAGE
THE UNIVERSITY OF SOUTHERN MISSISSIPPI
IHL# 208-260
HATTIESBURG, MISSISSIPPI

SHEET NUMBER
A101.C
— of —