

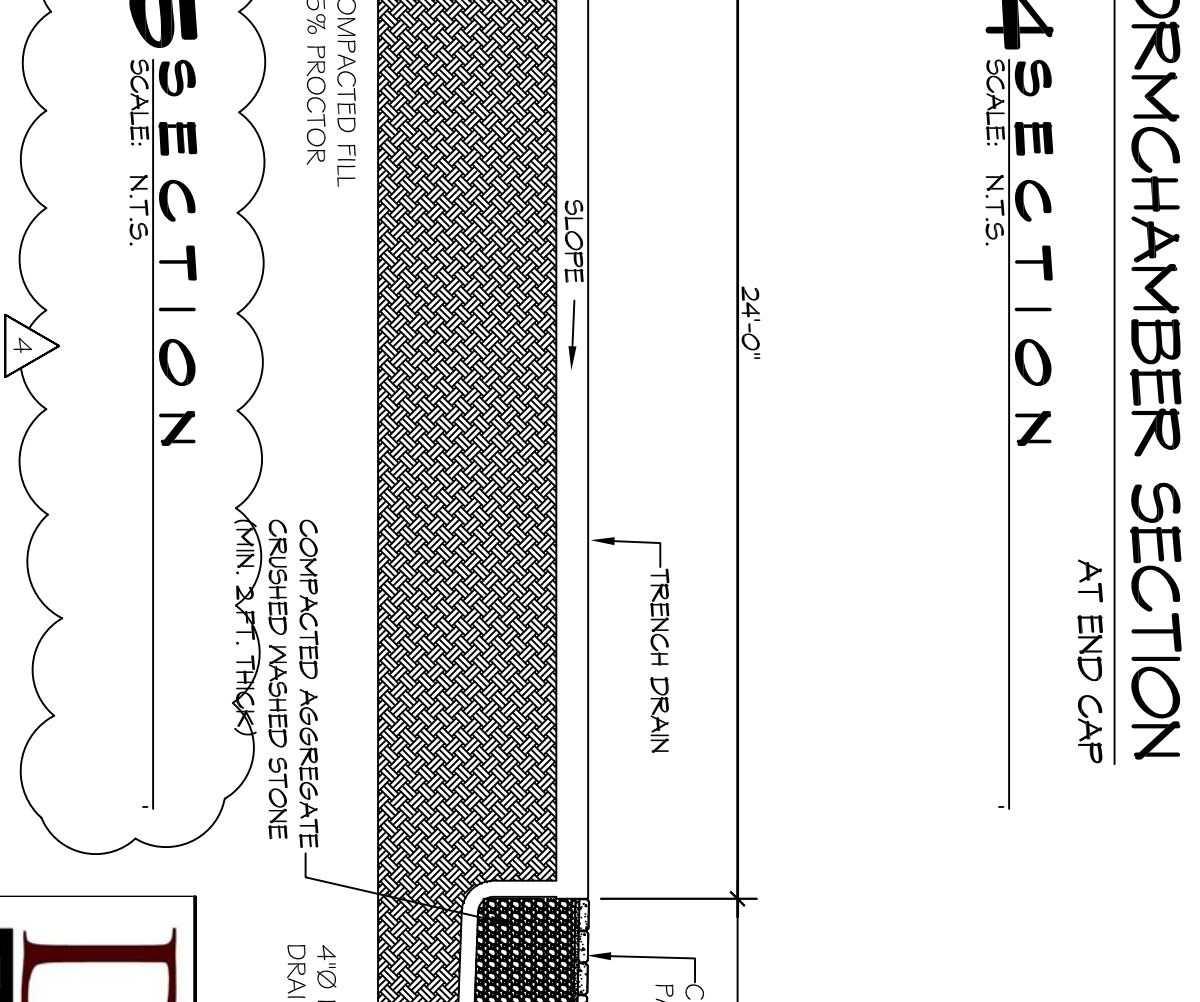
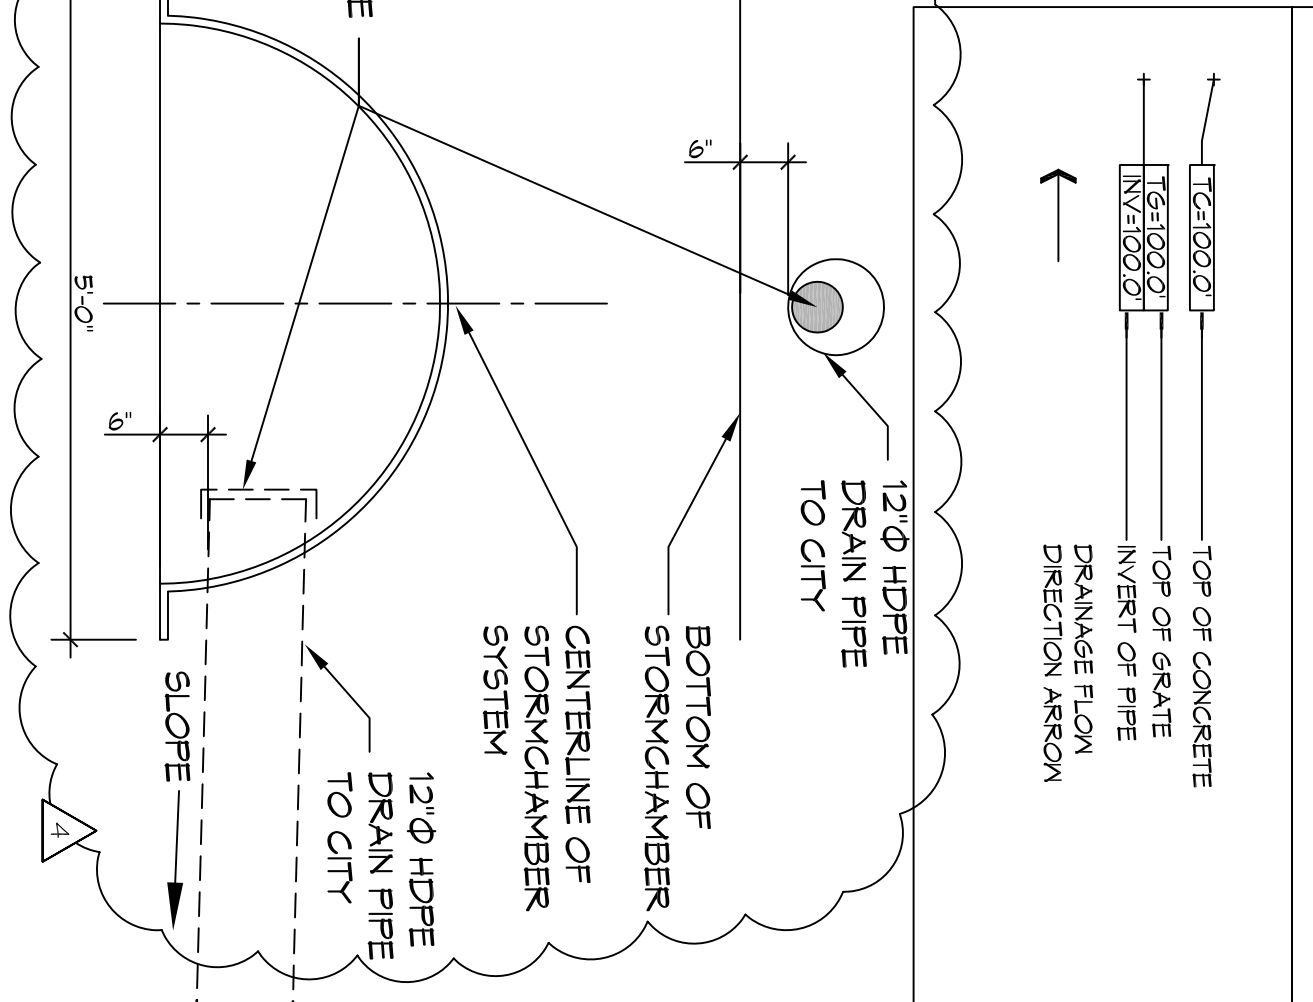


- ### GENERAL NOTES
1. DRAIN PIPES MUST BE THE BELL AND GIGGOT TYPE WITH 'O' RING RUBBER GASKETS. THE BELLS OF THE PIPES SHALL BE LINED WITH 1/2\"/>
 - 2. REPLACE ANY BROKEN/CRUSHED PIPES OR GULCHES WITH SAME SIZE AND TYPE.
 - 3. DRAIN PIPE AND FITTINGS WITHIN PROPERTY LINE SHALL BE POLYVNTL-CLORIDE PLASTIC PIPE MEETING CLASS 100 C-900 PVC.
 - 4. ELEVATIONS SHOWN ARE NSL.
 - 5. FIELD VERIFY ALL ELEVATIONS AND AND DRAINAGE SYSTEM PLACEMENT PRIOR TO START OF WORK.
 - 6. PROVIDE VERTICAL ELBOW AT DOWNSPOUTS FOR CONNECTION TO SUBSURFACE DRAINAGE WHERE INDICATED. ELBOW ID SHALL BE SIZED SUCH THAT THE DOWNSPOUT CAN BE INSERTED INTO THE PIPE OPENING WITHOUT DEFORMATION TO THE DOWNSPOUT.

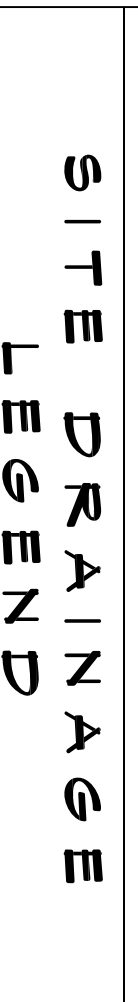



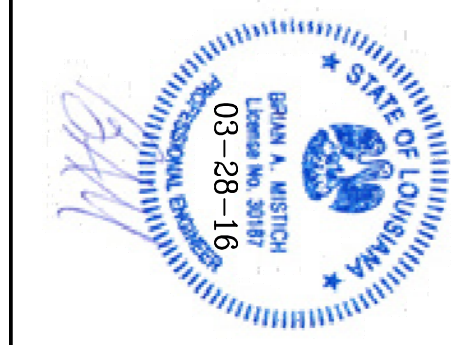

DAMMON ENGINEERING, INC.

RESIDENCE JOSEPHINE CONDOMINIUMS
2100 St. Thomas St.
New Orleans, Louisiana 70130

STEVEN J. FINNEGAN ARCHITECTS, LTD.
A PROFESSIONAL CORPORATION
123 S. Perce St. - New Orleans, LA 70119
(504) 486-5744 www.stevenfinneganarchitect.com
E-mail: stevenfinnegan@cox.com

DATE: 01-11-16
SCALE: AS SHOWN
FILE NAME: SHE DRAINAGE PLAN

NO. DATE REVISIONS

C1.2