



our lady of lourdes catholic church and rectory
slidell, louisiana

date 1-12-51
scale 1/8" = 1'-0"
drawn [signature]

sheet no. 1-13
architect [signature]

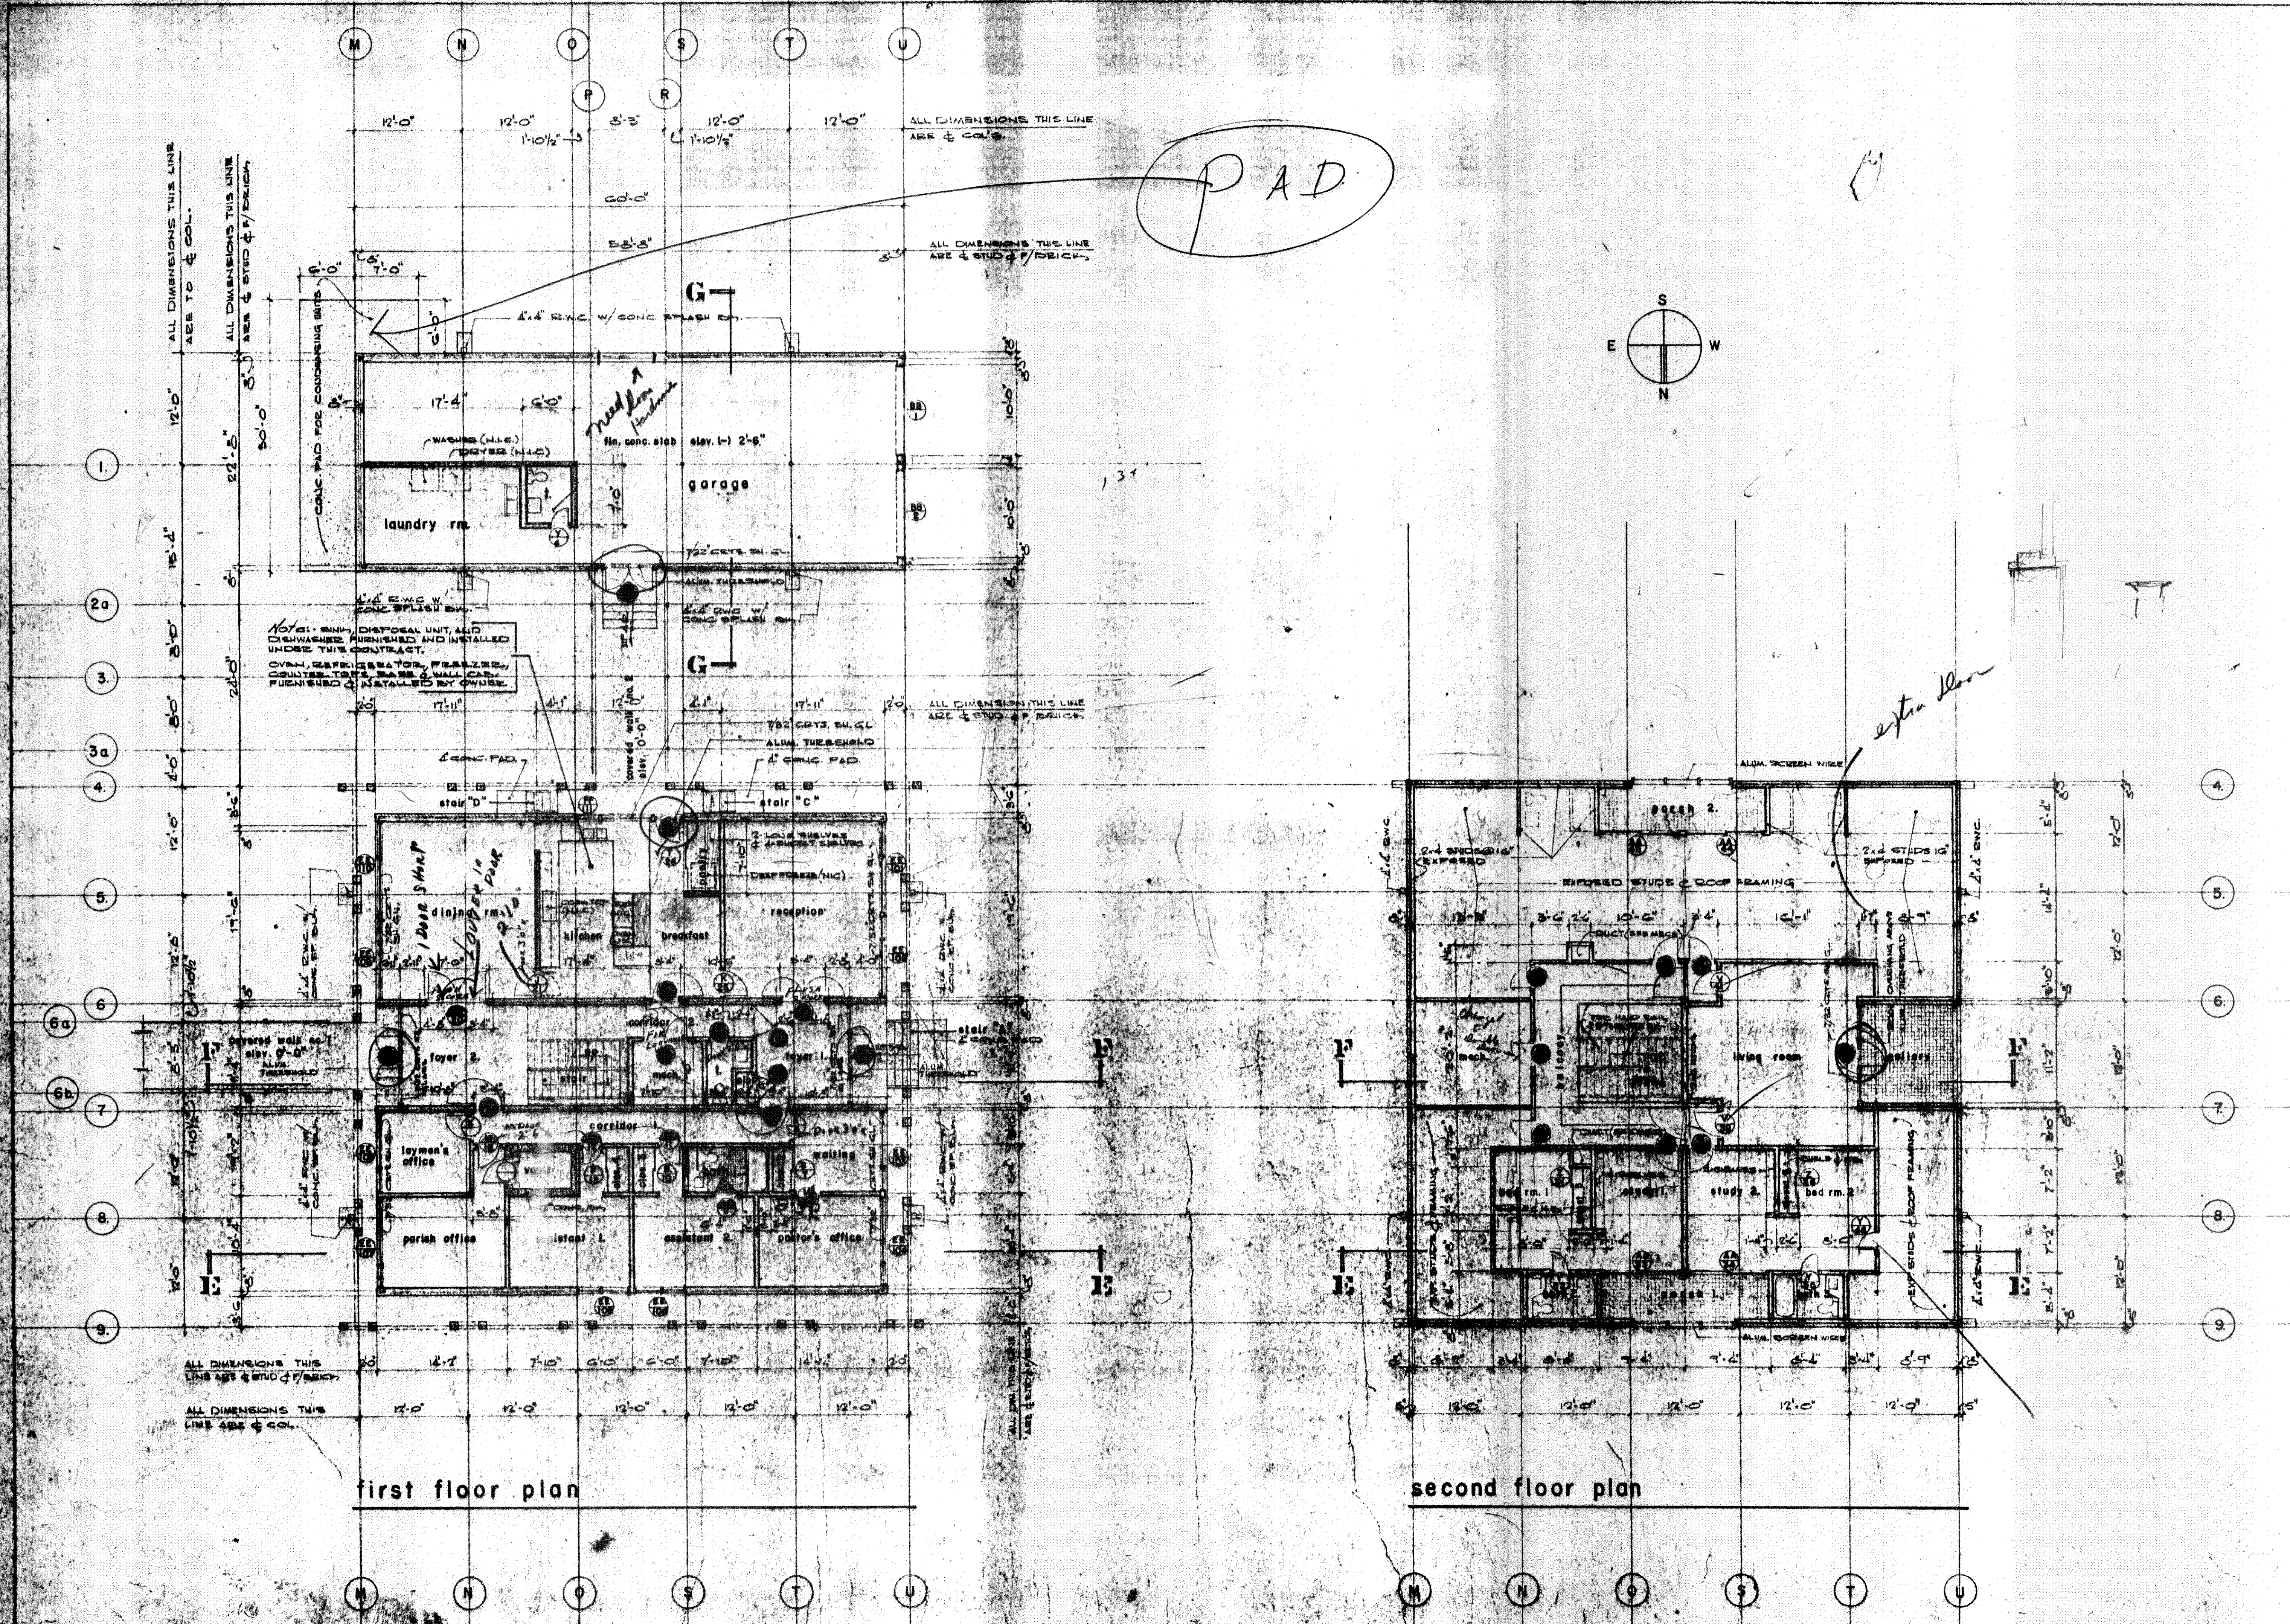

P.A.D.

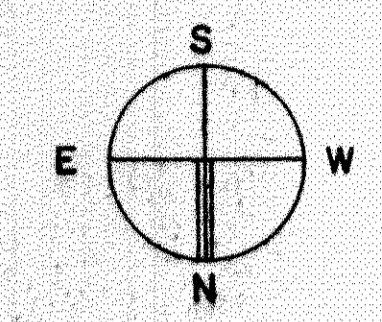

ALL DIMENSIONS THIS LINE ARE TO COL.

ALL DIMENSIONS THIS LINE ARE TO STD. & BRICK.

ALL DIMENSIONS THIS LINE ARE TO COL.

ALL DIMENSIONS THIS LINE ARE TO STD. & BRICK.

ALL DIMENSIONS THIS LINE ARE TO STD. & BRICK.

ALL DIMENSIONS THIS LINE ARE TO STD. & BRICK.

ALL DIMENSIONS THIS LINE ARE TO COL.

first floor plan

second floor plan

extra floor