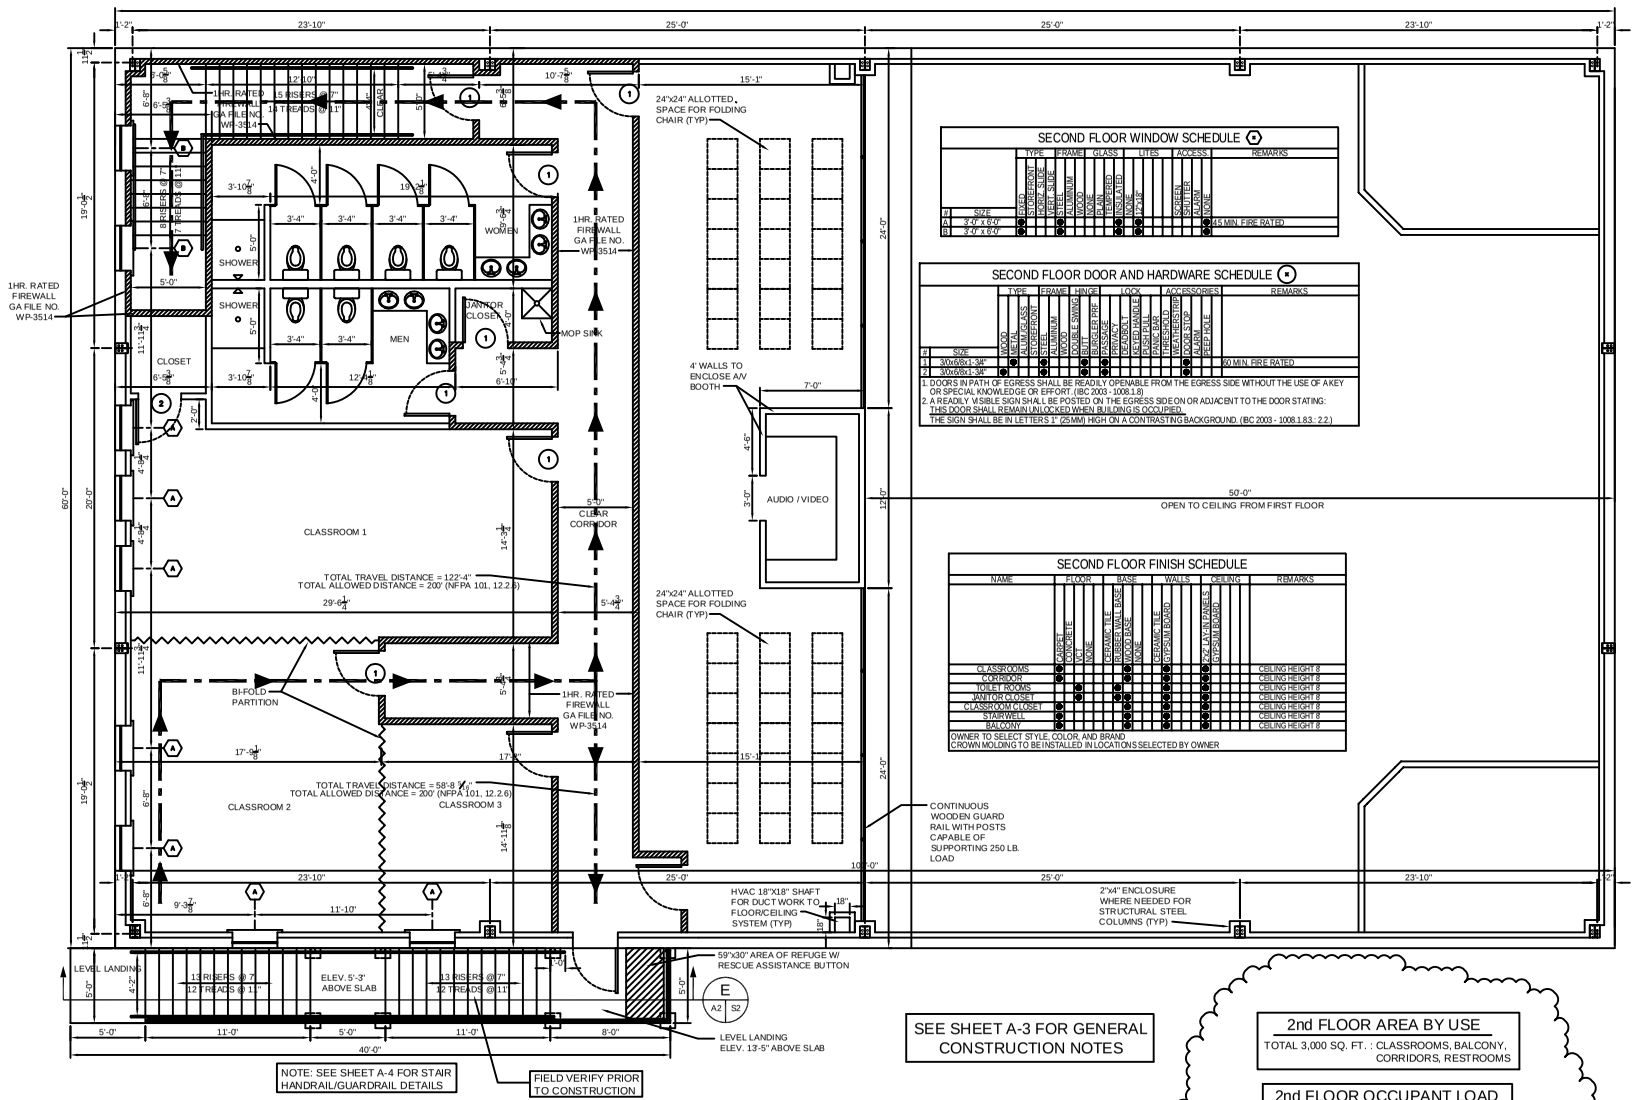

SECOND FLOOR WINDOW SCHEDULE

#	SIZE	TYPE	FRAME	GLASS	LITES	ACCESS.	REMARKS

SECOND FLOOR DOOR AND HARDWARE SCHEDULE

#	SIZE	TYPE: WOOD	TYPE: METAL	TYPE: ALUM.GLASS	TYPE: STORE-FRONT	FRAME: ALUMINUM	FRAME: WOOD	HINGE: CABLE SWING	HINGE: BUTT	LOCK: BURGLER PRF	LOCK: PASSAGE	LOCK: DEADBOLT	LOCK: KEYED HANDLE	ACCESSORIES: PUSH PLATE	ACCESSORIES: THRESHOLD	ACCESSORIES: WEATHERSTRIP	ACCESSORIES: ALARM STOP	ACCESSORIES: PEEP HOLE	REMARKS
1	3'0x6'8x1-3/4"	●					●		●		●		●						60 MIN. FIRE RATED
2	3'0x6'8x1-3/4"	●					●		●		●		●						

1. DOORS IN PATH OF EGRESS SHALL BE READILY OPENABLE FROM THE EGRESS SIDE WITHOUT THE USE OF A KEY OR SPECIAL KNOWLEDGE OR EFFORT. (IBC 2003 - 1008.1.8)
2. A READILY VISIBLE SIGN SHALL BE POSTED ON THE EGRESS SIDE ON OR ADJACENT TO THE DOOR STATING: THIS DOOR SHALL REMAIN UNLOCKED WHEN BUILDING IS OCCUPIED. THE SIGN SHALL BE IN LETTERS 1" (25MM) HIGH ON A CONTRASTING BACKGROUND. (IBC 2003 - 1008.1.8.3 : 2.2.)

SECOND FLOOR FINISH SCHEDULE

NAME	FLOOR: CARPET	FLOOR: CONCRETE	FLOOR: VCT	FLOOR: NONE	BASE: CERAMIC TILE	BASE: RUBBER WALL BASE	BASE: WOOD BASE	BASE: NONE	WALLS: CERAMIC TILE	WALLS: GYPSUM BOARD	CEILING: ACT LAY-IN PANELS	CEILING: GYPSUM BOARD	REMARKS
CLASSROOMS	●					●				●		●	CEILING HEIGHT 8'
CORRIDOR	●					●				●		●	CEILING HEIGHT 8'
TOILET ROOMS			●		●				●			●	CEILING HEIGHT 8'
JANITOR CLOSET			●					●		●		●	CEILING HEIGHT 8'
CLASSROOM CLOSET	●					●				●		●	CEILING HEIGHT 8'
STAIRWELL	●					●				●		●	CEILING HEIGHT 8'
BALCONY	●					●				●		●	CEILING HEIGHT 8'

OWNER TO SELECT STYLE, COLOR AND BRAND
CROWN MOLDING TO BE INSTALLED IN LOCATIONS SELECTED BY OWNER

SEE SHEET A-3 FOR GENERAL CONSTRUCTION NOTES

2nd FLOOR AREA BY USE

TOTAL 3,000 SQ. FT. : CLASSROOMS, BALCONY, CORRIDORS, RESTROOMS

2nd FLOOR OCCUPANT LOAD

1. OCCUPANCY CLASSIFICATION PER IBC 2003 (SECTION 303.1) ASSEMBLY GROUP: A-3
2. OCCUPANT LOADS ARE CALCULATED PER VALUES GIVEN BY NFPA 101, 2003. TABLE 7.3.1.2

EDUCATION AREA:
CLASSROOMS 1/2/3 = 884 NET SF = 45 OCC
BALCONY = 45 SEATS = 45 OCC
TOTAL 2nd FLOOR OCCUPANT LOAD = 90 OCC

2nd FLOOR PLAN
SCALE: 1/4"=1'-0"

DAMMON ENGINEERING, INC.
1095 FLORIDA AVENUE 985-649-5532 SLIDELL, LA. 70458
DAMMONENGINEERING.COM

EL-BETHEL PENTECOSTAL CHURCH

2nd FLOOR PLAN

EUGENE WELLINGTON
ALLEN ROAD
SLIDELL, LA 70458

SCALE:AS NOTE
FILE:
JOB NO. 1819
DATE: 3-29-07
SHEET 11

A-2

OF 22