


12

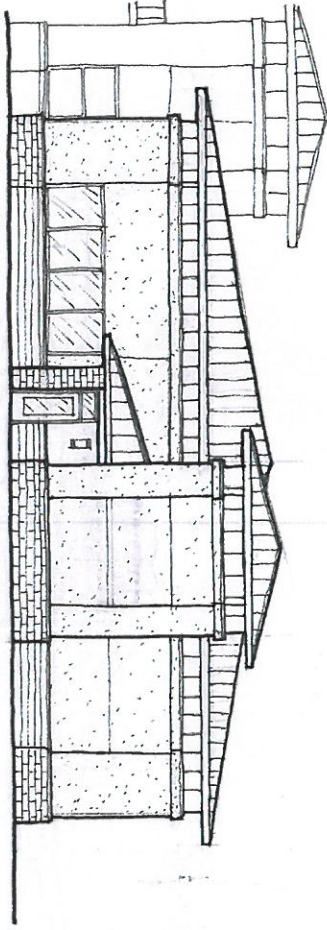


FRONT ELEVATION

1


1


1

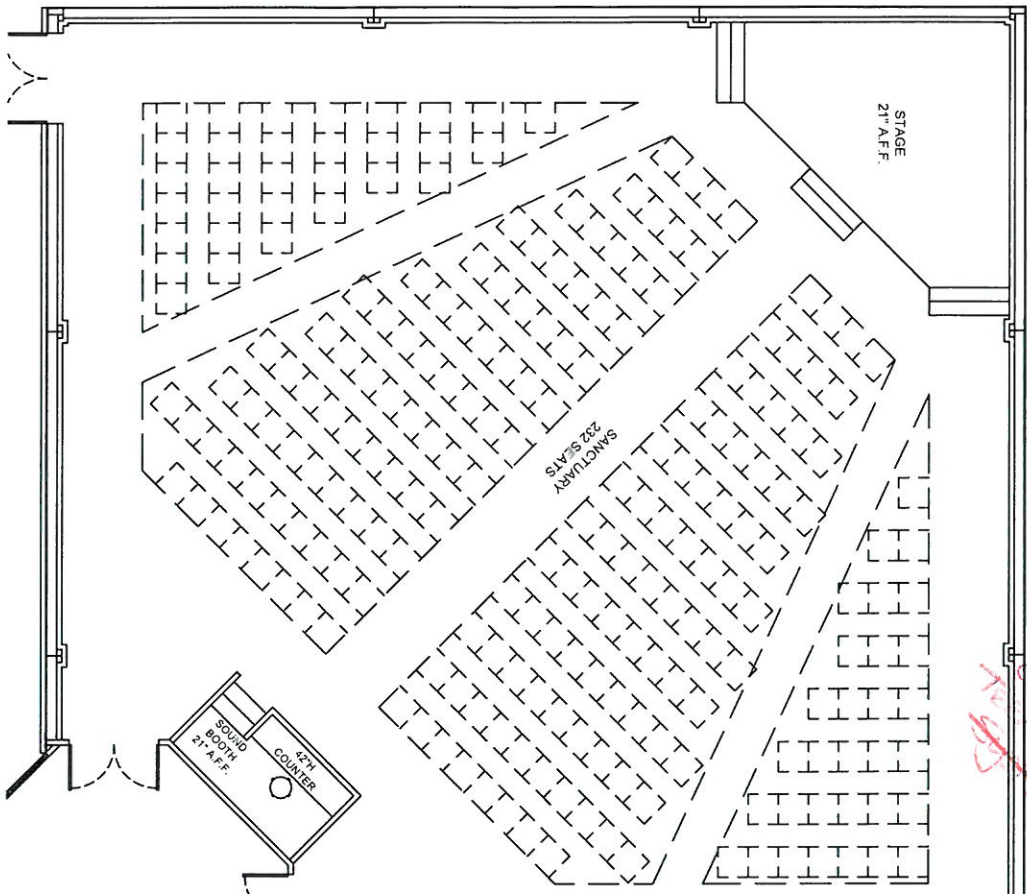

To NEW  
1000 sq. ft. DAILY  
CHILDREN'S  
TO NEW  
1000 sq. ft. DAILY  
CHILDREN'S

To NEW  
1/2 WELL  
FIELD LOCATE

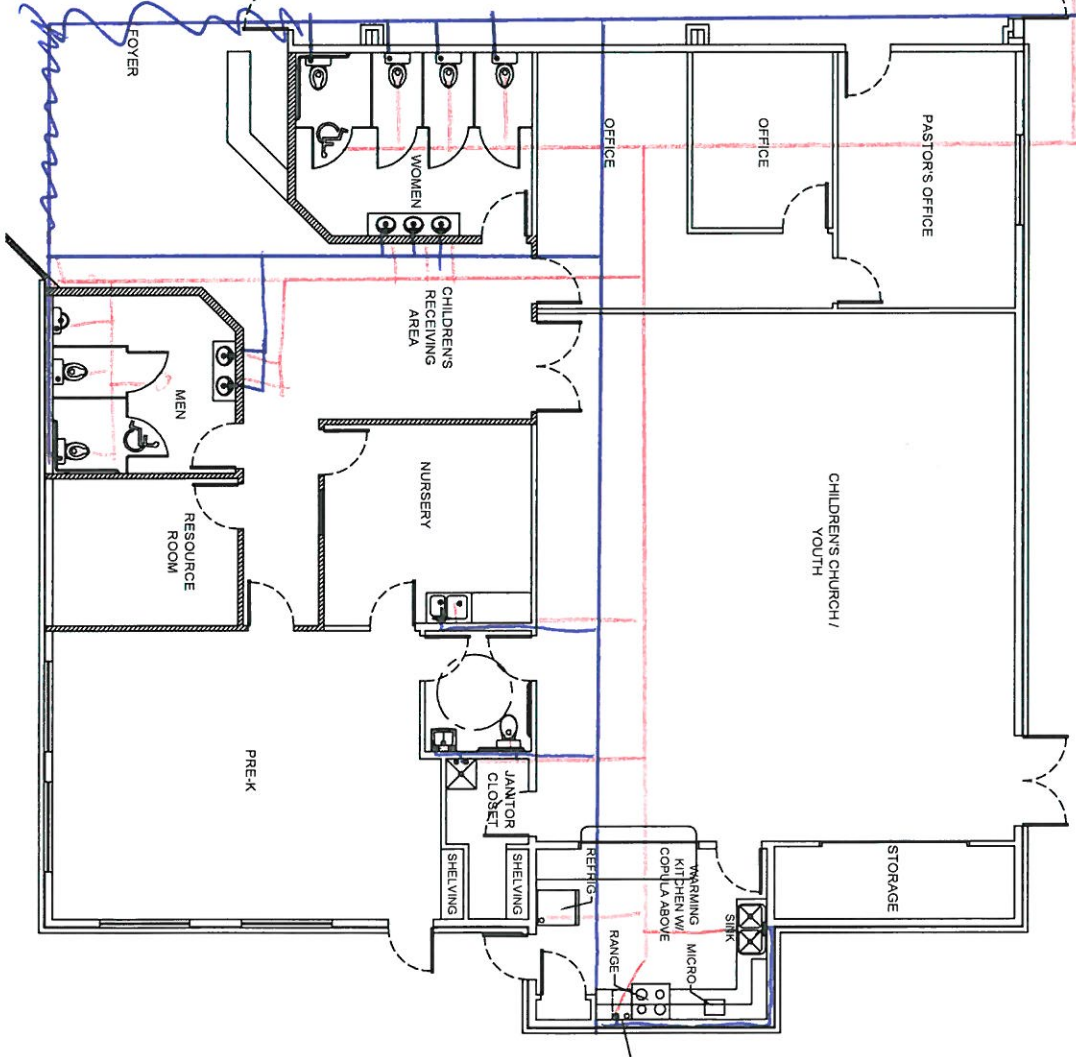

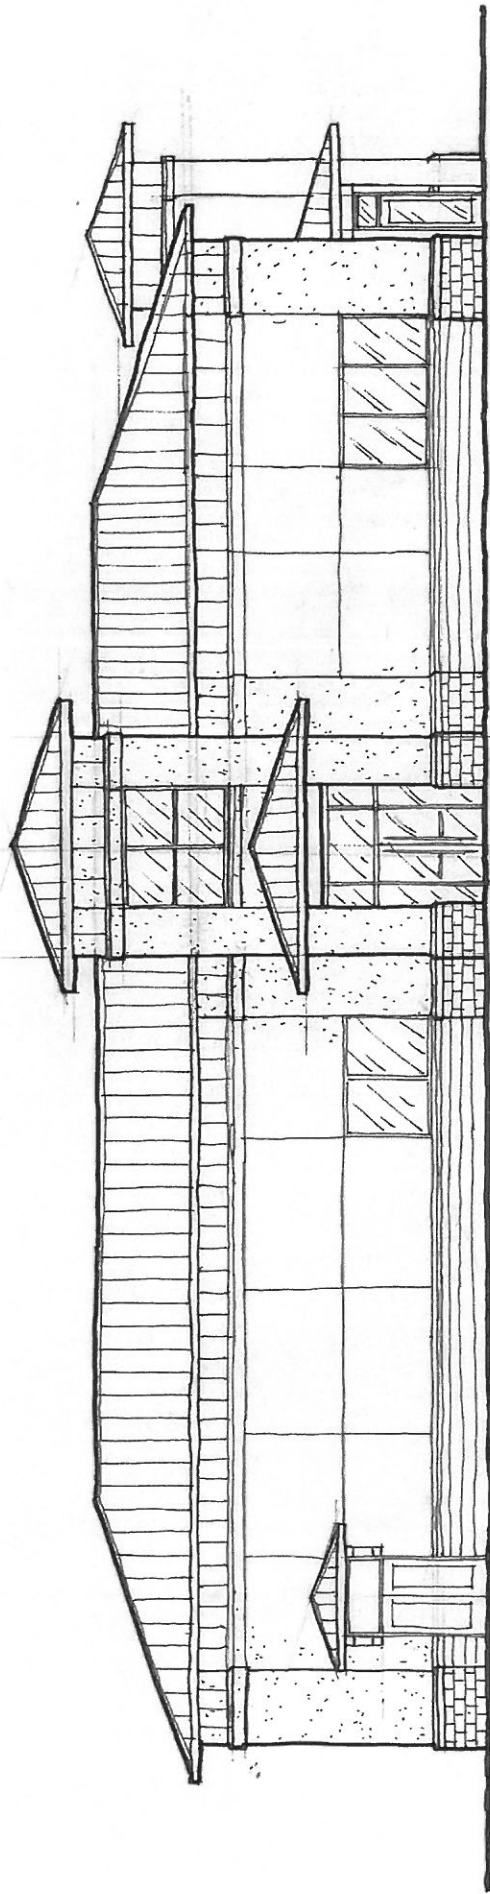

SCALE: 3/16" = 1'-0"

1 X 1