ROOM FINISH SCHEDULE

ROOM NUMBER	ROOM NAME	FLOOR MATERIAL	FLOOR COLOR	BASE MATERIAL	BASE COLOR	WALLS NORTH MATR'L	WALLS NORTH FINISH	WALLS NORTH COLOR	WALLS EAST MATR'L	WALLS EAST FINISH	WALLS EAST COLOR	WALLS SOUTH MATR'L	WALLS SOUTH FINISH	WALLS SOUTH COLOR	WALLS WEST MATR'L	WALLS WEST FINISH	WALLS WEST COLOR	CEILING MATERIAL	CEILING FINISH	CEILING COLOR	CEILING HEIGHT	REMARKS
101	SECRETARY	CPT	C1	RUB		GWB	PT		GWB	PT		GWB	PT		GWB	PT		ACP			9'-0"	
102	FOYER	CPT	C1 #2	RUB		GWB	PT		GWB	PT		GWB	PT		GWB	PT		ACP			10'-0"	
103	CLOSET	CPT	C1	RUB		GWB	PT		GWB	PT		GWB	PT		GWB	PT		ACP			9'-0"	
104	MEN	VCT		RUB		GWB	PT		GWB	PT		GWB	PT		GWB	PT		ACP			9'-0"	
105	WOMEN	VCT		RUB		GWB	PT		GWB	PT		GWB	PT		GWB	PT		ACP			9'-0"	
106	SANCTUARY	CPT	C2	WD		GWB	PT		GWB	PT		GWB	PT		GWB	PT		GWB	PT		12'-0"	
107	PLATFORM	CPT	C2	RUB		GWB	PT		GWB	PT		GWB	PT		GWB	PT		GWB	PT		12'-0"	
108	OFFICE	CPT	C2	RUB		GWB	PT		GWB	PT		GWB	PT		GWB	PT		ACP			9'-0"	
109	DRESSING	VCT		RUB		GWB	PT		GWB	PT		GWB	PT		GWB	PT		ACP			9'-0"	
110	BAPTISTRY	VCT		WD		GWB	PT		GWB	PT		GWB	PT		GWB	PT		GWB	PT		12'-0"	
111	CLOSET	CPT	C2	RUB		GWB	PT		GWB	PT		GWB	PT		GWB	PT		GWB	PT		12'-0"	

ROOM FINISH NOTES:

1. PROVIDE 5/8" MOISTURE RESISTANT GWB ON ALL RESTROOM WALL, BAPTISTRY WALLS & WALL BEHIND DRINKING FOUNTAINS.
2. COLOR & FINISH SELECTIONS OF ALL MATERIALS SHALL BE MADE BY OWNER/CHURCH INTERIORS.
3. ALL HOLLOW METAL DOORS & FRAMES SHALL BE SHOP PRIMED & FIELD PAINTED.
4. FINISH HARDWARE TO BE SELECTED BY OWNER.
5. PROVIDE SHELF & HANGING ROD IN CLOSETS 103 & 111.

ABBREVIATIONS

VCT VINYL COMPOSITION TILE
CPT CARPET
CONC. EXPOSED CONCRETE SLAB
GWB GYPSUM WALL BOARD
PT PAINT
UNFIN UNFINISHED
EXP EXPOSED STRUCTURE
RUB RUBBER
WD WOOD
ACP ACOUSTICAL CEILING PANELS

GA FILE NO. FC 5406
GENERIC

BASE LAYER 5/8" TYPE X GYPSUM WALLBOARD APPLIED AT RIGHT ANGLES TO 2x10 WOOD JOISTS 24" O.C. WITH 1-1/4" TYPE W OR S DRYWALL SCREWS 24" O.C. – FACE LAYER 5/8" TYPE X GYPSUM WALLBOARD OR GYPSUM VENEER BASE APPLIED AT RIGHT ANGLES TO JOISTS WITH 1-7/8" TYPE S DRYWALL SCREWS 12" O.C. AT JOINTS AND INTERMEDIATE JOISTS AND 1-1/2" TYPE G DRYWALL SCREWS 12" O.C. PLACED 2" BACK ON EITHER SIDE OF END JOINTS. JOINTS OFFSET 24" FROM BASE LAYER JOINTS. WOOD JOISTS SUPPORTING 1/2" PLYWOOD WITH EXTERIOR GLUE APPLIED AT RIGHT ANGLE TO JOISTS WITH 8D NAILS. CEILING PROVIDES ONE HOUR FIRE RESISTANCE PROTECTION FOR WOOD FRAMING, INCLUDING TRUSSES.

1 HOUR FIRE 35 TO 39 STC SOUND

APPROX. WEIGHT: 5 PSF
FIRE TEST: FM FC 172, 2-25-72
SOUND TEST: ESTIMATED

GA FILE NO. WP 3644 GENERIC

GYPSUM WALLBOARD, WOOD STUDS, MINERAL FIBER INSULATION

ONE LAYER ⅝" TYPE X GYPSUM WALLBOARD APPLIED AT RIGHT ANGLES TO EACH SIDE OF 2X4 WOOD STUDS 16" O.C. WITH 2 ¼" TYPE S OR W DRYWALL SCREWS 12" O.C. 3 ½" MINERAL FIBER INSULATION, NOMINAL 2.5 PCF, FRICTION FIT IN STUD SPACE.

VERTICAL JOINTS STAGGERED 16" O.C., HORIZONTAL JOINTS STAGGERED 24" O.C., ON OPPOSITE SIDES.

TESTED AT 2,578 LBS PER STUD OR 100 PERCENT OF DESIGN LOAD. (LOAD-BEARING)

1 HOUR FIRE

THICKNESS: 4 ¾"
APPROX. WEIGHT: 7 ½" PSF
FIRE TEST: ITS J20-06170.1, 4-00

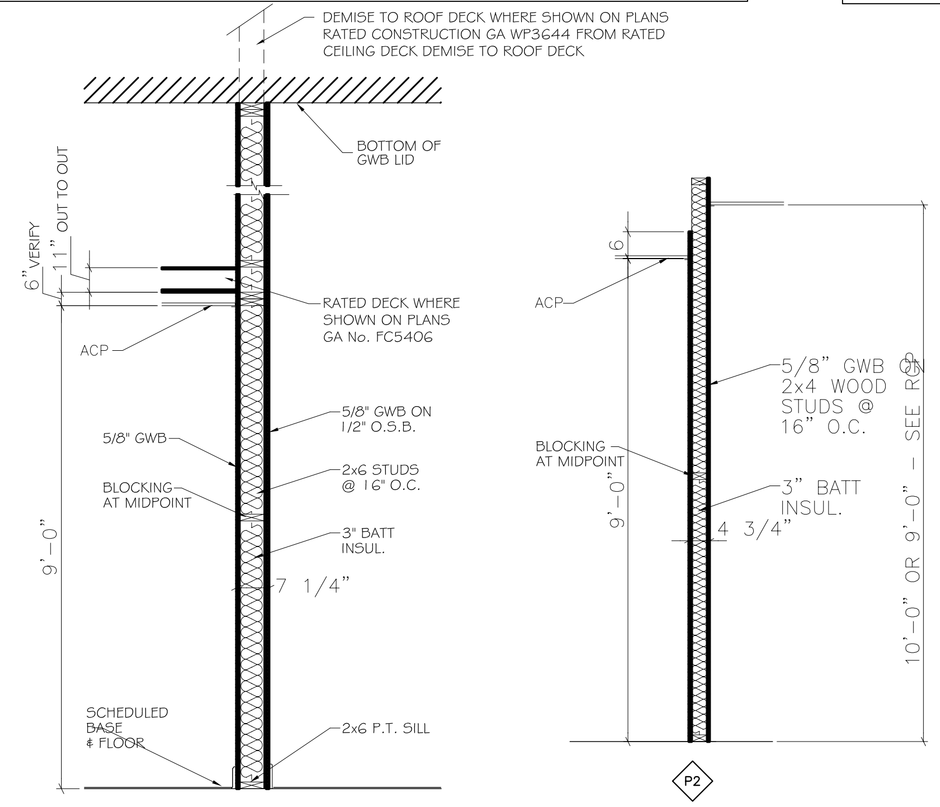

PARTITION TYPES

SCALE 1/2" = 1'-0"

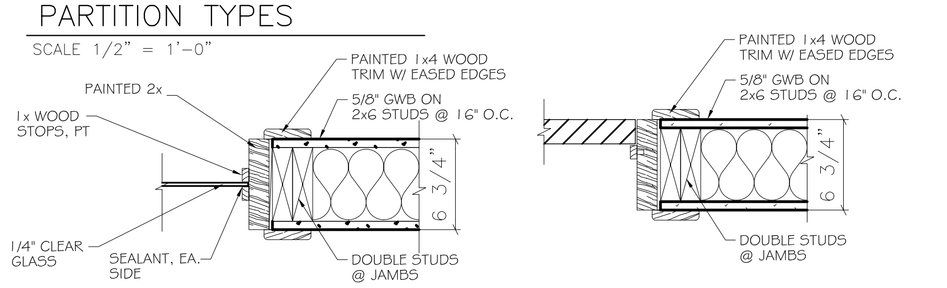

JAMB DETAIL 2 A1.1
SCALE 1 1/2" = 1'-0"

JAMB DETAIL 3 A1.1
SCALE 1 1/2" = 1'-0"

DETAILED BUILDING REQUIREMENTS
(MAIN WIND FORCE RESISTING COMPONENTS)

- ROOF COVERING HAS BEEN DESIGNED IN ACCORDANCE WITH THE REQUIRMENTS SET FORTH IN IBC SECTION 1507
- 7/16" THICK STRUCTURAL WOOD PANELS AND ATTACHMENT HARDWARE SHALL BE PROVIDED FOR THE BUILDING. THE PANELS SHALL BE NUMBERED FOR EACH GLAZED OPENING AND SHALL BE STORED ON SITE PERMANENTLY.

CONTRACTOR NOTE!
EACH CONTRACTOR RESPONSIBLE FOR THE CONSTRUCTION OF A MAIN WIND-FORCE-RESISTING COMPONENT OF THIS BUILDING SHALL SUBMIT A A WRITTEN CONTRACTOR'S STATEMENT OF RESPONSIBILITY TO THE BUILDING OFFICIAL AND OWNER PRIOR TO COMMENCEMENT OF THE WORK ON THAT COMPONENT. (IBC 1706.3)

MAXIMUM OCCUPANCY SIGNS WILL BE DISPLAYED AD DESIGNATED LOCATION	
S1	MAXIMUM OCCUPANCY - 133 PERSONS
S2	MAXIMUM OCCUPANCY - 43 PERSONS

TOILET ACCESSORIES

ITEM	DESCRIPTION	BOBRICK NO.
A	SEMI-RECESSED PAPER TOWEL DISPENSER	B-2621
B	18" x 36" WALL HUNG MIRROR	B-165 1824
C	TOILET PAPER DISPENSER	B-2470
D	GRAB BARS	B-5806.99x36 B-5806.99x42
E	SOAP DISPENSER	B-155

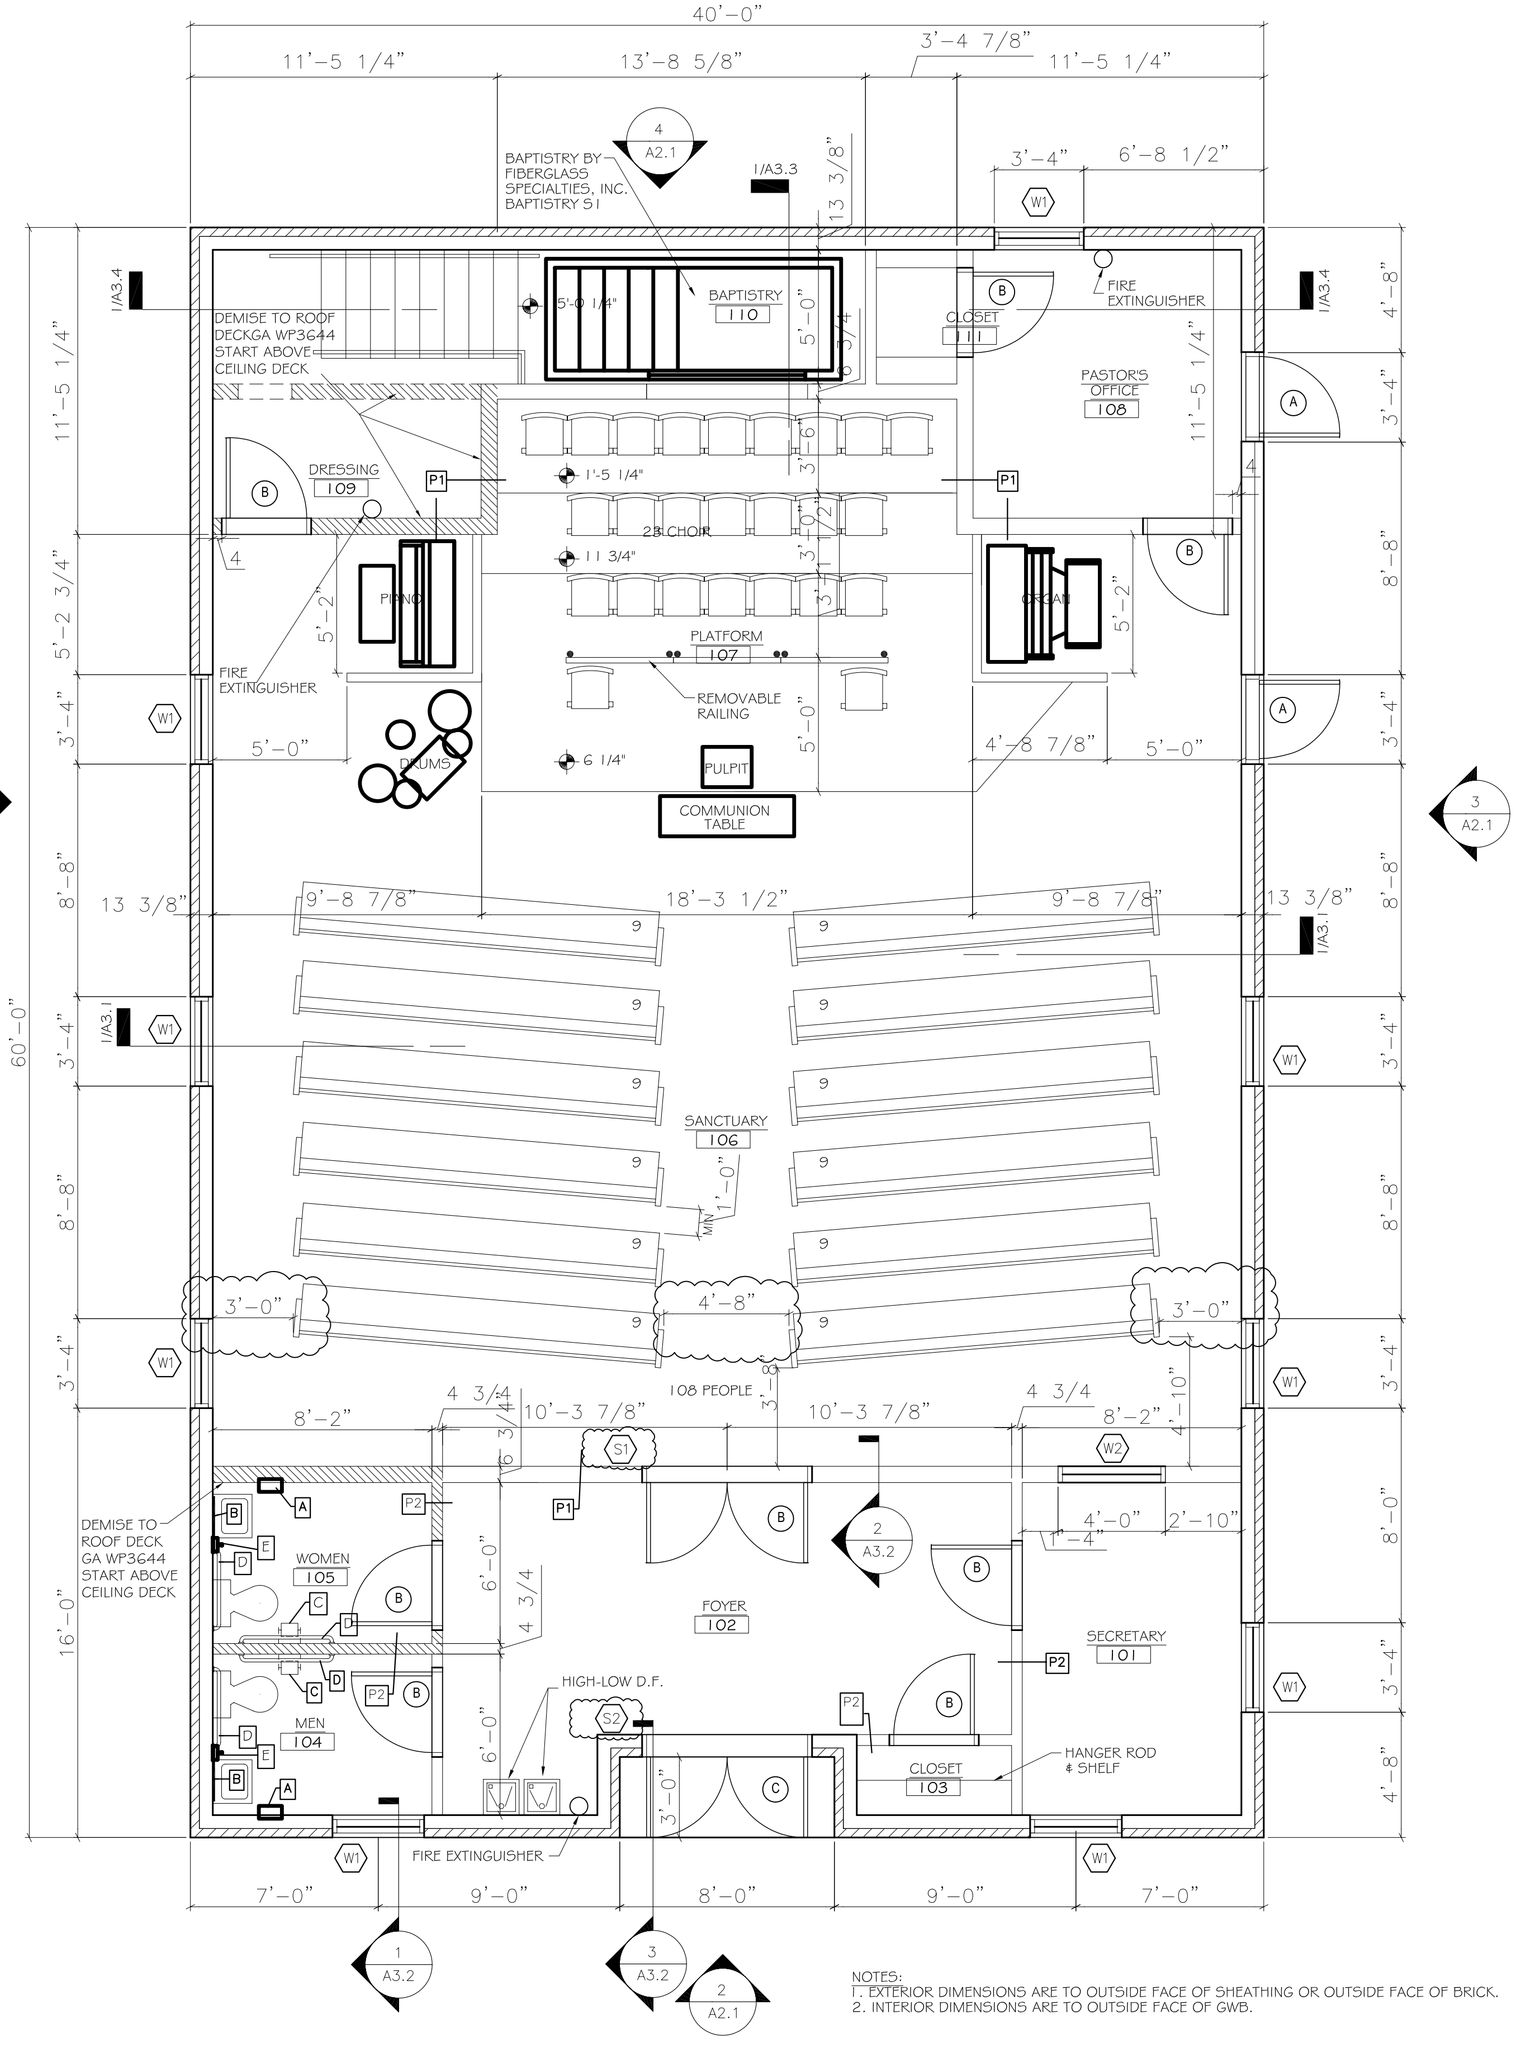

NOTES:
1. EXTERIOR DIMENSIONS ARE TO OUTSIDE FACE OF SHEATHING OR OUTSIDE FACE OF BRICK.
2. INTERIOR DIMENSIONS ARE TO OUTSIDE FACE OF GWB.

FLOOR PLAN 1 A1.1

SCALE: 1/4"=1'-0"

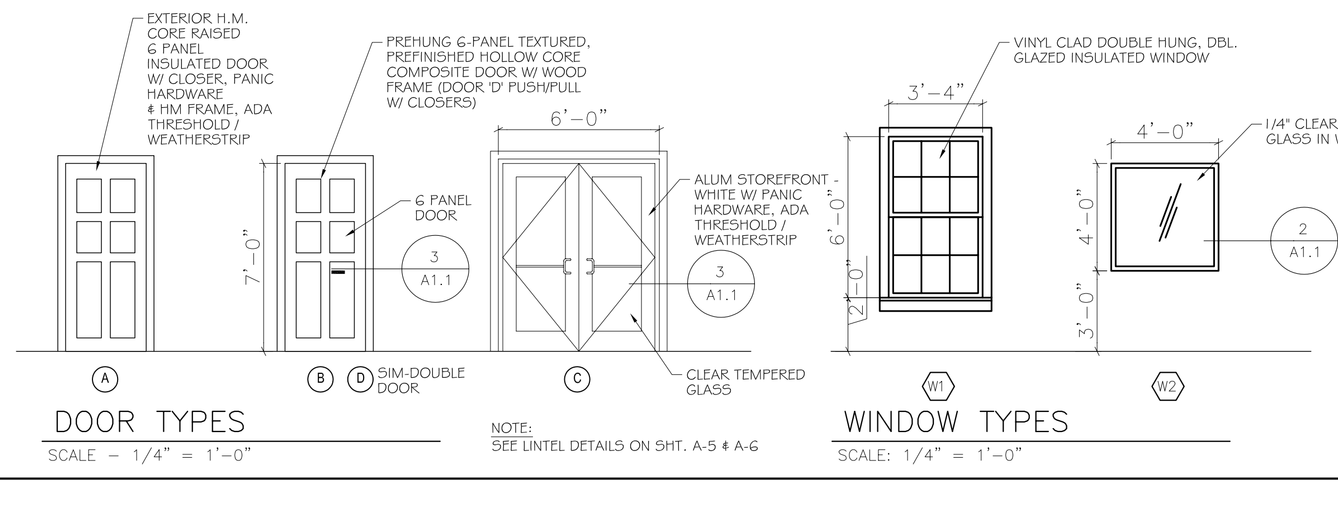

DOOR TYPES

SCALE – 1/4" = 1'-0"

NOTE:
SEE LINTEL DETAILS ON SHT. A-5 & A-6

WINDOW TYPES

SCALE: 1/4" = 1'-0"

WINDOW SCHEDULE (X)

WINDOW	TYPE: FIXED	S. HUNG	D. HUNG	HORZ. SLIDE	FRAME: ALUMINUM	WOOD	GLASS: GLAZED	PLAIN	TEMPERED	WIREGLASS	LITES: NONE	2/2	2/4	6/6	8/8	ACCESSORIES: INSULATED	ALARM	SCREEN	SHUTTER	NONE	REMARKS
W1 3/4x6/0	O		O			O		O			O					O					
W2 4/0x4/0	O					O			O		O								O		

DAMMON ENGINEERING, INC.
EMMETT DAMMON

ARCHITECT
ROBERT WILTSE

1095 FLORIDA AVENUE
SLIDELL, LA. 70458
985-649-5832

WEBSITE:
WWW.DAMMONENGINEERING.COM

EMAIL:
DAMMONENG@BELLSOUTH.NET

ARCHITECTURE
ENGINEERING
STUDIES
PLANNING
INVESTIGATION
EXPERT WITNESS

NEW BAPTIST CHURCH

BEULAH LAND
BAPTIST CHURCH
2436 ST. MAURICE AVE.
NEW ORLEANS, LA

FLOOR PLAN

REV: 2/4/08

SCALE: AS NOTED
JOB#: 1910
DATE: 12-14-07
SHEET 5

A-1

OF 20

THESE PLANS HAVE BEEN PREPARED UNDER MY DIRECT SUPERVISION, AND TO THE BEST OF MY KNOWLEDGE AND BELIEF, COMPLY WITH ALL THE BUILDING CODES OF THE CITY OF NEW ORLEANS, AS WELL AS STATE AND NATIONAL CODES. I AM NOT SUPERVISING THE WORK.

ROBERT WILTSE