


376923  
 REVIEWED FOR  
 STATE FIRE MARSHAL  
 AS PER REVIEW LETTER  
 BY: WILLIAM D. JONES, ARCHITECT, CBA  
*William D. Jones*

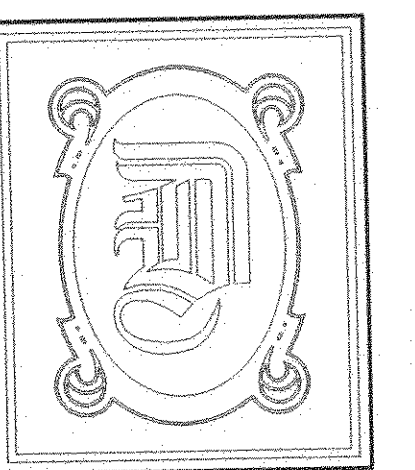

**DAMMON  
 ENGINEERING, INC.**

CHIEF ENGINEER  
 EMMETT  
 DAMMON, P.E.

CHIEF ARCHITECT  
 ROBERT  
 WILTSE

1095 FLORIDA AVENUE  
 SLIDELL, LA. 70458  
 OFFICE: 985-649-5832  
 FAX: 985-641-5950

WEBSITE:  
 WWW.DAMMONENGINEERING.COM


EMAIL:  
 DAMMONENG@BELLSOUTH.NET

- ARCHITECTURE
- ENGINEERING
- STUDIES
- PLANNING
- INVESTIGATION
- EXPERT WITNESS

NEW  
 CHURCH

TABERNACLE  
 BAPTIST CHURCH  
 2445 FOURTH AVE.  
 SLIDELL, LA

CHURCH  
 ELEVATIONS

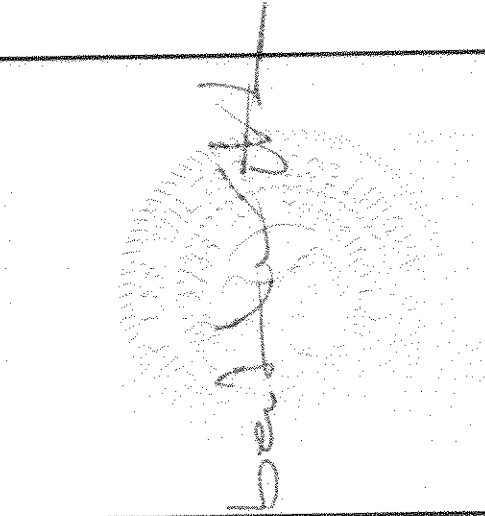

REV: *[Signature]*

SCALE: AS NOTED

JOB#: 2050

DATE: 2-8-10

SHEET 14

A-3