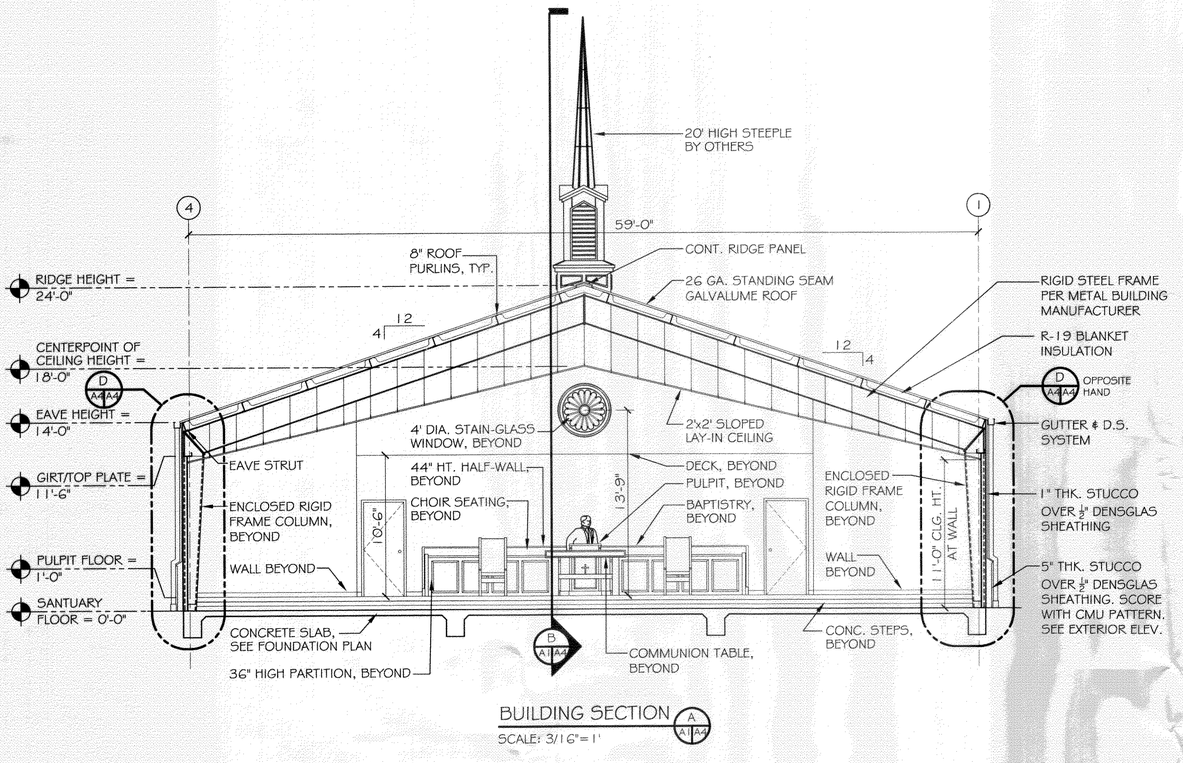

BUILDING SECTION A/A1A4
SCALE: 3/16"=1'

EXTERIOR STUCCO SPECIFICATIONS:

1. COMPLY WITH ASTM C-841 AND C-842. PROVIDE ¾" OVERALL THICKNESS ON SELF-FURRING DIAMOND MESH GALVANIZED METAL LATH, 3.4 LB. PER SQUARE YARD, ON "TYVEK" STUCCO WRAP. ATTACH LATH AT "DIMPLES" ONLY, WITH NON-CORROSIVE SCREWS.
2. METAL LATH AND ALL ACCESSORIES TO BE EQUAL TO "AMICO", TO INCLUDE CORNER BEADS, CASING BEADS, BASE SCREEDS AND CONTROL JOINTS, ALL INSTALLED WITH NON-CORROSIVE SCREWS. ALL ACCESSORIES TO BE ZINC. ALL CORNERS TO BE MITERED.
3. STUCCO TO BE INSTALLED IN THREE COATS; SCRATCH, BROWN AND FINISH. FINISH COAT TO BE ORIENTAL STUCCO WITH SAND FLOAT FINISH BY U.S. GYPSUM.
4. COMPLY WITH MANUFACTURER'S AND INDUSTRY RECOMMENDATIONS. INSTALL LATH IN ACCORDANCE WITH ASTM C-1063.
5. SUBMIT DATA / CUT SHEETS FOR ALL ITEMS IF REQUIRED.

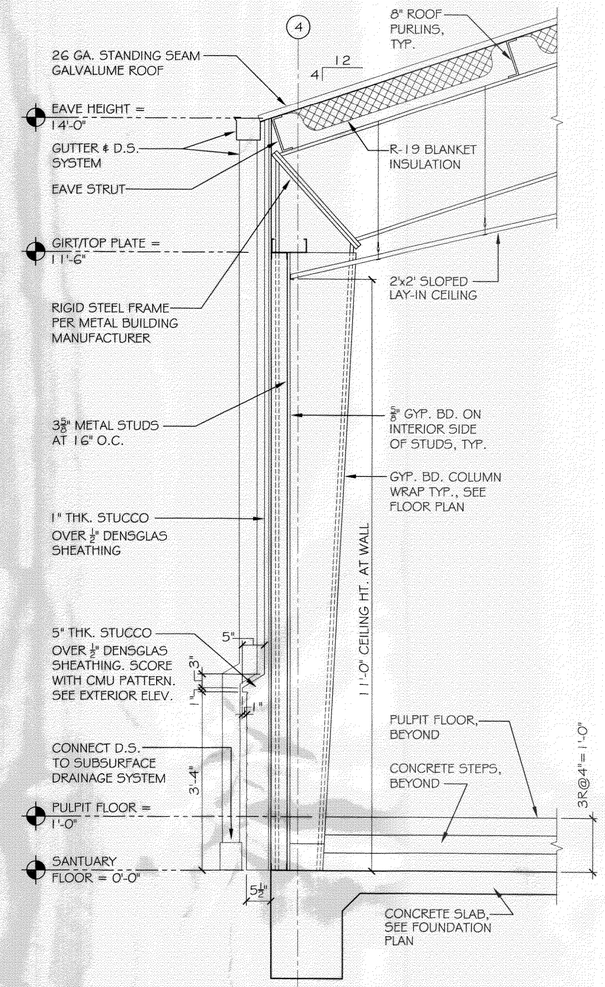

WALL SECTION D/A4A4
SCALE: 3/4"=1'

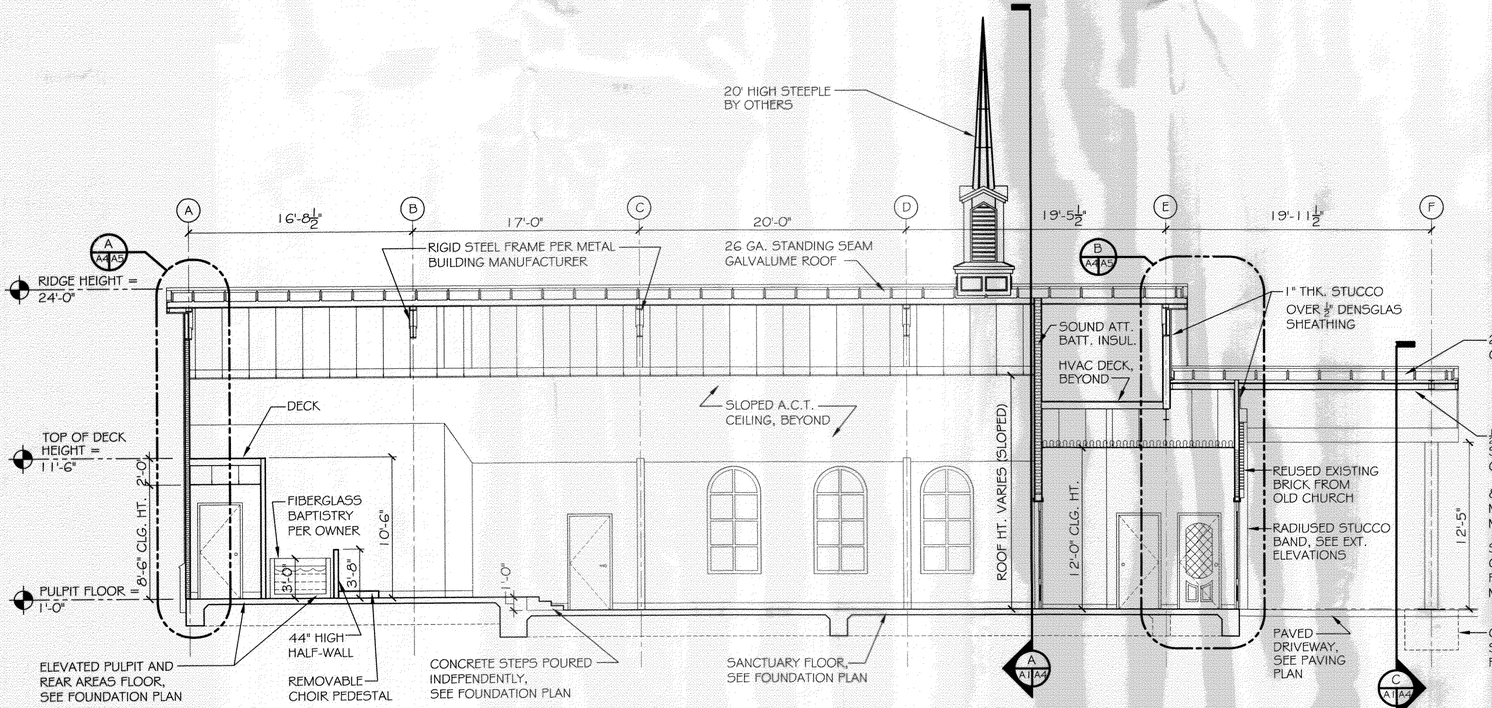

BUILDING SECTION B/A1A4
SCALE: 3/16"=1'

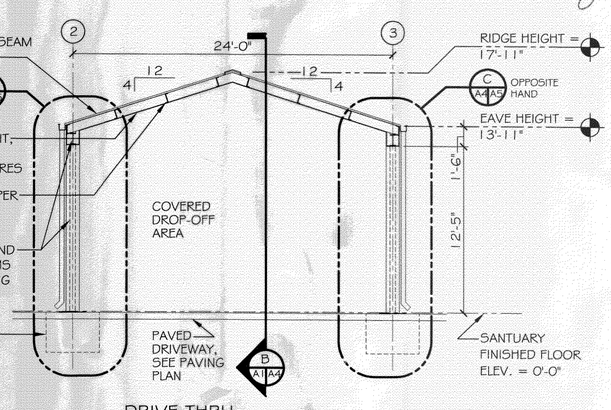

DRIVE-THRU CANOPY SECTION C/A1A4
SCALE: 3/16"=1'

376923
REVIEWED FOR STATE FIRE MARSHAL AS PER REVIEW LETTER
BY: WILLIAM D. JONES, ARCHITECT, CBO

DAMMON ENGINEERING, INC.

CHIEF ENGINEER
EMMETT DAMMON, P.E.

CHIEF ARCHITECT
ROBERT WILTSE

1095 FLORIDA AVENUE
SLIDELL, LA. 70458
OFFICE: 985-649-5832
FAX: 985-641-5950

WEBSITE:
WWW.DAMMONENGINEERING.COM

EMAIL:
DAMMONENG@BELLSOUTH.NET

ARCHITECTURE
ENGINEERING
STUDIES
PLANNING
INVESTIGATION
EXPERT WITNESS

NEW CHURCH

TABERNACLE BAPTIST CHURCH
2445 FOURTH AVE.
SLIDELL, LA

BUILDING AND WALL SECTIONS

REV:

SCALE: AS NOTED
JOB#: 2050
DATE: 2-8-10
SHEET 15

A-4

OF 25