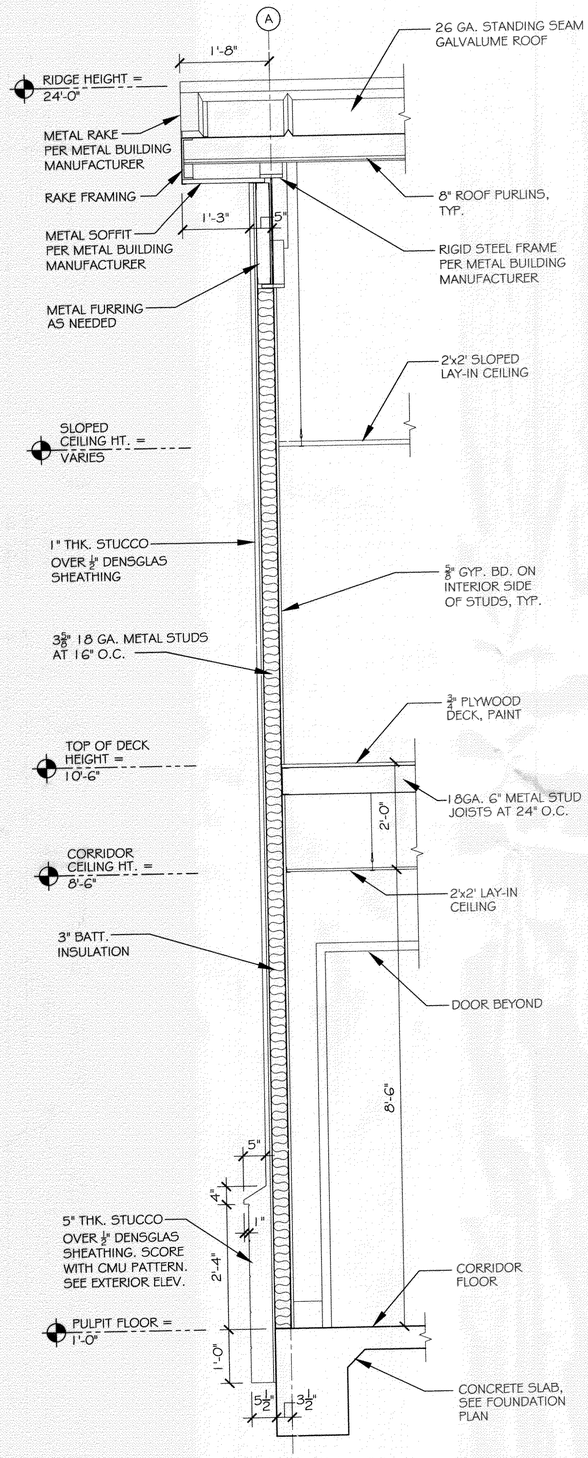

WALL SECTION (A / A4/A5)

SCALE: 3/4"=1'

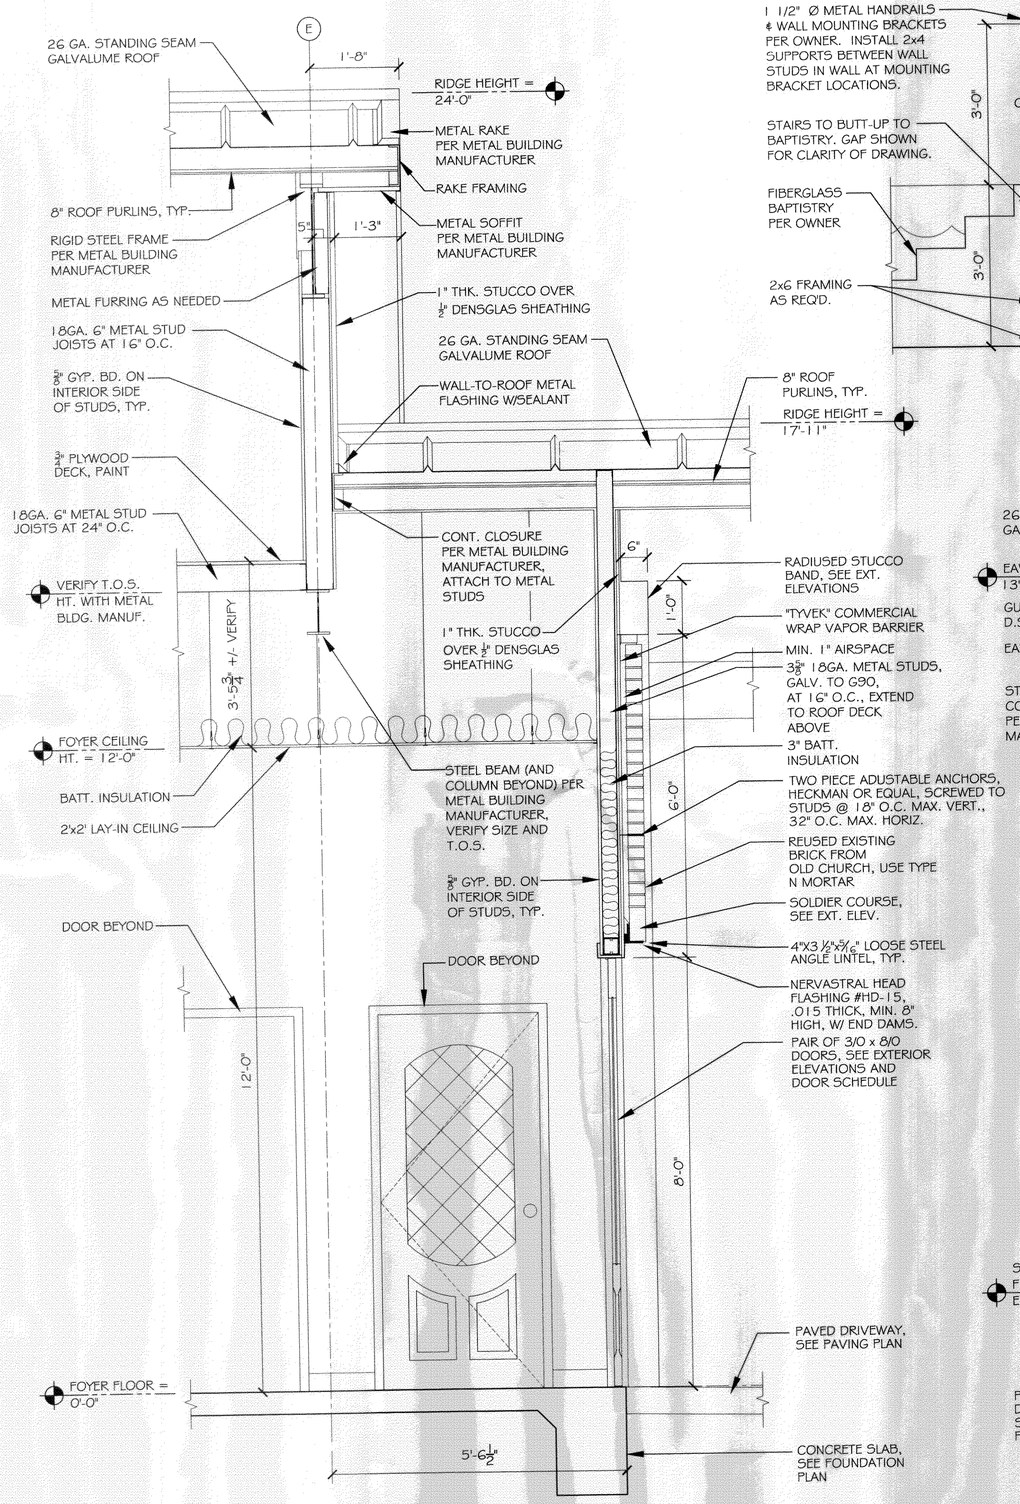

WALL SECTION (B / A4/A5)

SCALE: 3/4"=1'

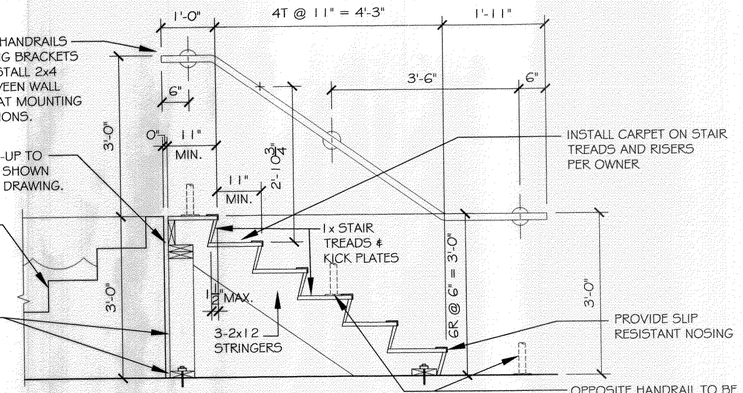

SECTION THRU BAPTISTRY STAIRS (D / A1/A5)

SCALE: 3/4"=1'

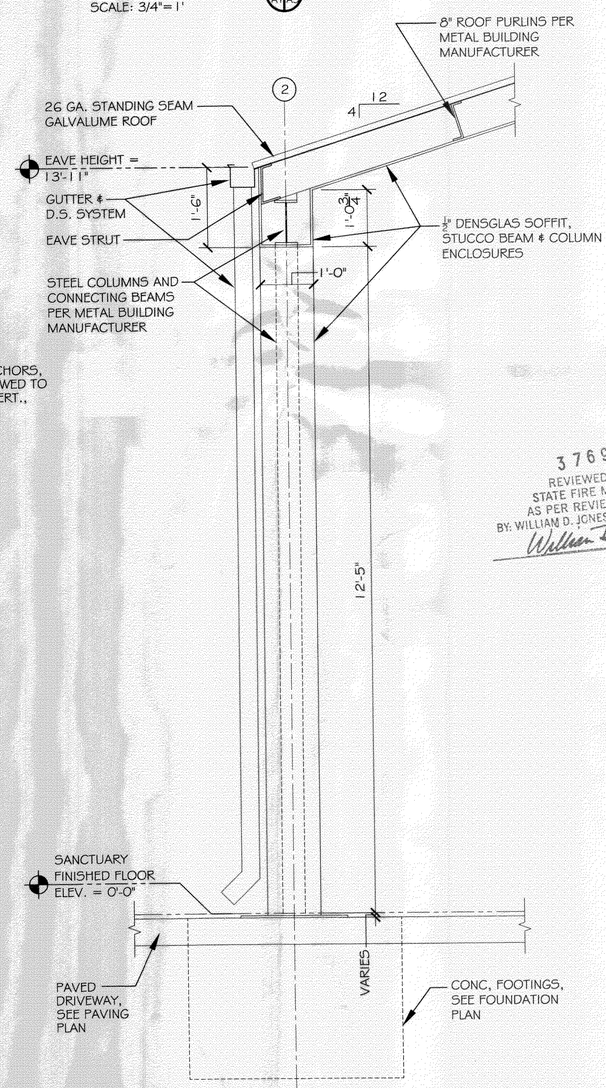

DRIVE-THRU CANOPY EAVE SECTION (C / A4/A5)

SCALE: 3/4"=1'

376923

REVIEWED FOR STATE FIRE MARSHAL AS PER REVIEW LETTER BY: WILLIAM D. JONES, ARCHITECT, CBO

DAMMON ENGINEERING, INC.

CHIEF ENGINEER
EMMETT DAMMON, P.E.

CHIEF ARCHITECT
ROBERT WILTSE

1095 FLORIDA AVENUE
SLIDELL, LA. 70458
OFFICE: 985-649-5832
FAX: 985-641-5950

WEBSITE: WWW.DAMMONENGINEERING.COM

EMAIL: DAMMONENG@BELLSOUTH.NET

ARCHITECTURE
ENGINEERING
STUDIES
PLANNING
INVESTIGATION
EXPERT WITNESS

NEW CHURCH

TABERNACLE BAPTIST CHURCH
2445 FOURTH AVE.
SLIDELL, LA

WALL SECTIONS

REV:

SCALE: AS NOTED
JOB#: 2050
DATE: 2-8-10
SHEET 16

A-5

OF 25