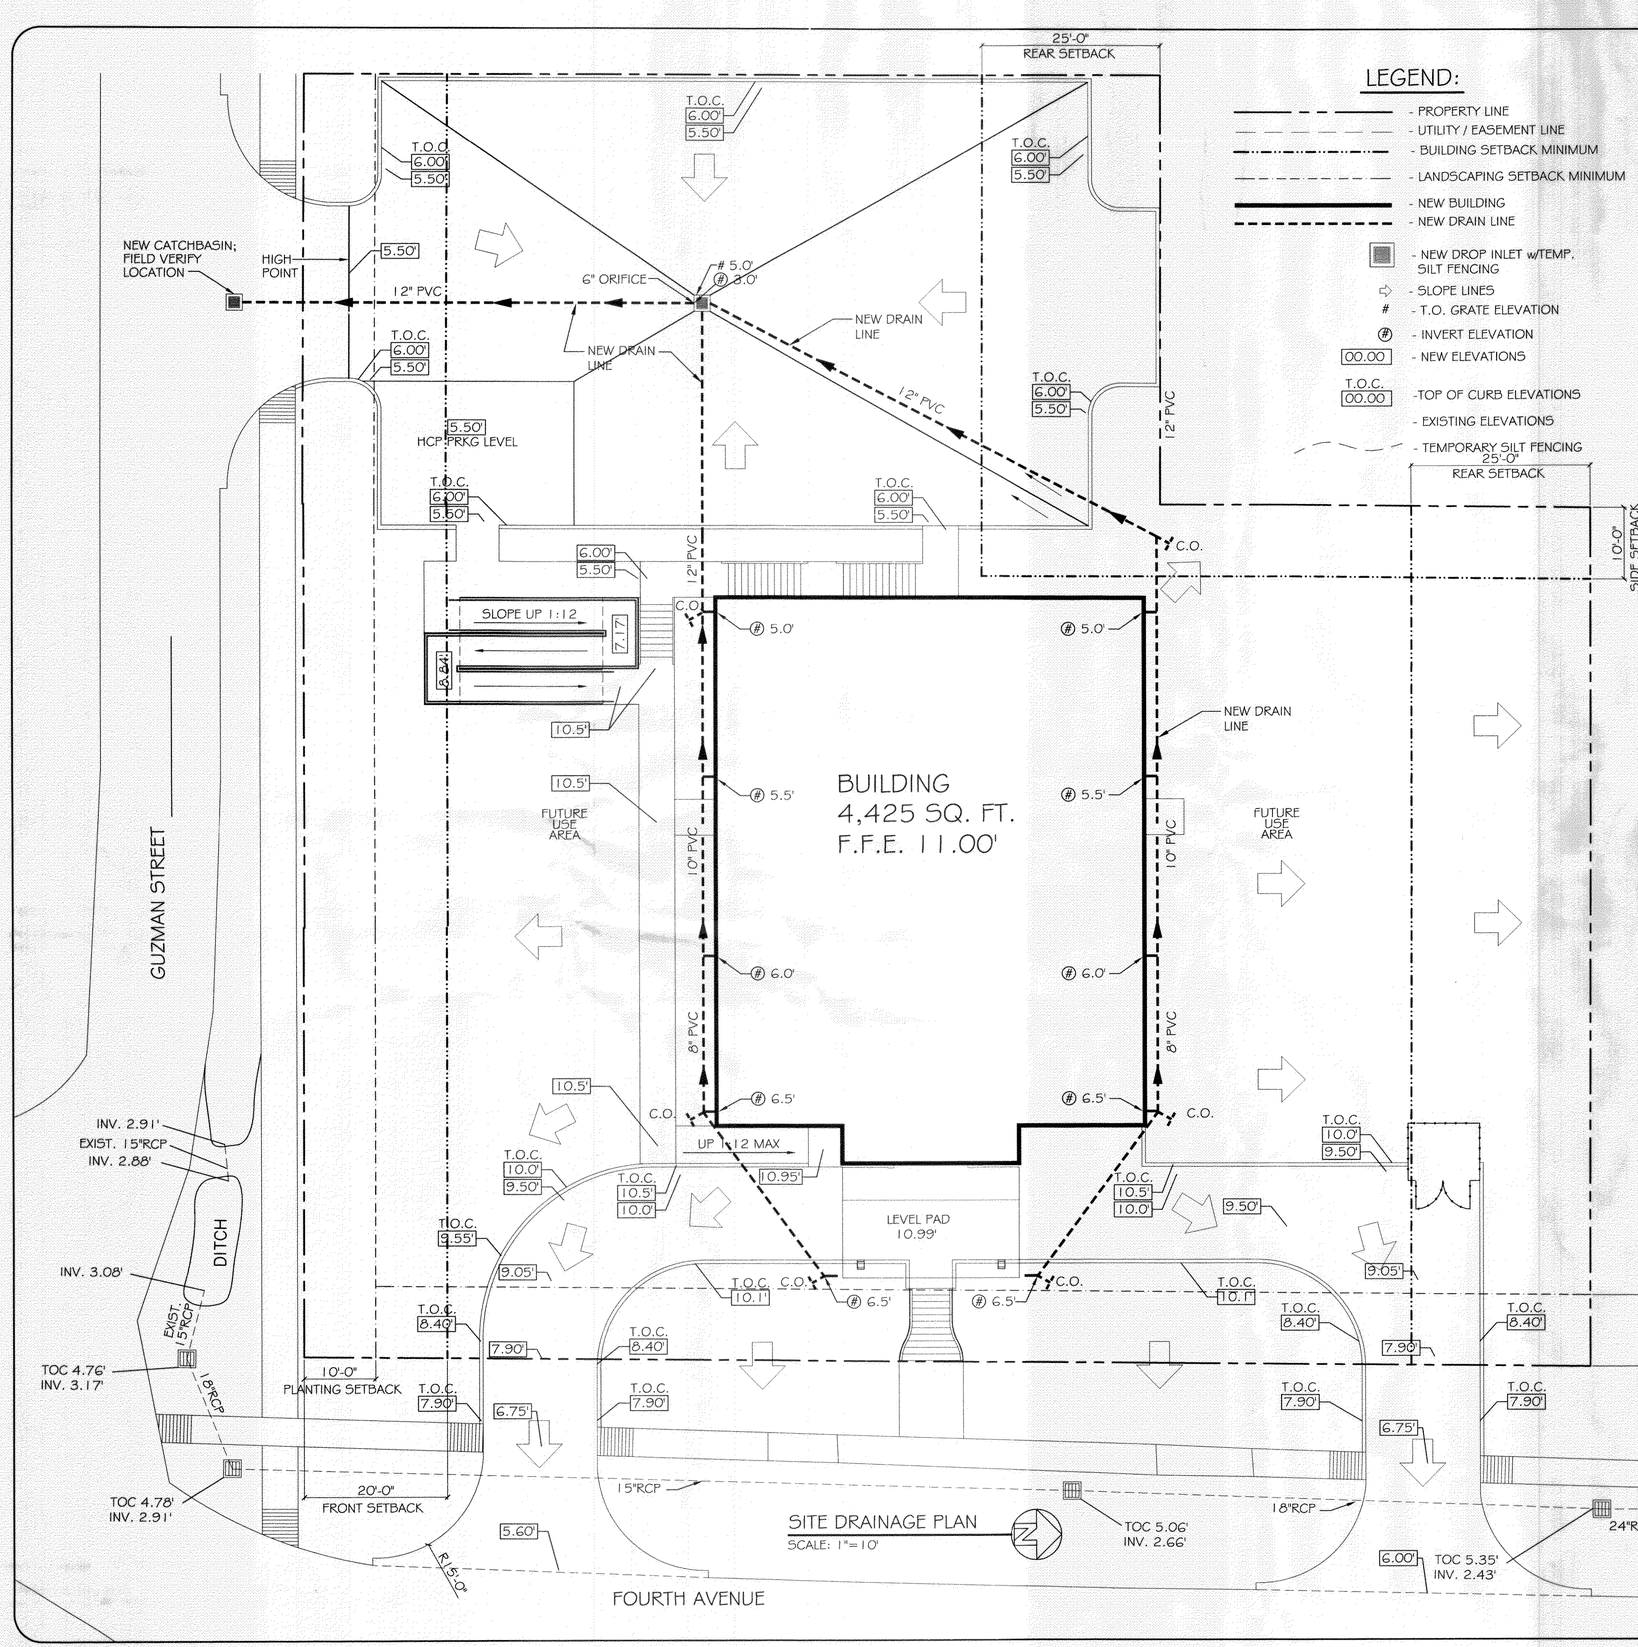

LEGEND:

- PROPERTY LINE
- UTILITY / EASEMENT LINE
- BUILDING SETBACK MINIMUM
- LANDSCAPING SETBACK MINIMUM
- NEW BUILDING
- NEW DRAIN LINE
- NEW DROP INLET w/TEMP. SILT FENCING
- SLOPE LINES
- # - T.O. GRATE ELEVATION
- (#) - INVERT ELEVATION
- 00.00 - NEW ELEVATIONS
- T.O.C. 00.00 - TOP OF CURB ELEVATIONS
- EXISTING ELEVATIONS
- TEMPORARY SILT FENCING

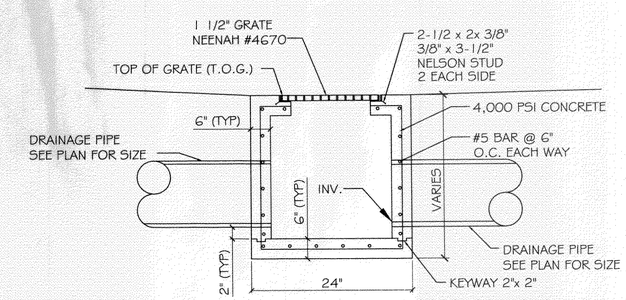

TYPICAL DROP INLET

N.T.S.

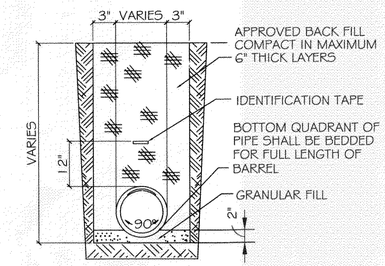

DRAIN PIPE BEDDING

N.T.S.

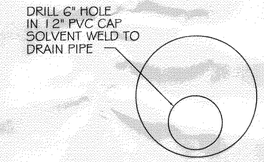

ORIFICE DETAIL

N.T.S.

B.O.C. 14.00'

376923

REVIEWED FOR
STATE FIRE MARSHAL
AS PER REVIEW LETTER
BY: WILLIAM D. JONES, ARCHITECT, CBO

GUTTERS AND DOWN SPOUTS TO BE SEAMLESS ALUMINUM 24 GAUGE, COLOR TO BE SELECTED BY OWNER. GUTTERS TO BE "OGEE" IN CROSS SECTION, MINIMUM 6" WIDTH.

NOTES:

1) DRAIN PIPE & FITTINGS WITHIN PROPERTY LINE SHALL BE POLYVINYL CHLORIDE PLASTIC PIPE, MEETING CLASS 100 C-900 PVC.
2) ELEVATIONS SHOWN ARE M.S.L.
3) FIELD VERIFY ALL ELEVATIONS AND DRAINAGE SYSTEM PLACEMENT PRIOR TO START OF WORK.
4) MUCK OUT 24" DEEP FOR FOUNDATION PAD MINIMUM, OR TO UNDISTURBED SOIL CAPABLE OF 1500 PSF BEARING.
5) DOWN SPOUTS SHALL FLOW INTO SUB-SURFACE DRAINAGE.
6) THERE IS NO EVIDENCE OF EXISTING OFF-SITE FLOW CROSSING THE PROPERTY. NEW DRAINAGE CALCULATIONS ARE DETERMINED ACCORDINGLY.

DAMMON
ENGINEERING, INC.

CHIEF ENGINEER
EMMETT
DAMMON, P.E.

CHIEF ARCHITECT
ROBERT
WILTSE

1095 FLORIDA AVENUE
SLIDELL, LA. 70458
OFFICE: 985-649-5832
FAX: 985-641-5950

WEBSITE:
WWW.DAMMONENGINEERING.COM

EMAIL:
DAMMONENG@BELLSOUTH.NET

ARCHITECTURE

ENGINEERING

STUDIES

PLANNING

INVESTIGATION

EXPERT WITNESS

NEW CHURCH

TABERNACLE
BAPTIST CHURCH
2445 FOURTH AVE.
SLIDELL, LA

SITE
DRAINAGE
PLAN

REV:

SCALE: AS NOTED

JOB#: 2050

DATE: 2-8-10

SHEET 6

C-5

OF 25