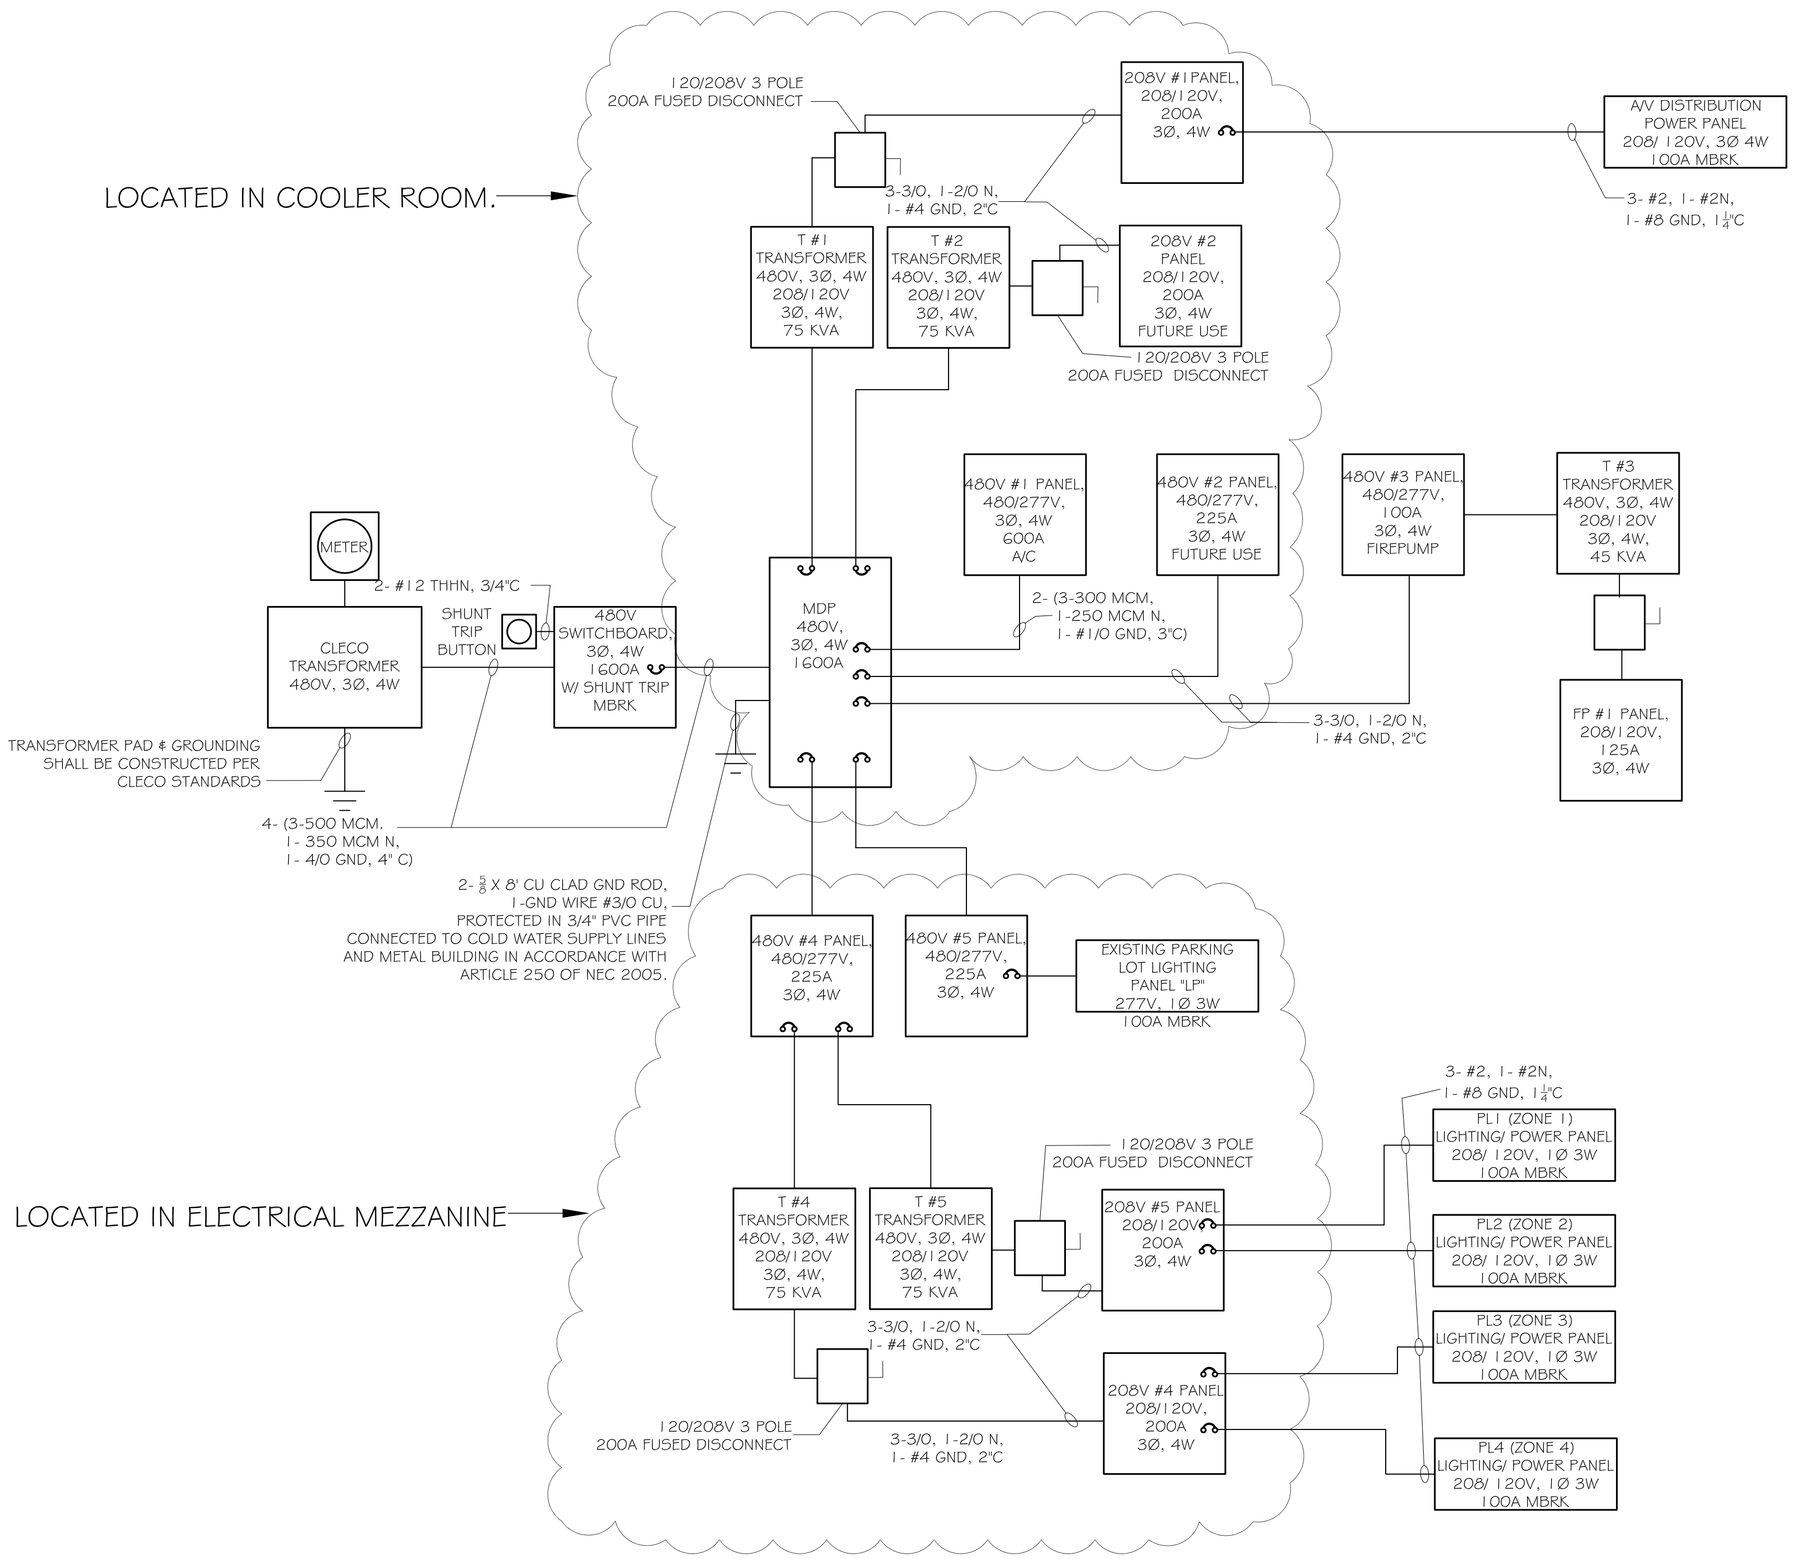

ELECTRICAL ONE LINE DIAGRAM

N.T.S.

GENERAL NOTES:

1. LOCATE SHUNT TRIP BUTTON NEAR CLECO TRANSFORMER. BUTTON SHALL BE MARKED AS "EMERGENCY TRIP". MOUNTED ON BUILDING WALL.
2. ALL INTERIOR WIRING SHALL BE TYPE THHN.
3. ALL EXTERIOR WIRING SHALL BE TYPE THWN.
4. ALL INTERIOR CONDUIT SHALL BE EMT. SEE DRAWINGS FOR SIZES.
5. ALL EXTERIOR CONDUIT SHALL BE GALVANIZED OR SCHED. 80 PVC. SEE DRAWINGS FOR SIZES.
6. CONTRACTOR SHALL SIZE EQUIPMENT CIRCUIT BREAKERS TO MATCH EQUIPMENT FURNISHED.
7. SERVICE ENTRANCE SHALL BE IDENTIFIED IN ACCORDANCE WITH 70:230.71¢70.
8. REMOVE WIRE AND ABANDON EXISTING SERVICE CONDUIT FROM EXISTING TRANSFORMER "A" SUPPLYING NEW PROJECT AREA.

DEMOLISH ALL EXISTING PANELS NOT BEING USED

EXISTING PANEL USAGE SCHEDULE- MAIN FLOOR			
PANEL	SERVICE FOR:	DISPOSITION	
HN	WAREHOUSE LIGHTS	IN USE	RM. 115
LZ	REFRIGERATOR/ FREEZER	ABANDONED	RM. 132
LH	MEN'S WASHROOM		RM. 126
CRM1	DIST. TO PNLS HG, LE, HE, HF, HH, HJ, LP, LN	IN USE	RM. 107
HN	LIGHTING CONTACTOR		RM. 113
HEN	LIGHTING CONTACTOR		RM. 113
HEW	LIGHTING CONTACTOR		RM. 113
"PN1"	OUTLETS		RM. 130
LP	PARKING LOT LIGHTING	IN USE	EXTERIOR- NW CORNER OF BLDG.

EXISTING PANEL USAGE SCHEDULE- AC/ ELEC. RM. 1		
PANEL	SERVICE FOR:	DISPOSITION
HS	CONDENSER, COMPACTOR	
HR	CONDENSER, EXHAUST FANS, REFRIGERATOR	
HAB-LT	STORE LIGHTS	
HX	LIGHTS	
HAB-RT	MAIN FLOOR OUTLETS	
LX	2ND FLOOR OUTLETS	
LD		

EXISTING PANEL USAGE SCHEDULE- AC/ ELEC. RM. 2		
PANEL	SERVICE FOR:	DISPOSITION
LW		
LH		
PH	WAREHOUSE EXHAUST	
HJ	WAREHOUSE FANS	
HH	WAREHOUSE HEATERS	
LG		
LF	PHARMACY OUTLETS	
HEW	LIGHTING CONTACTOR	
HE	RENTAL LIGHTS	
HF	HEATERS	
HP		ABANDONED

EXISTING PANEL USAGE SCHEDULE- 202 OFFICE		
PANEL	SERVICE FOR:	DISPOSITION
LU	COMPUTER OUTLETS	IN USE
LY	CASH REGISTERS	ABANDONED
LW	CHECKOUT CONVEYORS	ABANDONED

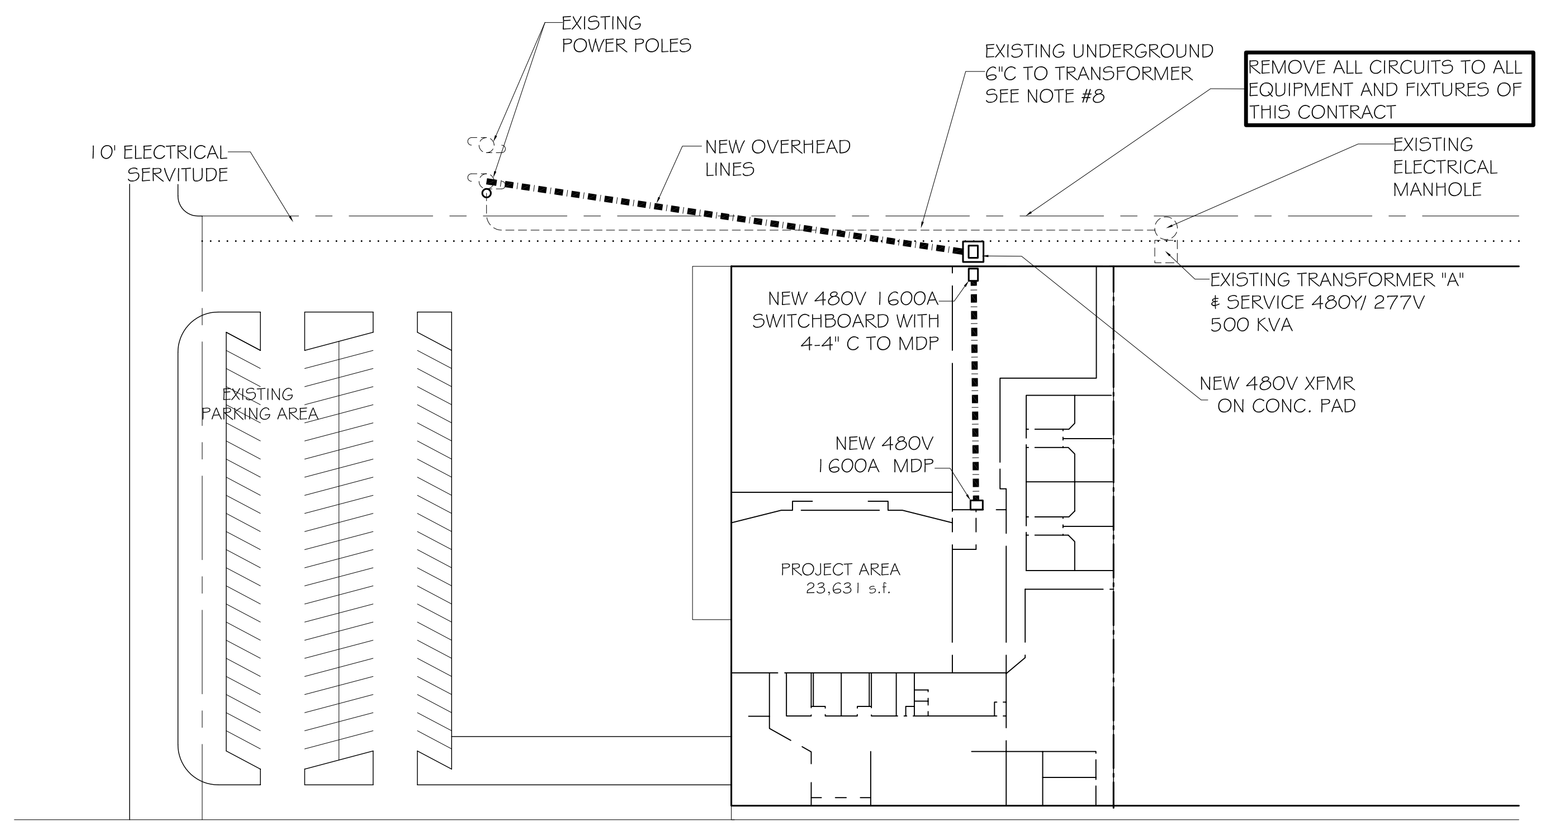

PARTIAL SITE PLAN

SCALE: 1/16"=1'-0"

DAMMON
ENGINEERING, INC.

CHIEF ENGINEER
EMMETT
DAMMON, P.E.

CHIEF ARCHITECT
ROBERT
WILTSE

1095 FLORIDA AVENUE
SLIDELL, LA. 70458
OFFICE: 985-649-5832
FAX: 985-641-5950

WEBSITE:
WWW.DAMMONENGINEERING.COM

EMAIL:
DAMMONENG@BELLSOUTH.NET

ARCHITECTURE

ENGINEERING

STUDIES

PLANNING

INVESTIGATION

EXPERT WITNESS

NORTHSHORE
CHURCH
KENSINGTON DR.
SLIDELL, LA

ONE LINE DIAGRAM
&
PARTIAL SITE PLAN

REV:01-30-09

SCALE: AS NOTED

JOB#: 1988

DATE: 09-30-08

SHEET

E-8

OF