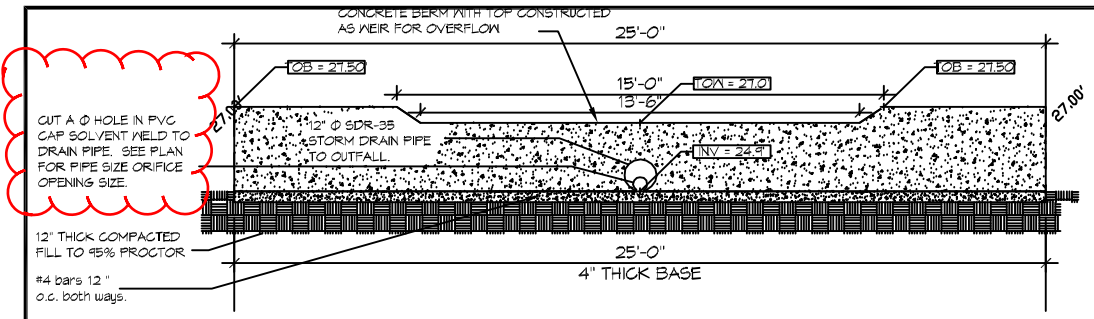

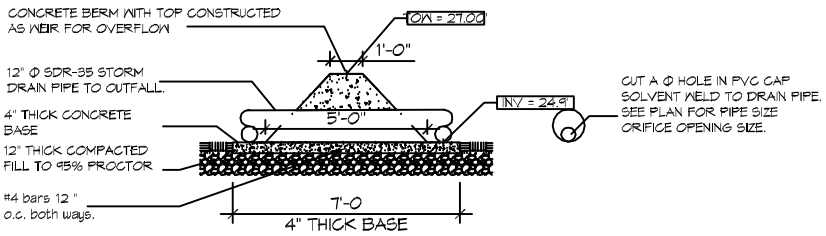

D SECTION

SCALE: NTS

BERM & WEIR