

LOUISIANA DEPARTMENT OF TRANSPORTATION AND DEVELOPMENT
WATER RESOURCES SECTION
WATER WELL REGISTRATION LONG FORM (DOTD-GW-1)

PLEASE PRINT IN INK OR TYPE WHEN COMPLETING THIS FORM

1. Well Owner: NORTHSHORE BIBLE CHURCH Phone: 504 882-6096
Address: P.O. BOX 2214
COVINGTON, LA 70434
Owner's Well Number or Name (If Any) _____

2. LOCATION OF WELL: Parish St. Tammany, Well is Near, Covington
Approximately 4/10 miles from Hwy 190 at Sunshine St (Town, City)
(Crossroads, Railroad, Any Landmark, etc.)
(Please draw sketch on back of Original Form)

3. WELL INFORMATION: Ground elevation _____ ft. M.S.L., Depth of Hole: 140 ft.
Diameter of Hole: 7.5 in. Depth of Completed Well: 140 ft.
Is well gravel-packed? Yes ☐ No ☒ Date Completed: 4-24-96

4. CASING AND SCREEN INFORMATION:
CASING: TYPE PVC SCREEN: TYPE PVC
4 in. from 0 ft. to 120 ft. 4 in. from 120 ft. to 140 ft.
_____ in. from _____ ft. to _____ ft. _____ in. from _____ ft. to _____ ft.
_____ in. from _____ ft. to _____ ft. _____ in. from _____ ft. to _____ ft.
Extension Pipe _____ in. from _____ ft. to _____ ft.
Cemented from 50 ft. to ground surface.
Pumpdown cementing method used: ☐ Inside casing ☒ Outside casing

5. WATER LEVEL AND YIELD INFORMATION: On 4-24-96 the static water level in well was 15 ft.
Date _____
☒ below ☐ above ground surface. How determined? _____
_____ The well yielded _____ gpm with a drawdown of _____ ft. after _____ hours of continuous pumping on (date) _____. Describe how yield was measured _____. It is planned to pump the well at a rate of 20 gpm for _____ hours per day for _____ days per year. Proposed average daily pumping rate: _____ gallons. Motor HP 1 Pump setting 60 ft.

6. USE OF WELL (Check Appropriate Box)
☐ Irrigation/Agricultural ☐ Industrial ☐ Community Public Supply ☐ Power Generation
☐ Dewatering ☐ Observation ☒ Non-Community Public Supply ☐ Test Hole
☐ OTHER (Please Specify) _____
(If Industrial or public supply is checked please see bottom of this form)

7. AVAILABLE INFORMATION (Check Appropriate Boxes)

	YES	NO
Is an electrical log or other borehole geophysical log available?	☐	☒ (If yes, please attach a copy of log)
Is a mechanical analysis of the drill cutting available?	☐	☒ (If yes, please attach a copy)
Is a chemical analysis of water available?	☐	☒ (If yes, please attach a copy)
Is a bacteriological analysis available?	☐	☒ (If yes, please attach a copy)
Are aquifer test results available?	☐	☒ (If yes, please attach a copy)

8. ABANDONMENT INFORMATION: (Check Appropriate Boxes)
If well is new does it replace an existing well? YES ☐ NO ☒
If yes, has owner been informed of state regulations requiring plugging of abandoned wells? YES ☐ NO ☐

9. REMARKS (Such as engineer, pump information, acreage irrigated, water well subcontractor and license no., etc.)
ESC # 96-235 SUNSHINE ST
COVINGTON, LA

10. DRILLER'S LOG (Description and color of cuttings, such as, shale, sand, etc. in feet below ground level).

FROM	TO	DESCRIPTION	FROM	TO	DESCRIPTION	FROM	TO	DESCRIPTION
0	65	Gray Clay						
65	115	Fine White Sand						
115	140	Coarse Brown Sand						

(If necessary, continue log on back of original form.)

PUBLIC SUPPLY: (If well is for public-supply purpose please check one of the following to indicate principal category of public-supply use.)

☐ Municipal ☐ Therapeutic
☐ Rural ☐ Institutional/Government
☐ Commercial ☐ Other _____
Please Specify _____

INDUSTRIAL: (If well is for industrial purpose please check one of the following to indicate the standard industrial category representing the principal industrial use).

☐ Food and Kindred Products ☐ Paper and Allied Products
☐ Textile Mill Products ☐ Chemicals and Allied Products
☐ Lumber & Wood Products (Except Furniture). ☐ Petroleum Refining & Related Industries
☐ Other _____ ☐ Primary Metal Products
Please Specify _____

Gill Water Well Drilling

Name of Water Well Contractor

License Number WWC-055
Gill Water Well Drilling 4/96
Authorized Signature (Date)

MAIL ORIGINAL TO:

Department of Transportation and Development
Attn: Chief-Water Resources Section
P.O. BOX 94245
BATON ROUGE, LA 70804-9245
(504) 379-1434

FOR OFFICE USE ONLY

STATE 22 PARISH 103 LOCAL WELL NO. -74522

IDENTIFICATION NUMBER

302808090044101

OWNER'S NAME

WELL DEPTH

_____ Ft.

Use of Well

P -C

Date Completed

MO. YR.

OWNER'S NO.

Geologic Unit

Proposed Daily Pumping Rate

AVAILABLE INFORMATION

☐ ☐ ☐ ☐ ☐ ☐

CONTRACTOR'S NAME

SECTION

042

TOWNSHIP

075

RANGE

11E

REVISED COORDINATES

HOLE DEPTH

ELEV.

0023

QUAD. NO.


159B

Inspected By VRK/50

Date 3-27-98

Remarks LSH 10/16/96

RECEIVED OCT 14 1996

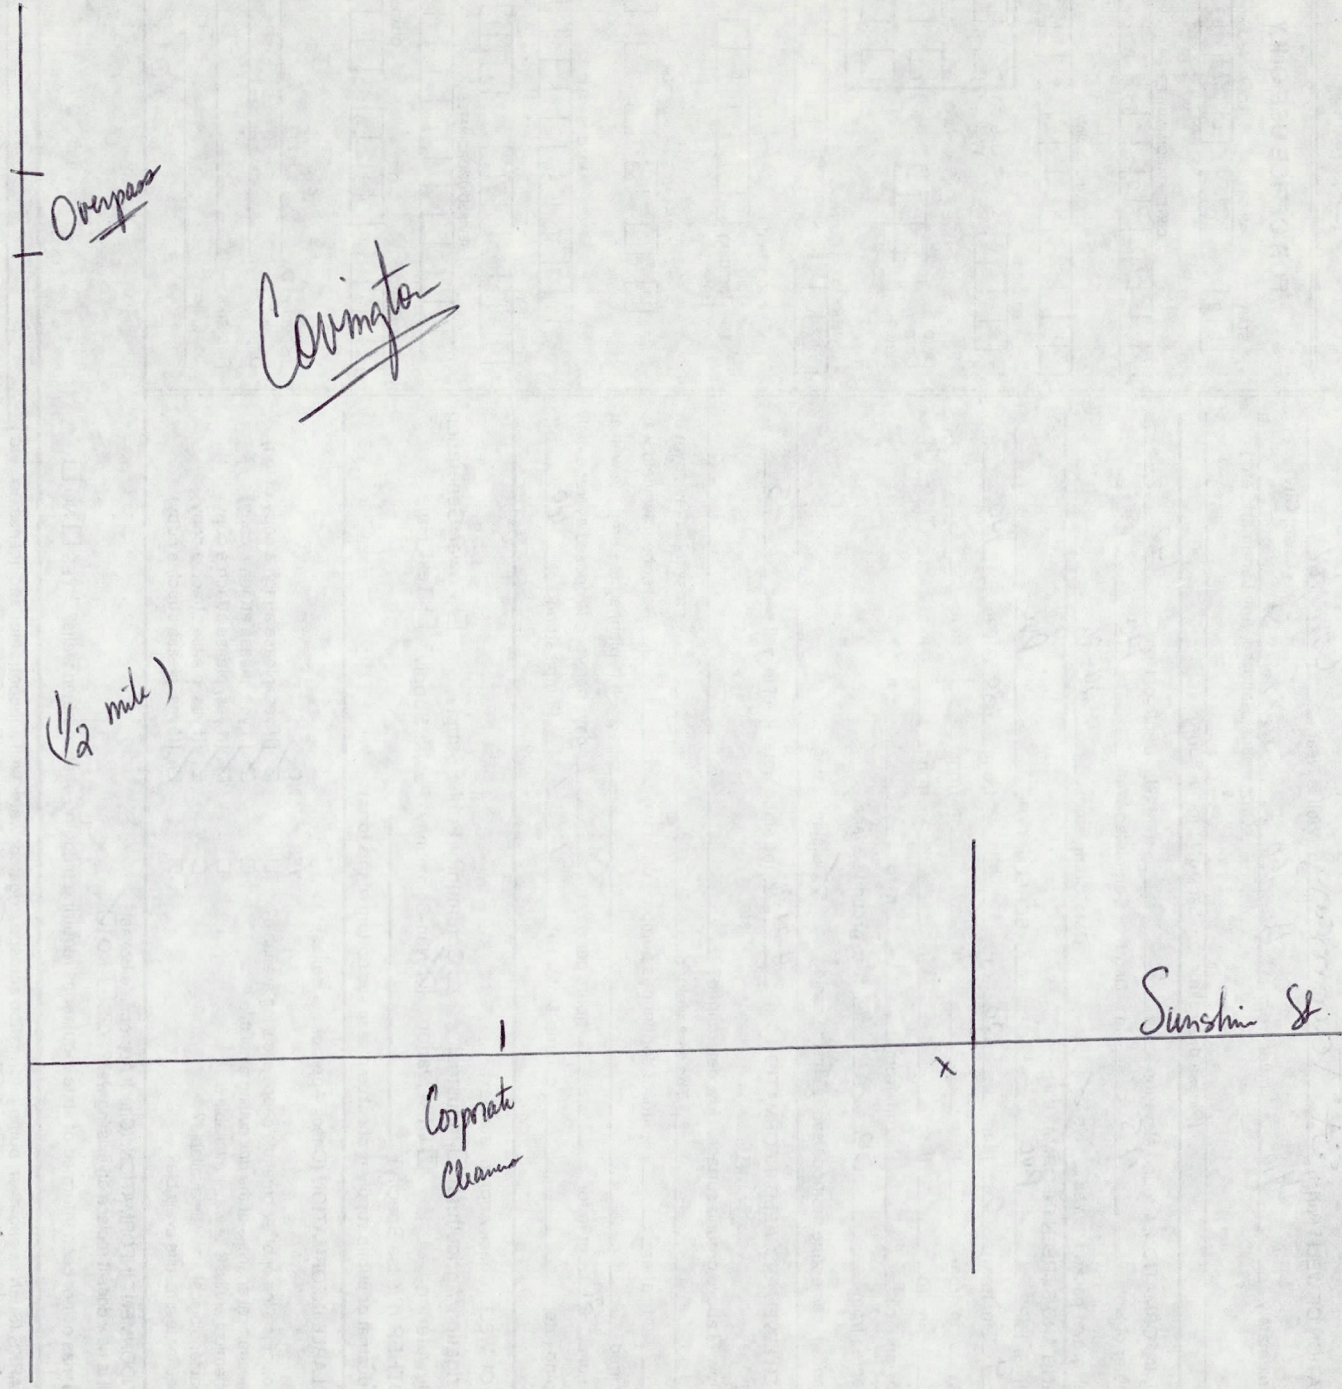

103-7452Z

UNITED STATES
DEPARTMENT OF THE INTERIOR
GEOLOGICAL SURVEY

