


BEGINNING AT THE CORNER OF NORTH E.O.W. & EAST OF LAKE FOREST BLVD.
A SOUTHERLY DIRECTION FROM THE INTERSECTION OF LAKE
FOREST BLVD. AND PARKER AVE., PROCEED IN A SOUTHERLY DIRECTION
ALONG A CORKED LINE OF RADIALS 109°-08'. THE SAME BEING THE NORTH
E.O.W. OF LAKE FOREST BLVD., A DISTANCE OF 181.90 FT., THENCE
THENCE 100.31 FT. ON A BEARING OF NORTH 35°-03'-12" WEST, THENCE
214.0 FT. ON A BEARING OF NORTH 36°-36'-48" WEST, THENCE
51.0 FT. ON A BEARING OF NORTH 55°-42'-30" WEST, THENCE
274.0 FT. ON A BEARING OF NORTH 55°-42'-30" WEST, THENCE
227.92 FT. ON A BEARING OF SOUTH 86°-59'-48" WEST TO POINT
OF BEGINNING.

NOTE: CITY BENCH MARK #576 ELEV. 29.99 CAIRO DATUM
BENCH MARK:

THE PILOT WORK IS, THERE, CORRECT AND ACCURATE REPRESENTATION OF THE PROPERTY AS DETERMINED BY SURVEY ACTUALLY MADE ON THE GROUND OF THE PROPERTY AS DESCRIBED BY THE SURVEY AND DIMENSIONS OF SAID AS BEING DESCRIBED THEREIN. THE LINES AND DIMENSIONS OF THE PROPERTY BEING AS INDICATED BY THE PILOT, THE DISTANCE FROM ADJACENT SHORE OR SAID PILOT, THERE ARE NO ENCUMBRANCES, CONFLICTS OR PROVISIONS, EITHER VAN AMONGST PROPERTY LINES EXCEPT AS SHOWN.

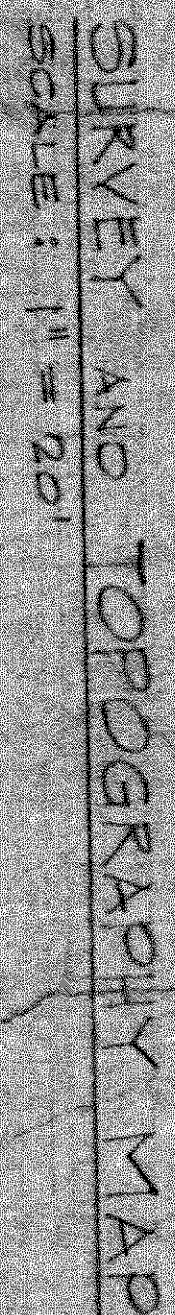

NEW ORLEANS, LA. SEPTEMBER 13, 1978

SURVEYED & CERTIFIED CORRECT TO FOREST TOWERS
EAST, INC., AND TO ALL PARTIES INTERESTED IN TITLE
TO PREMISES SURVEYED.

Robert E. Oswald

ROBERT E. OSWALD, INC.

ROBERT E. OSWALD, INC.
REGISTERED LAND SURVEYOR

REVISED 9-13-72


These documents and communications have been
prepared by me or under my close personal
supervision and to the best of my
knowledge and belief, they comply with
all legal requirements.

Morris H. Barker

MORRIS H. BARKER

FOREST TOWERS EAST APARTMENTS
for
FOREST TOWERS EAST INC.
NEW ORLEANS LOUISIANA

PARKER - CROSTON ASSOCIATES
ARCHITECTS • ENGINEERS • PLANNERS
FORT WORTH TEXAS

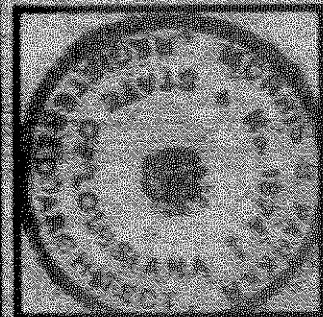

A.1
OF 215 SHEETS

JOB NO 7722
DATE 4-22-77
DRAWN BY
CHECKED REC
SHEET N