

C100

SCALE	AS SHOWN
DATE	3/13/10
PROJECT NO.	HUB
CLIENT	
DESIGNED BY	
CHECKED BY	
APPROVED BY	

Site Plan

Hubcap, Tire & Wheel, Inc.  
4200 Jefferson Hwy., Jefferson, Louisiana 70121




*PLUMBING  
PLAN  
SOIL ANALYSIS*

*Concrete Foundation  
504-736-6957  
504-736-6355  
Tommy  
504-736-6957*

*Dumpster  
Location*

*Soil pits to  
mark & provide  
spaces for*

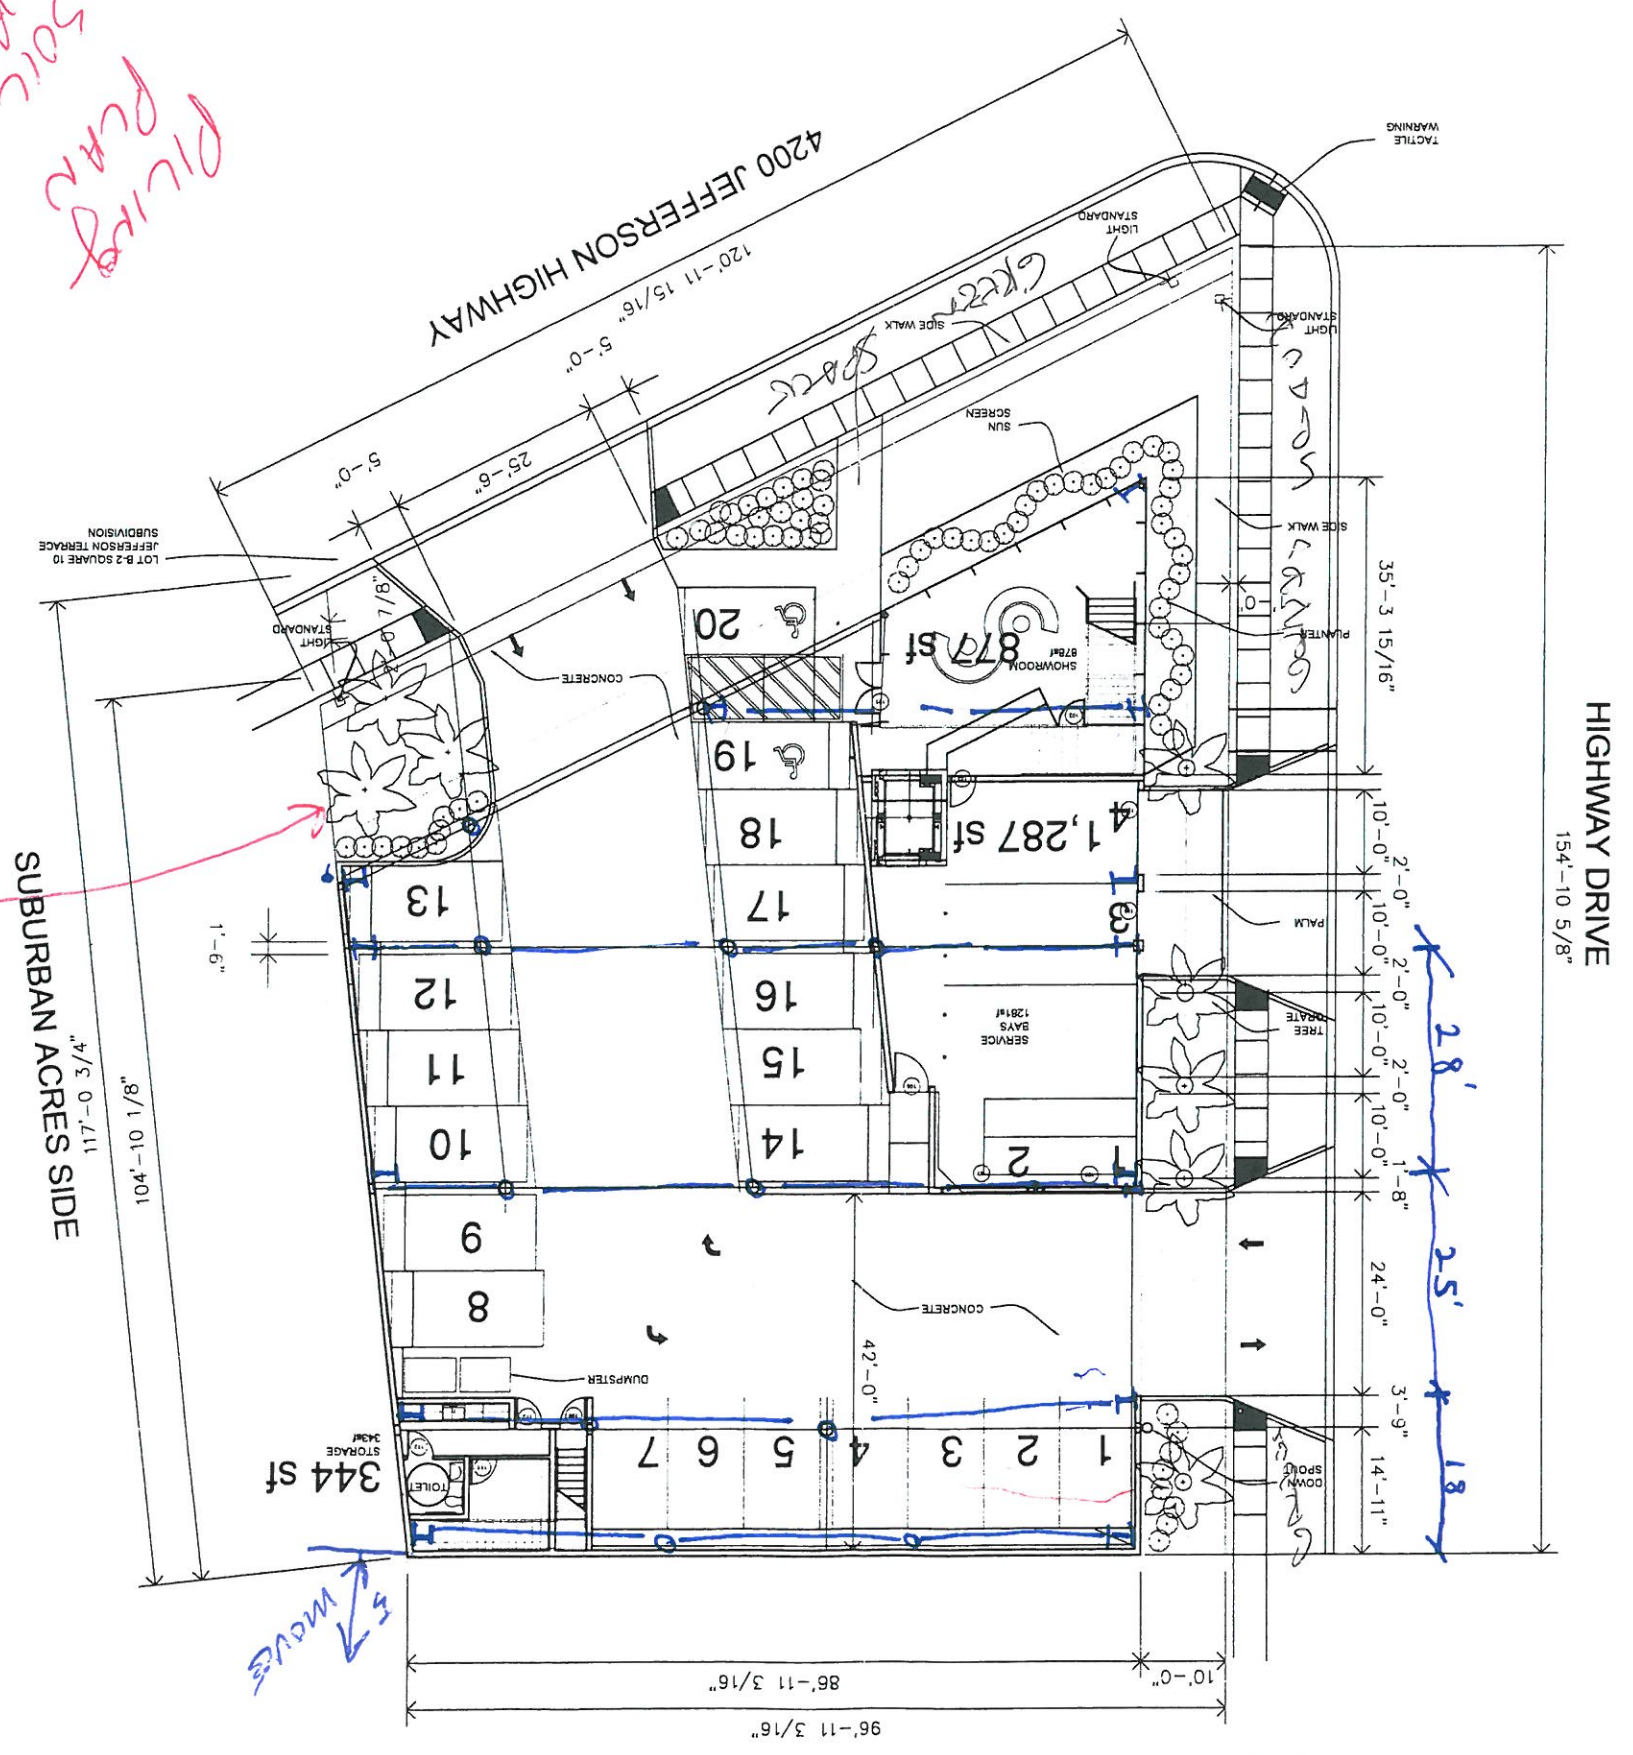

1  
Site Plan  
3/8"=1'-0"