



FRANK'S ACCURATE BODY SHOP
684 E. I-10 SERVICE RD SLIDELL, LA 70461
PHONE: 985-641-1454 FAX: 985-847-1456
FAX SHEET


TO: CHUCK

FAX#: _____ DATE: _____

FROM: FRANK


COMMENTS: _____


I CIRCLED THE THINGS
THAT I CHANGED
FRANK

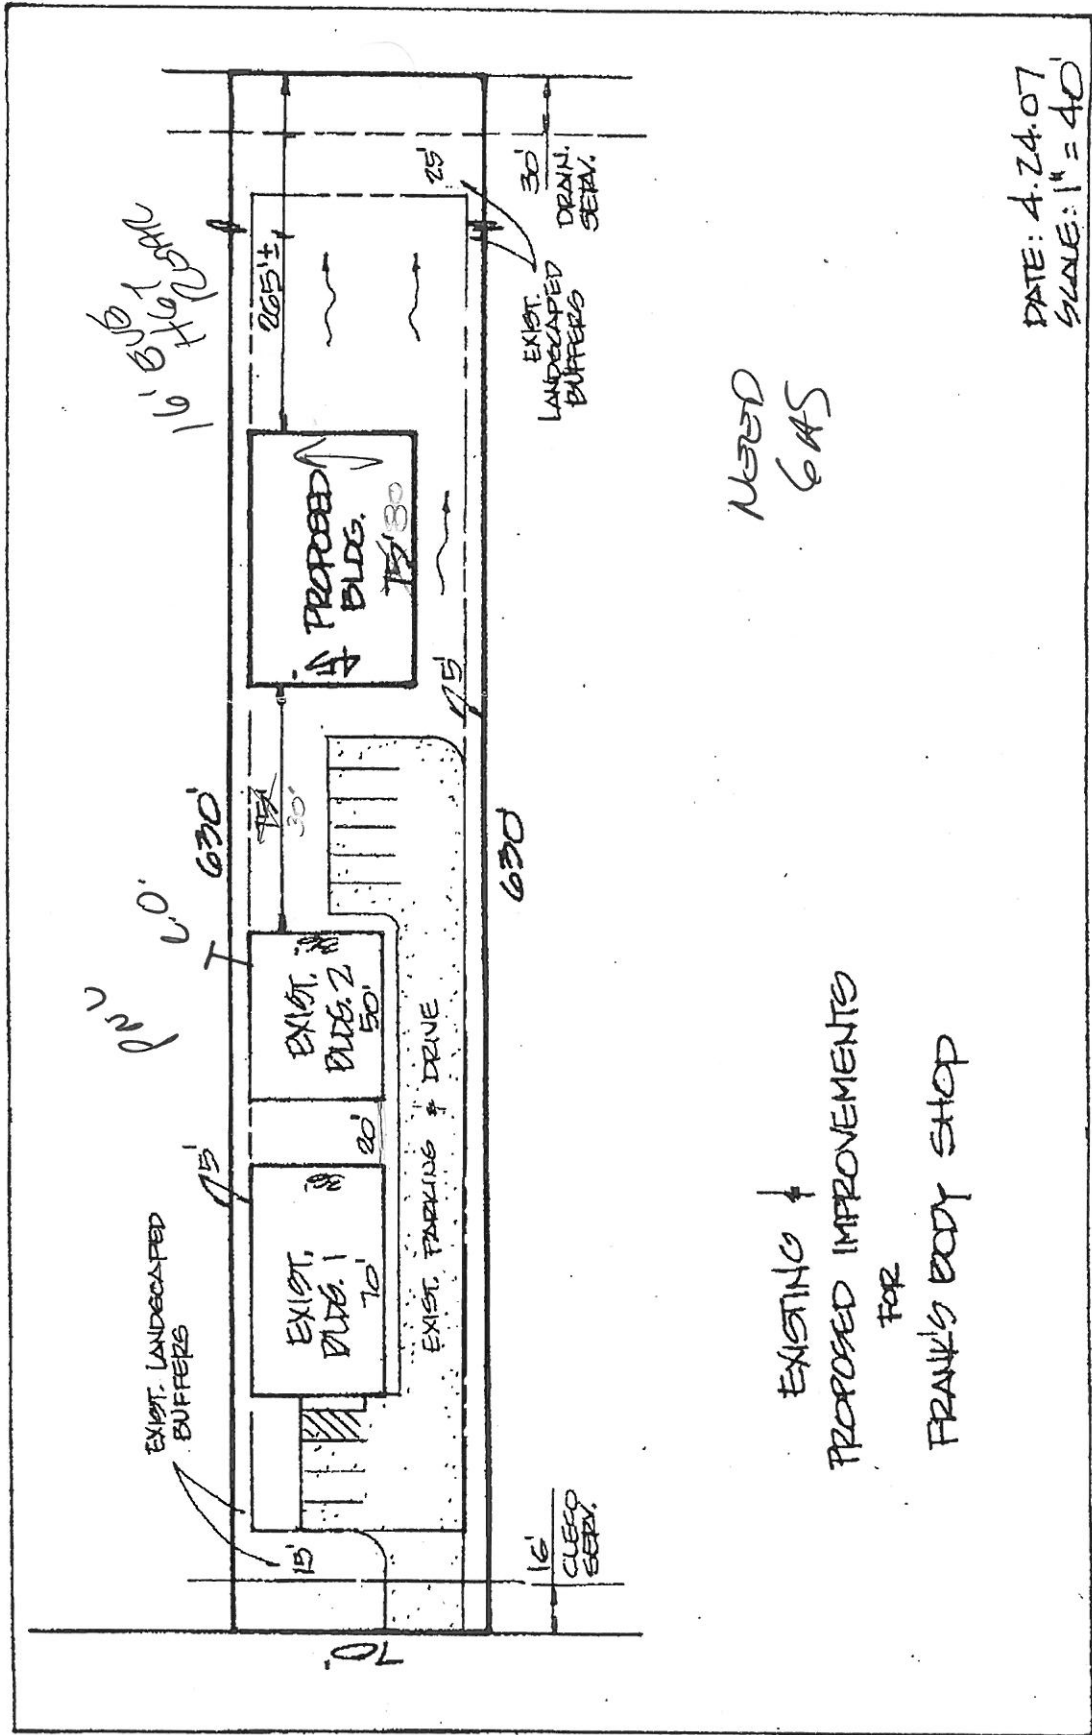

DATE: 4.24.07
SCALE: 1" = 40'

Attn: Dave

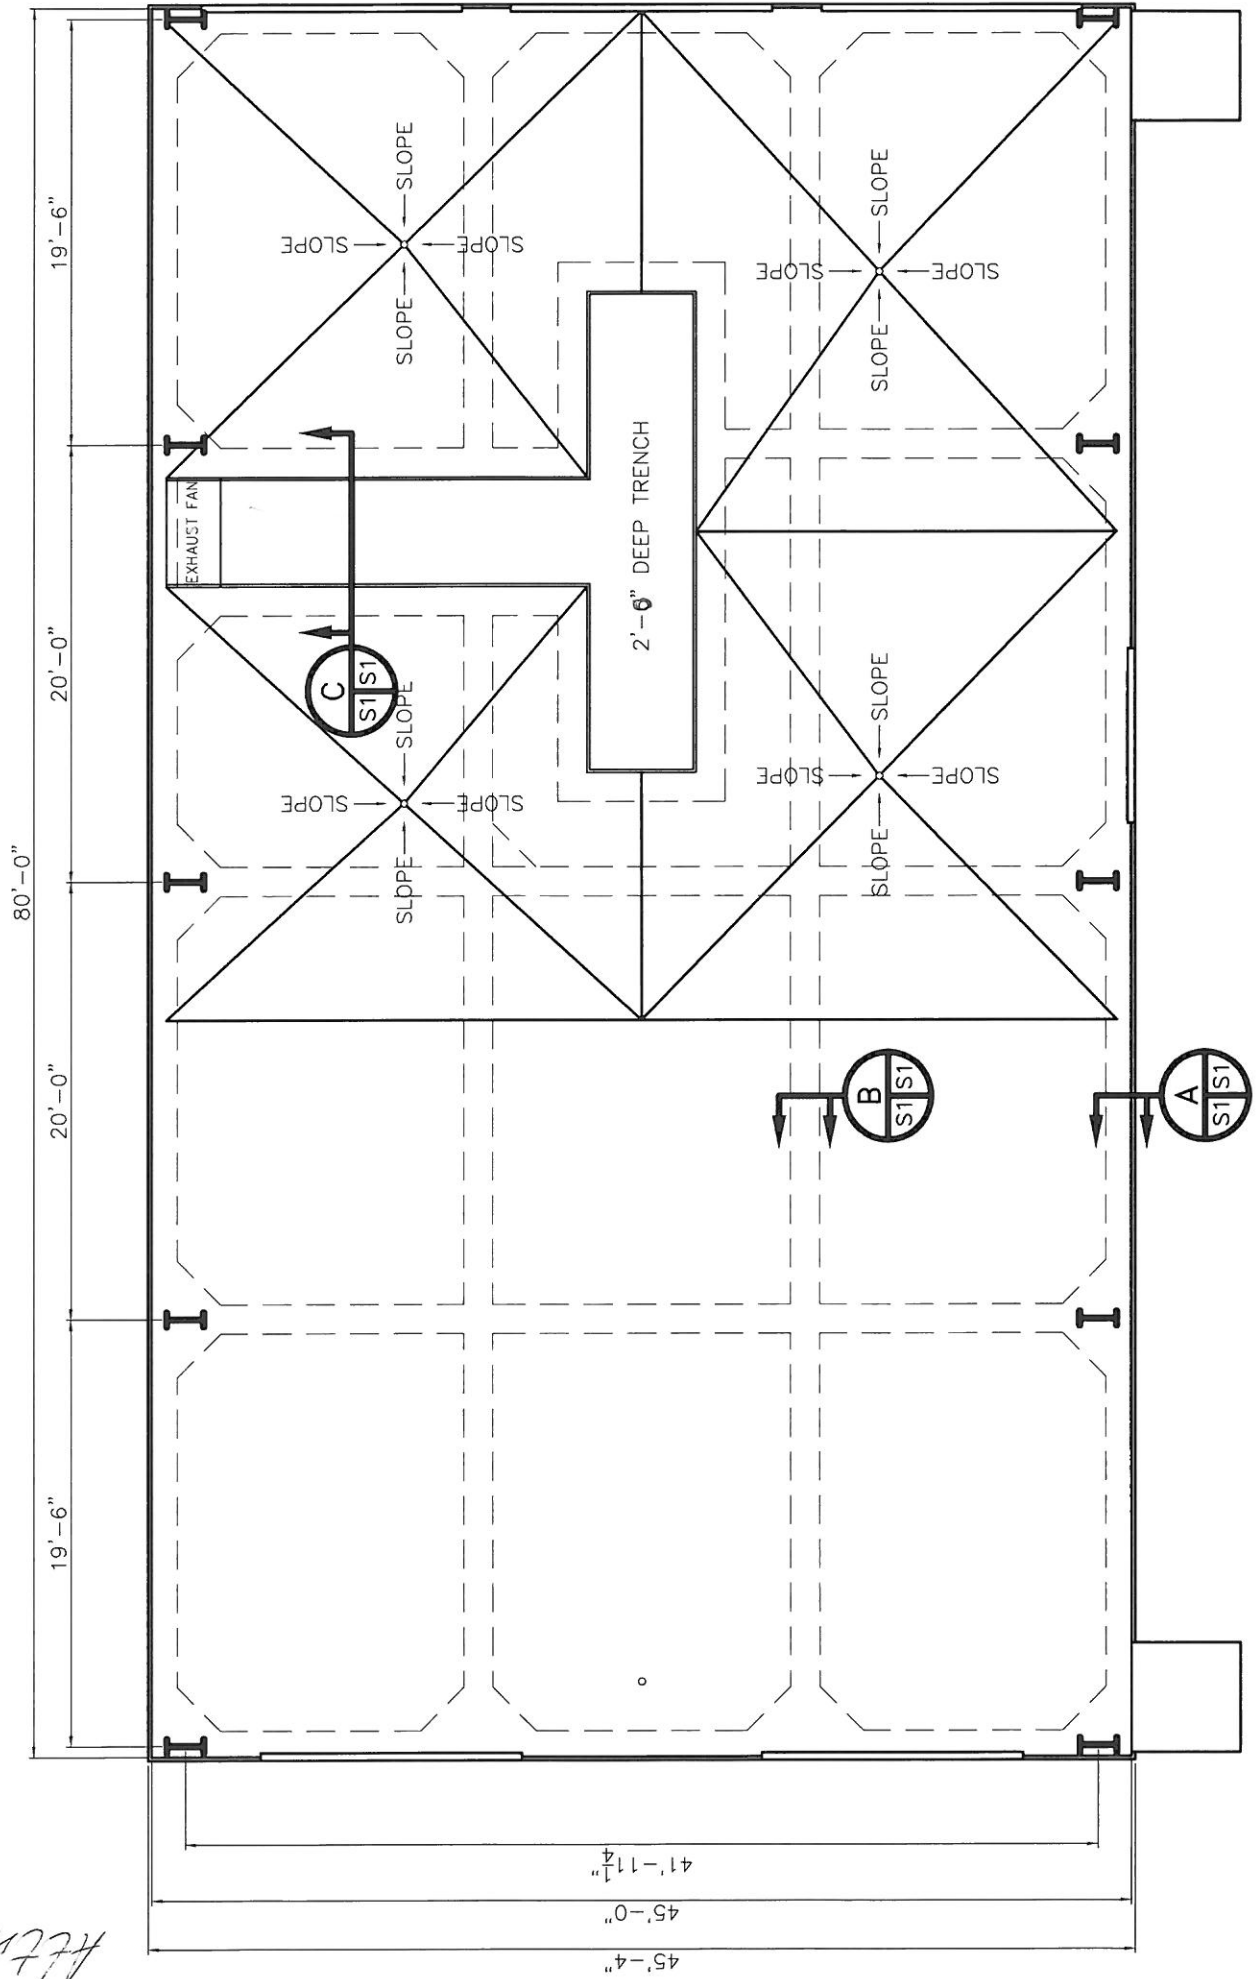

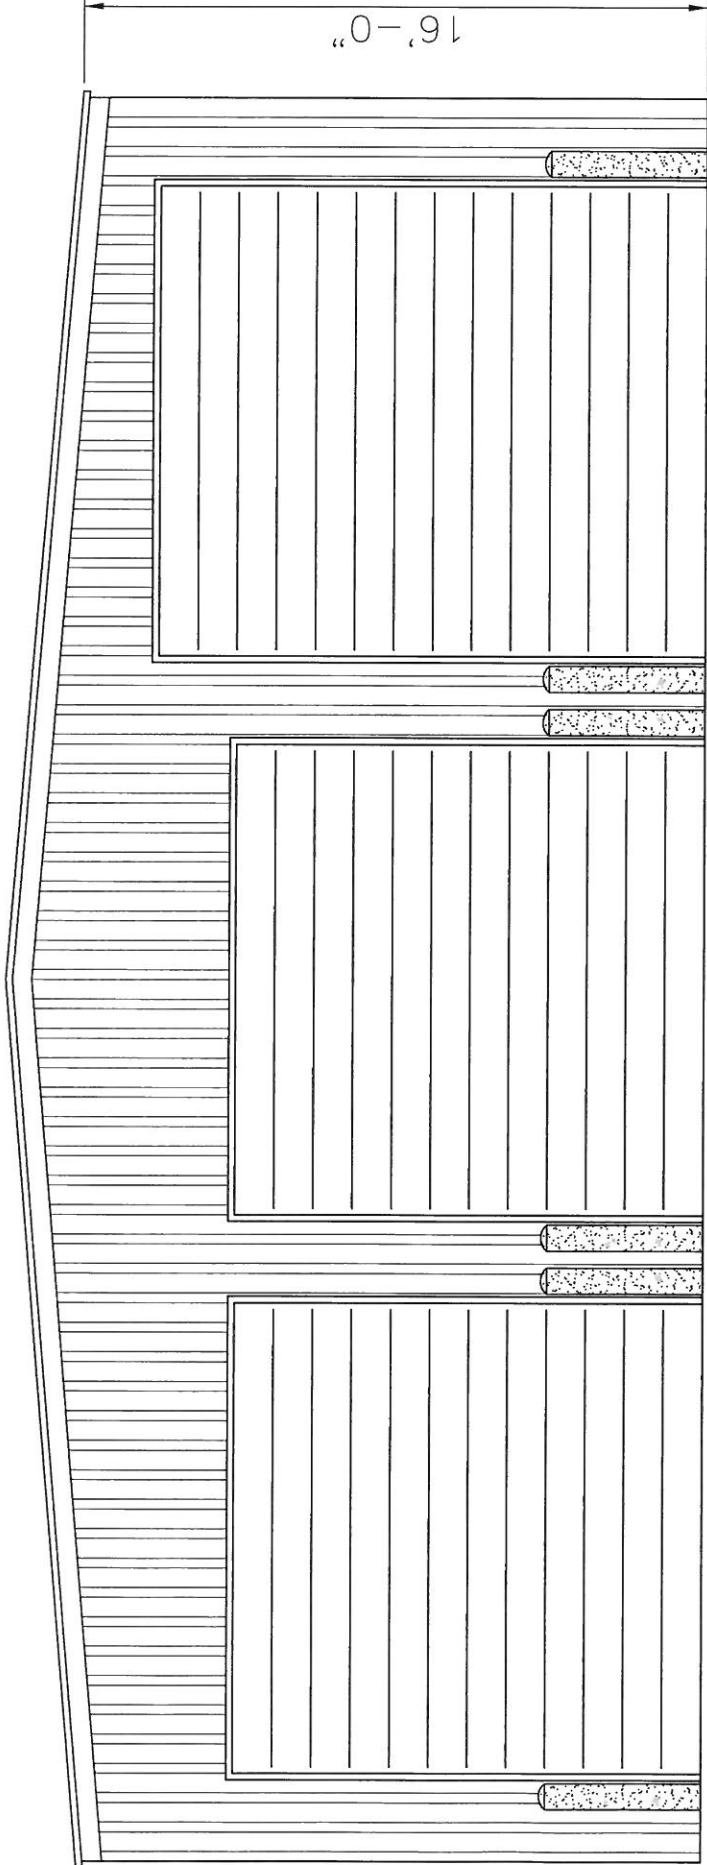

WEST ELEVATION

SCALE: 3/16" = 1'-0"

2 of 2

Danner Engineering


Ph: 985/649-5832 Fax 985-647-5950

318/438-8360

Attn: A. T. Williams

Date	6-7-07	# of pages	▶
From	Steve Kaufmann		
Co./Dept	K.B. Kaufmann		
Phone #	649-7381		
Fax #	649-7679		
Post-it® Fax Note	7671		
To	Alan		
Co./Dept	Demoran Eng.		
Phone #	641-5950		
Fax #	641-5950		

K.B. KAUFMANN & CO.,
1019 OLD SPANISH TR
SLIDELL, LA 70458

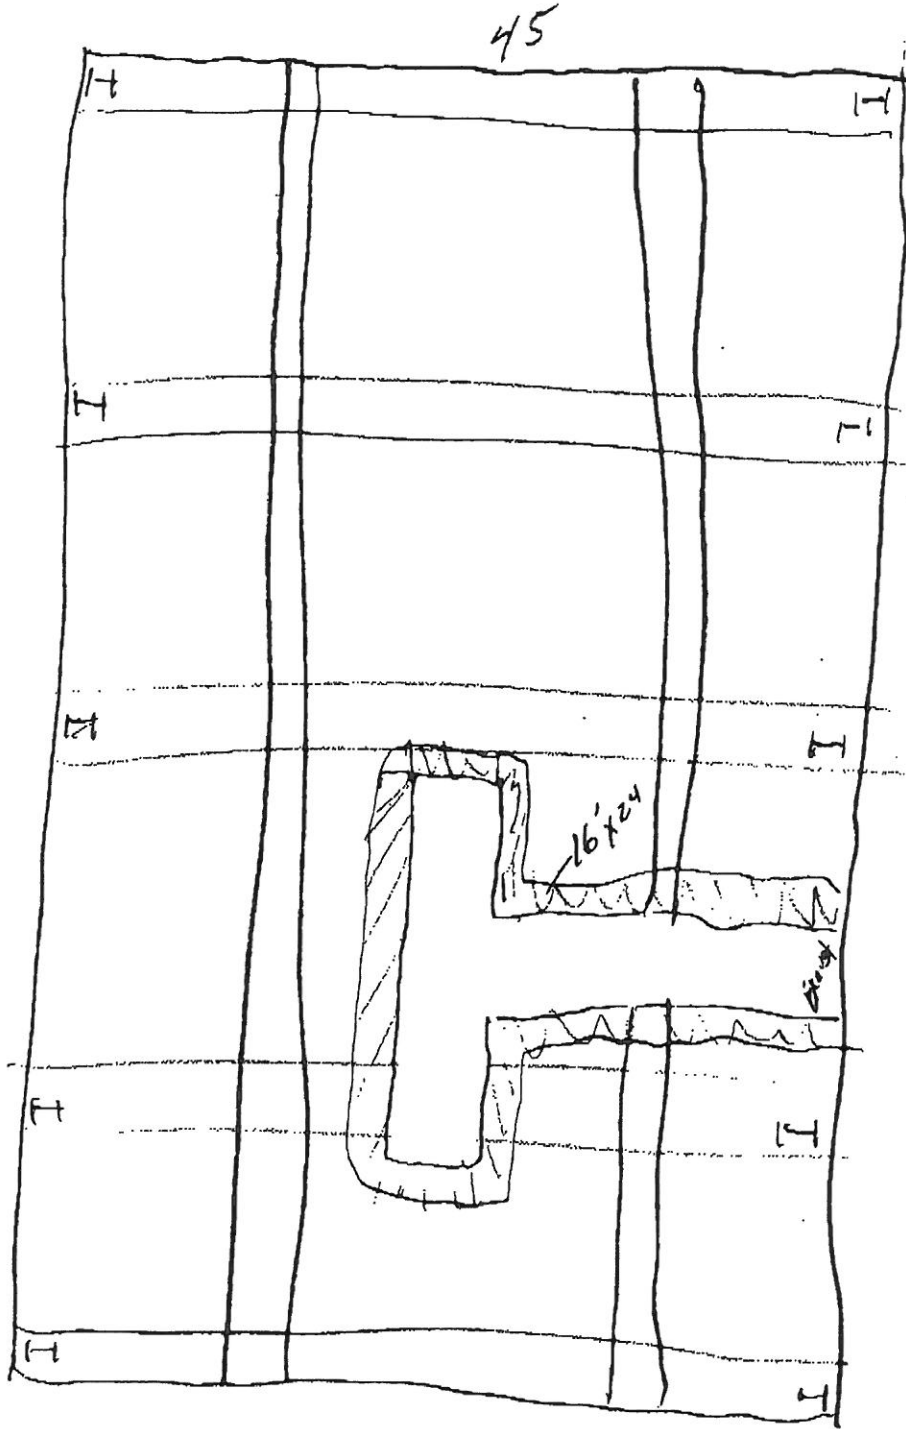

80

