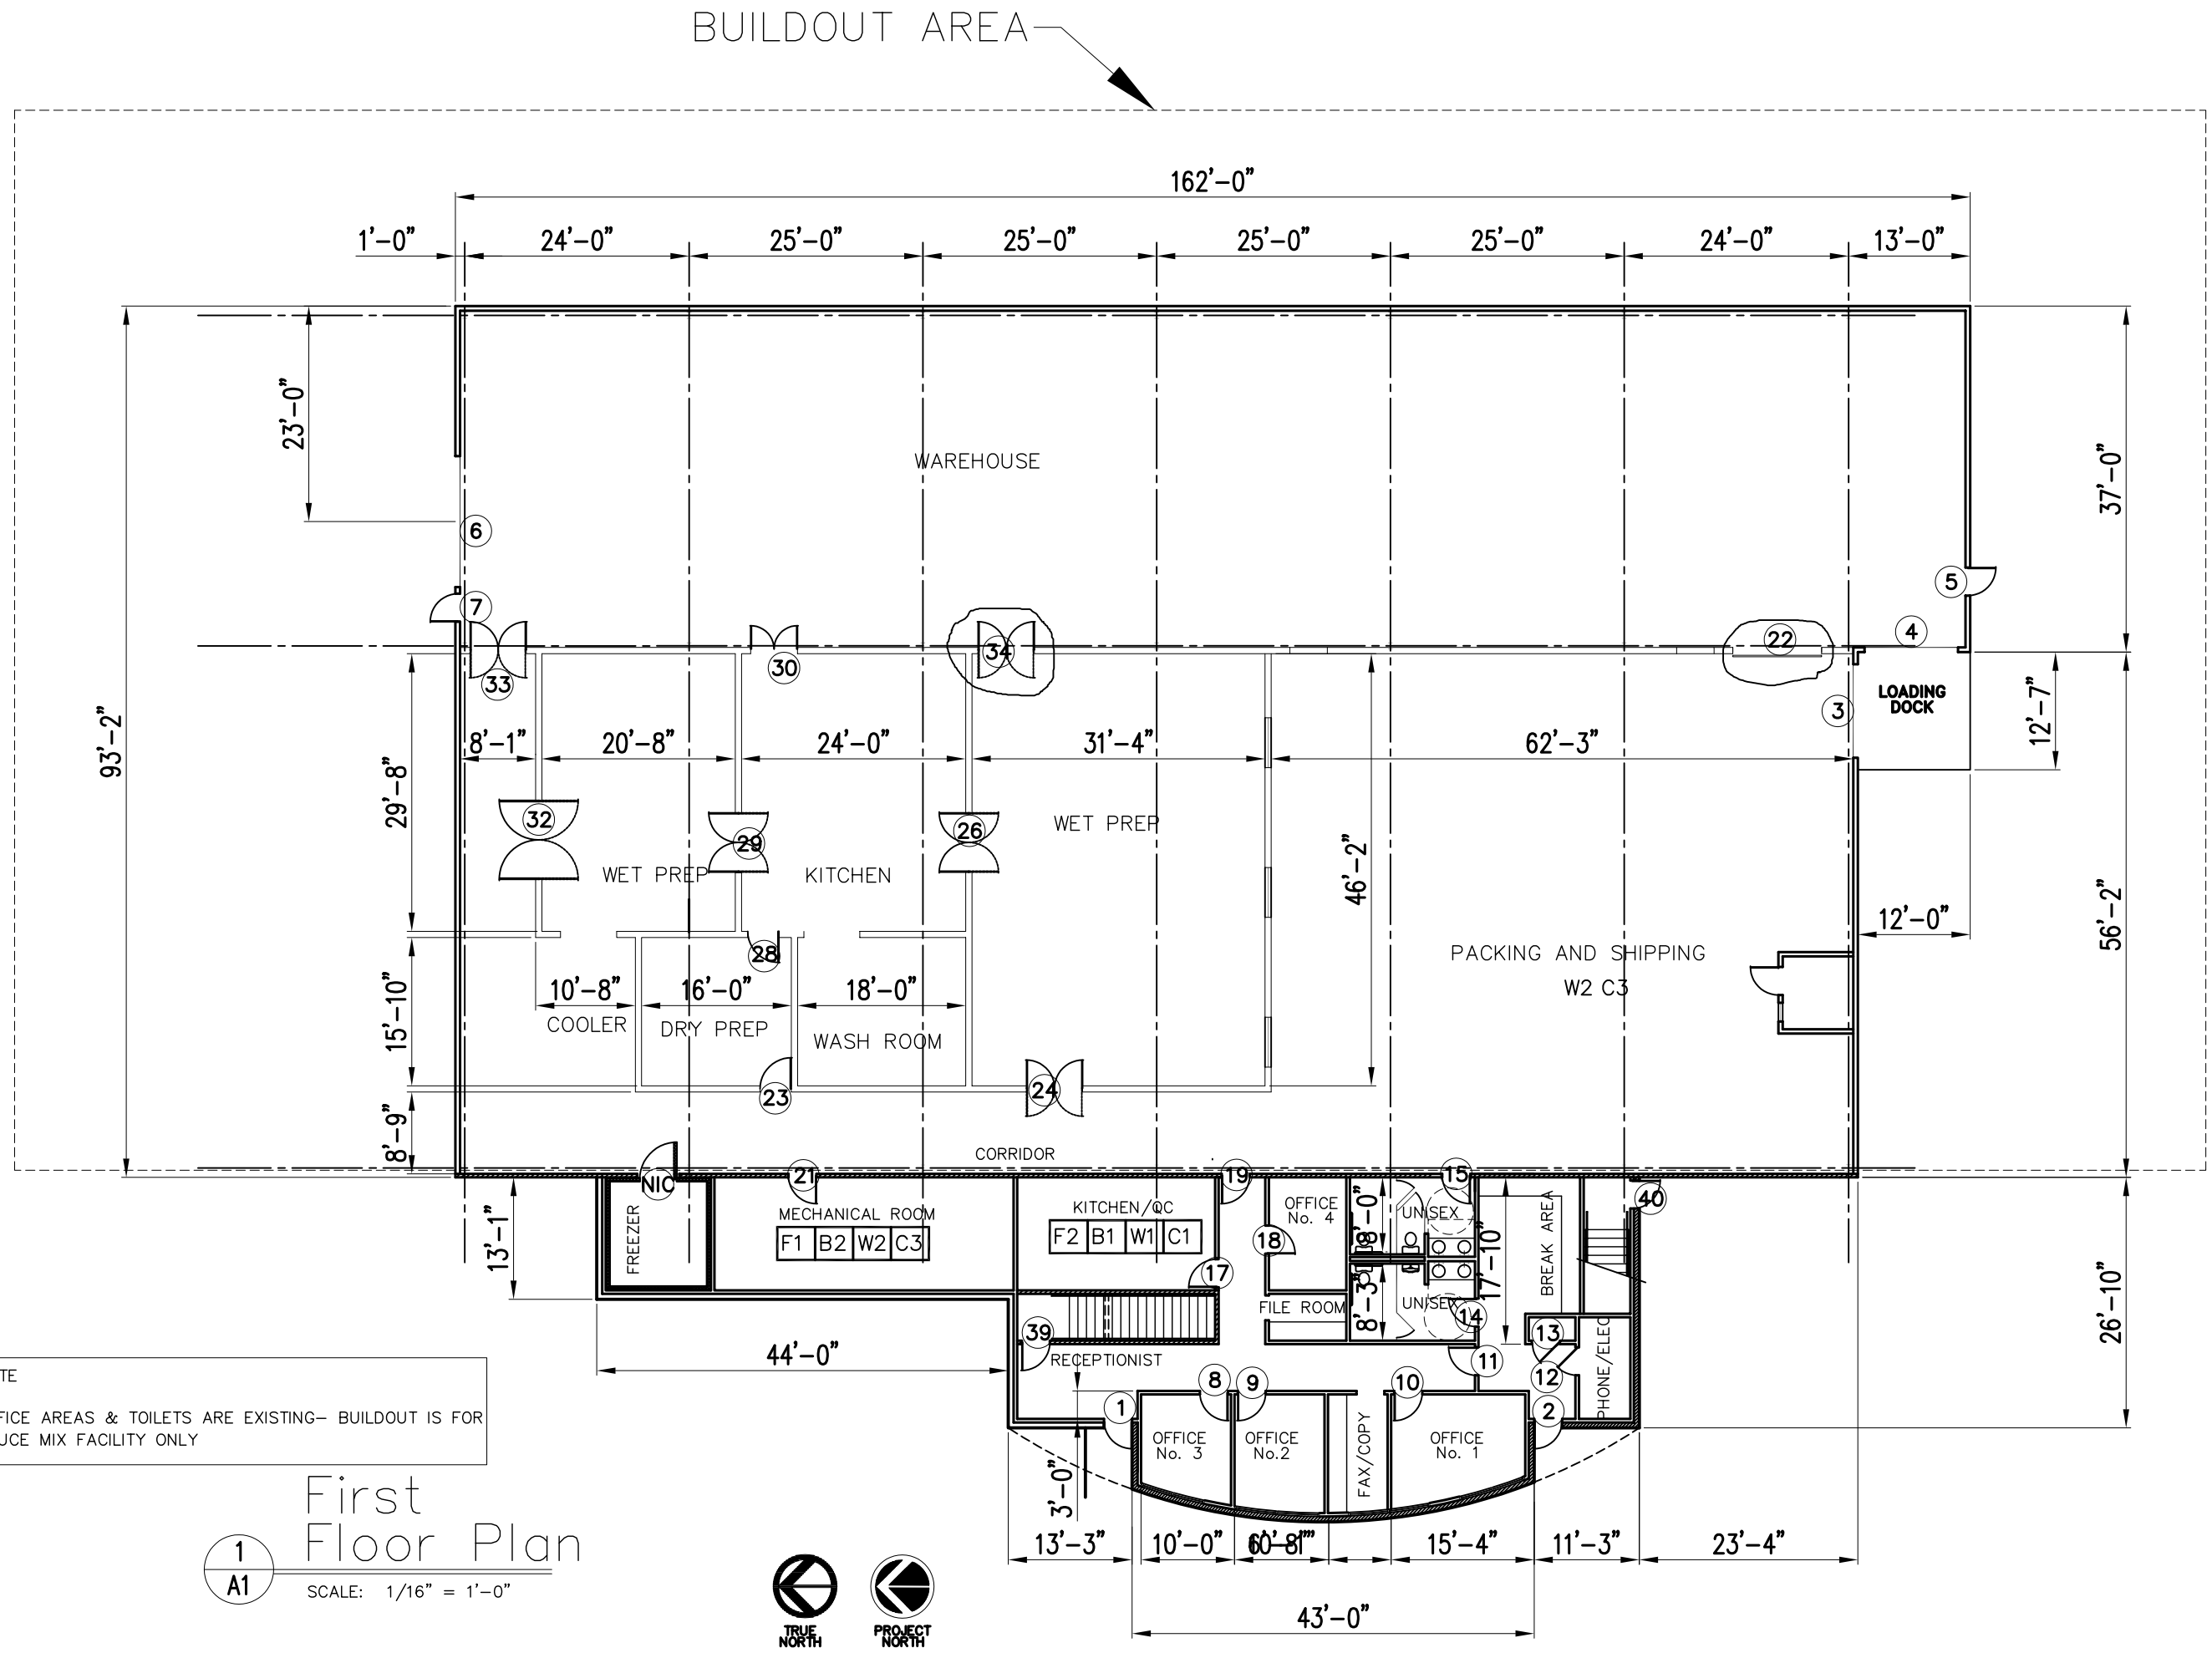

NOTE

OFFICE AREAS & TOILETS ARE EXISTING– BUILDOUT IS FOR SAUCE MIX FACILITY ONLY

1 / A1 First Floor Plan

SCALE: 1/16" = 1'-0"

FLOOR PLAN

LOT 36 JOHNNY SMITH AVE.
JOHNNY SMITH MEM. PARK
SLIDELL, LA.

SAL AND JUDY'S SAUCE MIX PLANT

DAMMON ENGINEERING. INC.
1096 FLORIDA AVENUE 985-649-5832 SLIDELL, LA. 70458
DAMMONENGINEERING.COM

SLIDELL LA

FILE:

JOB NO.

DATE:05/25/07

SHEET

A–1

OF