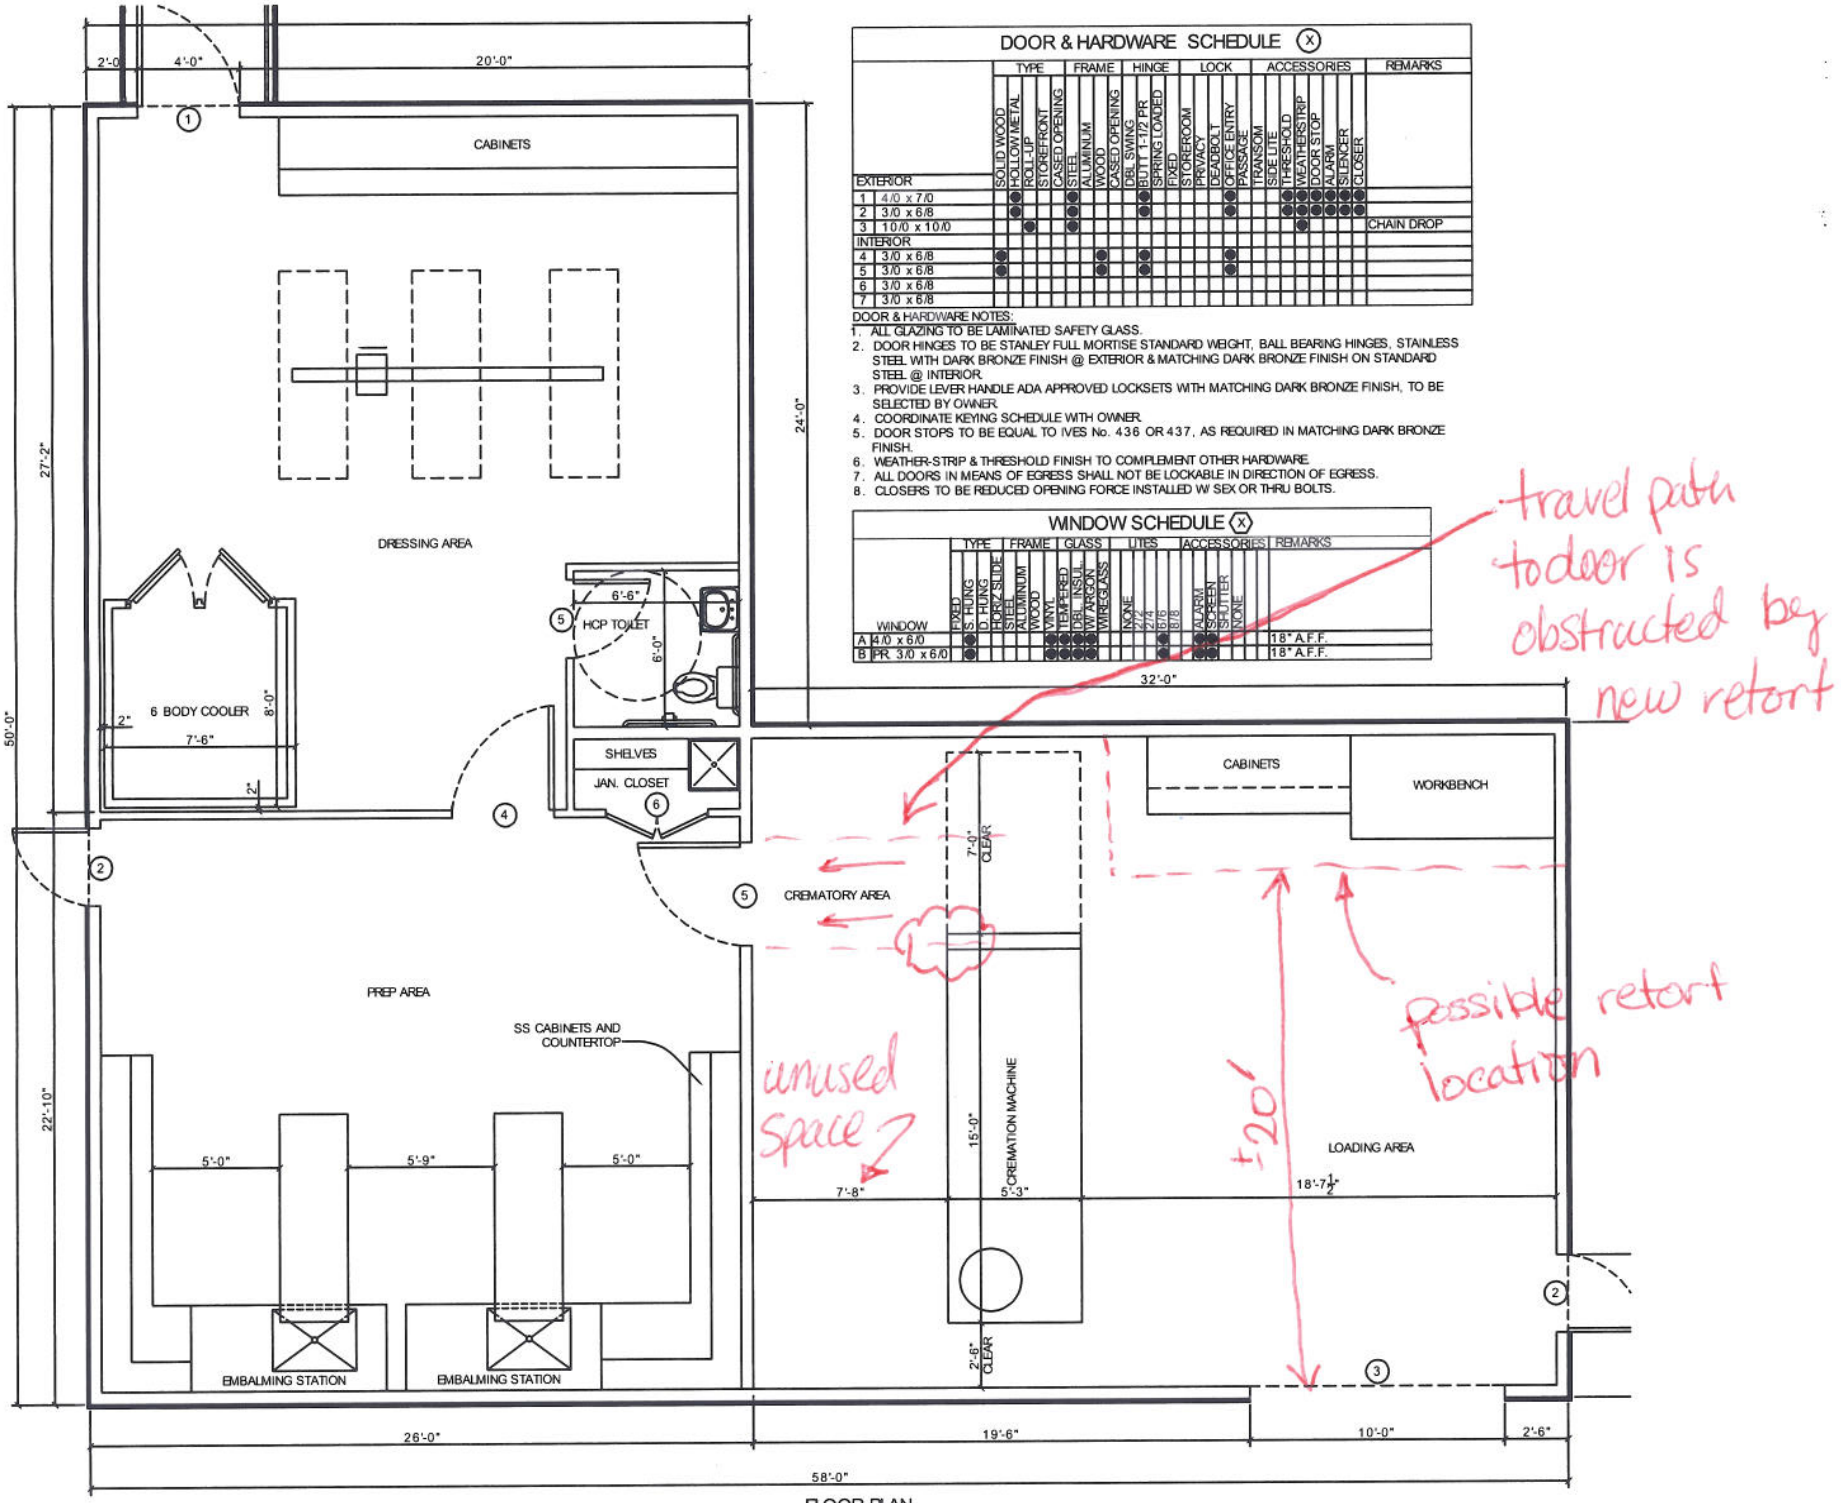

FLOOR PLAN

SCALE: 3/8" = 1'-0"

TOTAL 2,140 s.f.

DOOR & HARDWARE SCHEDULE (X)

		TYPE				FRAME			HINGE			LOCK				ACCESSORIES						REMARKS
		SOLID WOOD	HOLLOW METAL	ROLL-UP	STOREFRONT	CASED OPENING	STEEL	ALUMINUM	WOOD	CASED OPENING	DBL SWING	BUTT 1-1/2 PR	SPRING LOADED	FIXED	STOREROOM	PRIVACY	DEADBOLT	OFFICE ENTRY	PASSAGE	TRANSOM	SIDE LITE	THRESHOLD	WEATHERSTRIP	DOOR STOP	ALARM	SILENCER	CLOSER	
EXTERIOR																												
1	4/0 x 7/0		●				●															●	●	●	●	●	●	
2	3/0 x 6/8		●				●					●						●				●	●	●	●	●	●	
3	10/0 x 10/0			●			●																●					CHAIN DROP
INTERIOR																												
4	3/0 x 6/8	●							●			●																
5	3/0 x 6/8	●							●			●						●										
6	3/0 x 6/8																											
7	3/0 x 6/8																											

DOOR & HARDWARE NOTES:

1. ALL GLAZING TO BE LAMINATED SAFETY GLASS.
2. DOOR HINGES TO BE STANLEY FULL MORTISE STANDARD WEIGHT, BALL BEARING HINGES, STAINLESS STEEL WITH DARK BRONZE FINISH @ EXTERIOR & MATCHING DARK BRONZE FINISH ON STANDARD STEEL @ INTERIOR.
3. PROVIDE LEVER HANDLE ADA APPROVED LOCKSETS WITH MATCHING DARK BRONZE FINISH, TO BE SELECTED BY OWNER.
4. COORDINATE KEYING SCHEDULE WITH OWNER.
5. DOOR STOPS TO BE EQUAL TO IVES No. 436 OR 437, AS REQUIRED IN MATCHING DARK BRONZE FINISH.
6. WEATHER-STRIP & THRESHOLD FINISH TO COMPLEMENT OTHER HARDWARE.
7. ALL DOORS IN MEANS OF EGRESS SHALL NOT BE LOCKABLE IN DIRECTION OF EGRESS.
8. CLOSERS TO BE REDUCED OPENING FORCE INSTALLED W/ SEX OR THRU BOLTS.

WINDOW SCHEDULE (X)

		TYPE				FRAME			GLASS				LITES					ACCESSORIES					REMARKS
		FIXED	S HUNG	D HUNG	HORIZ SLIDE	ALUMINUM	WOOD	VINYL	TEMPERED	DBL INSUL	W/ ARGON	WIRE GLASS	NONE	2/2	4/4	6/6	8/8	ALARM	SCREEN	SHUTTER	NONE		
WINDOW																							
A	4/0 x 6/0		●						●	●	●						●		●	●			18" A.F.F.
B	PR. 3/0 x 6/0	●							●	●	●						●		●	●			18" A.F.F.