

DAMMON ENGINEERING, INC.

CHIEF ENGINEER
EMMETT DAMMON, P.E.

CHIEF ARCHITECT
ROBERT WILTSE

554 OLD SPANISH TRAIL
SLIDELL, LA. 70458
OFFICE: 985-649-5832
FAX: 985-641-5950

WEBSITE:
WWW.DAMMONENGINEERING.COM

EMAIL:
DAMMONENG@BELLSOUTH.NET

- ARCHITECTURE
- ENGINEERING
- STUDIES
- PLANNING
- INVESTIGATION
- EXPERT WITNESS

NEW
RESIDENTIAL
COMMUNITY
HOME

STARC WEST
1705 VIOLA ST
MANDEVILLE, LA

FLOOR PLAN

Robert Wiltse

REV:

SCALE: AS NOTED


JOB#: 2081

DATE: 04-08-2011

SHEET 5

A-1

OF 17

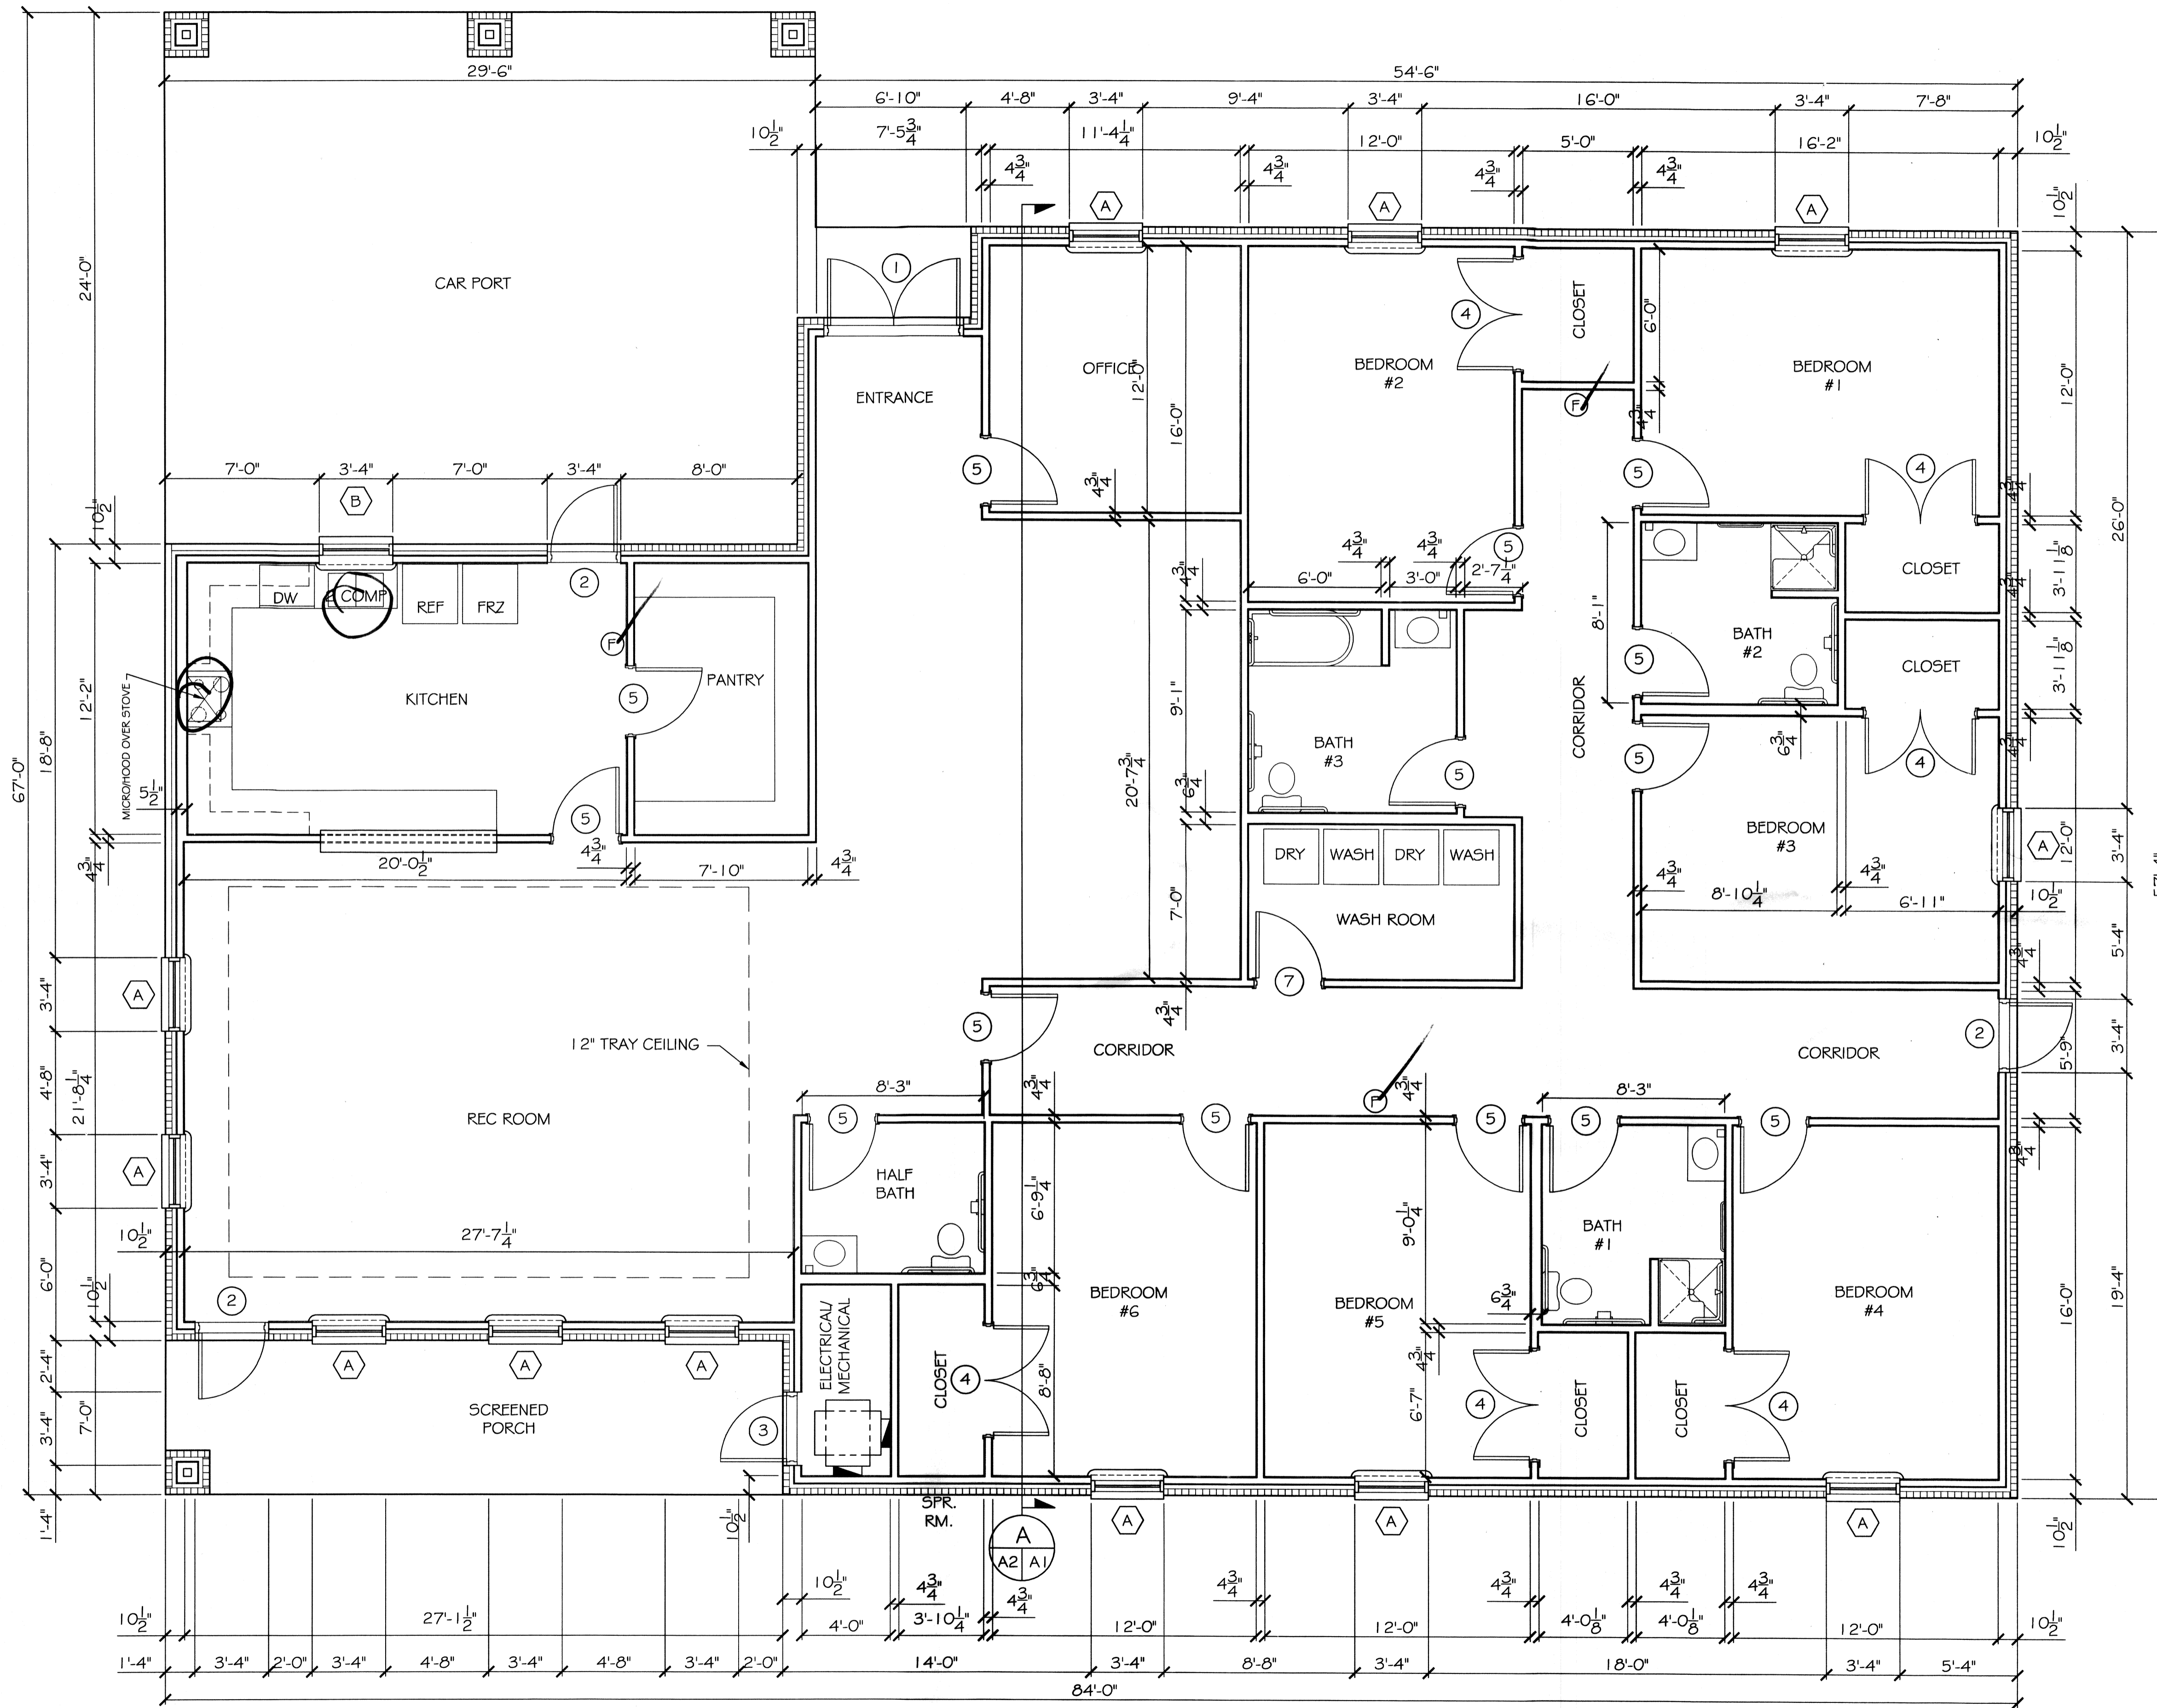

FLOOR PLAN
SCALE: 1/4"=1'

FOR GENERAL NOTES,
SEE SHIT A-6