
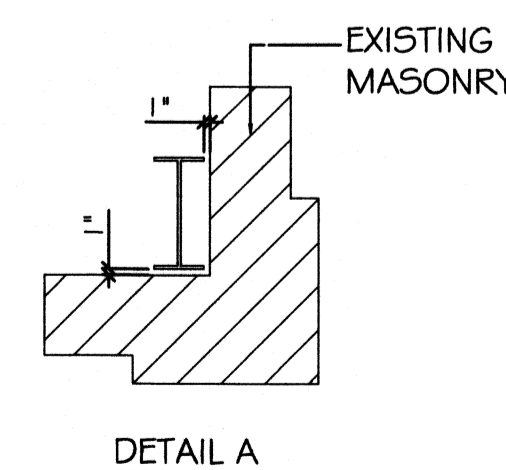


FLOOR PLAN  
SCALE: 3/16" = 1'-0"

- LEGEND
- NEW RATED WALL SEE DETAIL ON SHEET A-3
  - NEW MTL. STUD WALL SEE DETAIL ON SHT A-3

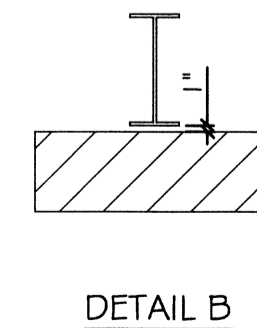

AREA BY USE:  
TOTAL AREA: 6000 SQ.FT.  
EACH TENANT: 3000 SQ.FT.

419526  
REVIEWED FOR  
STATE FIRE MARSHAL  
AS PER REVIEW LETTER  
BY: WILLIAM D. JONES, ARCHITECT, CBO  
*William D. Jones*

**SHELL ONLY**

OLDE TOWN SLIDELL  
FIRE DAMAGE REHABILITATION  
227 & 285 COUSIN STREET  
SLIDELL, LA  
70456

#	DESCRIPTION	DATE

*Robert V. Wilk*

FLOOR PLAN

SHEET No: 4 OF 9

A-1

**DAMMON**  
ENGINEERING  
Architects & Engineers

CHIEF ENGINEER: DAVID DAMMON, P.E.  
DAMMON ENGINEERING, INC.  
554 OLD SPANISH TRAIL  
SLIDELL, LA 70456  
PHONE: 985-649-5932  
FAX: 985-641-5950

DATE: 07-26-2012  
JOB No: 2146  
DRAWN BY: BSN  
CHECKED BY: BSN