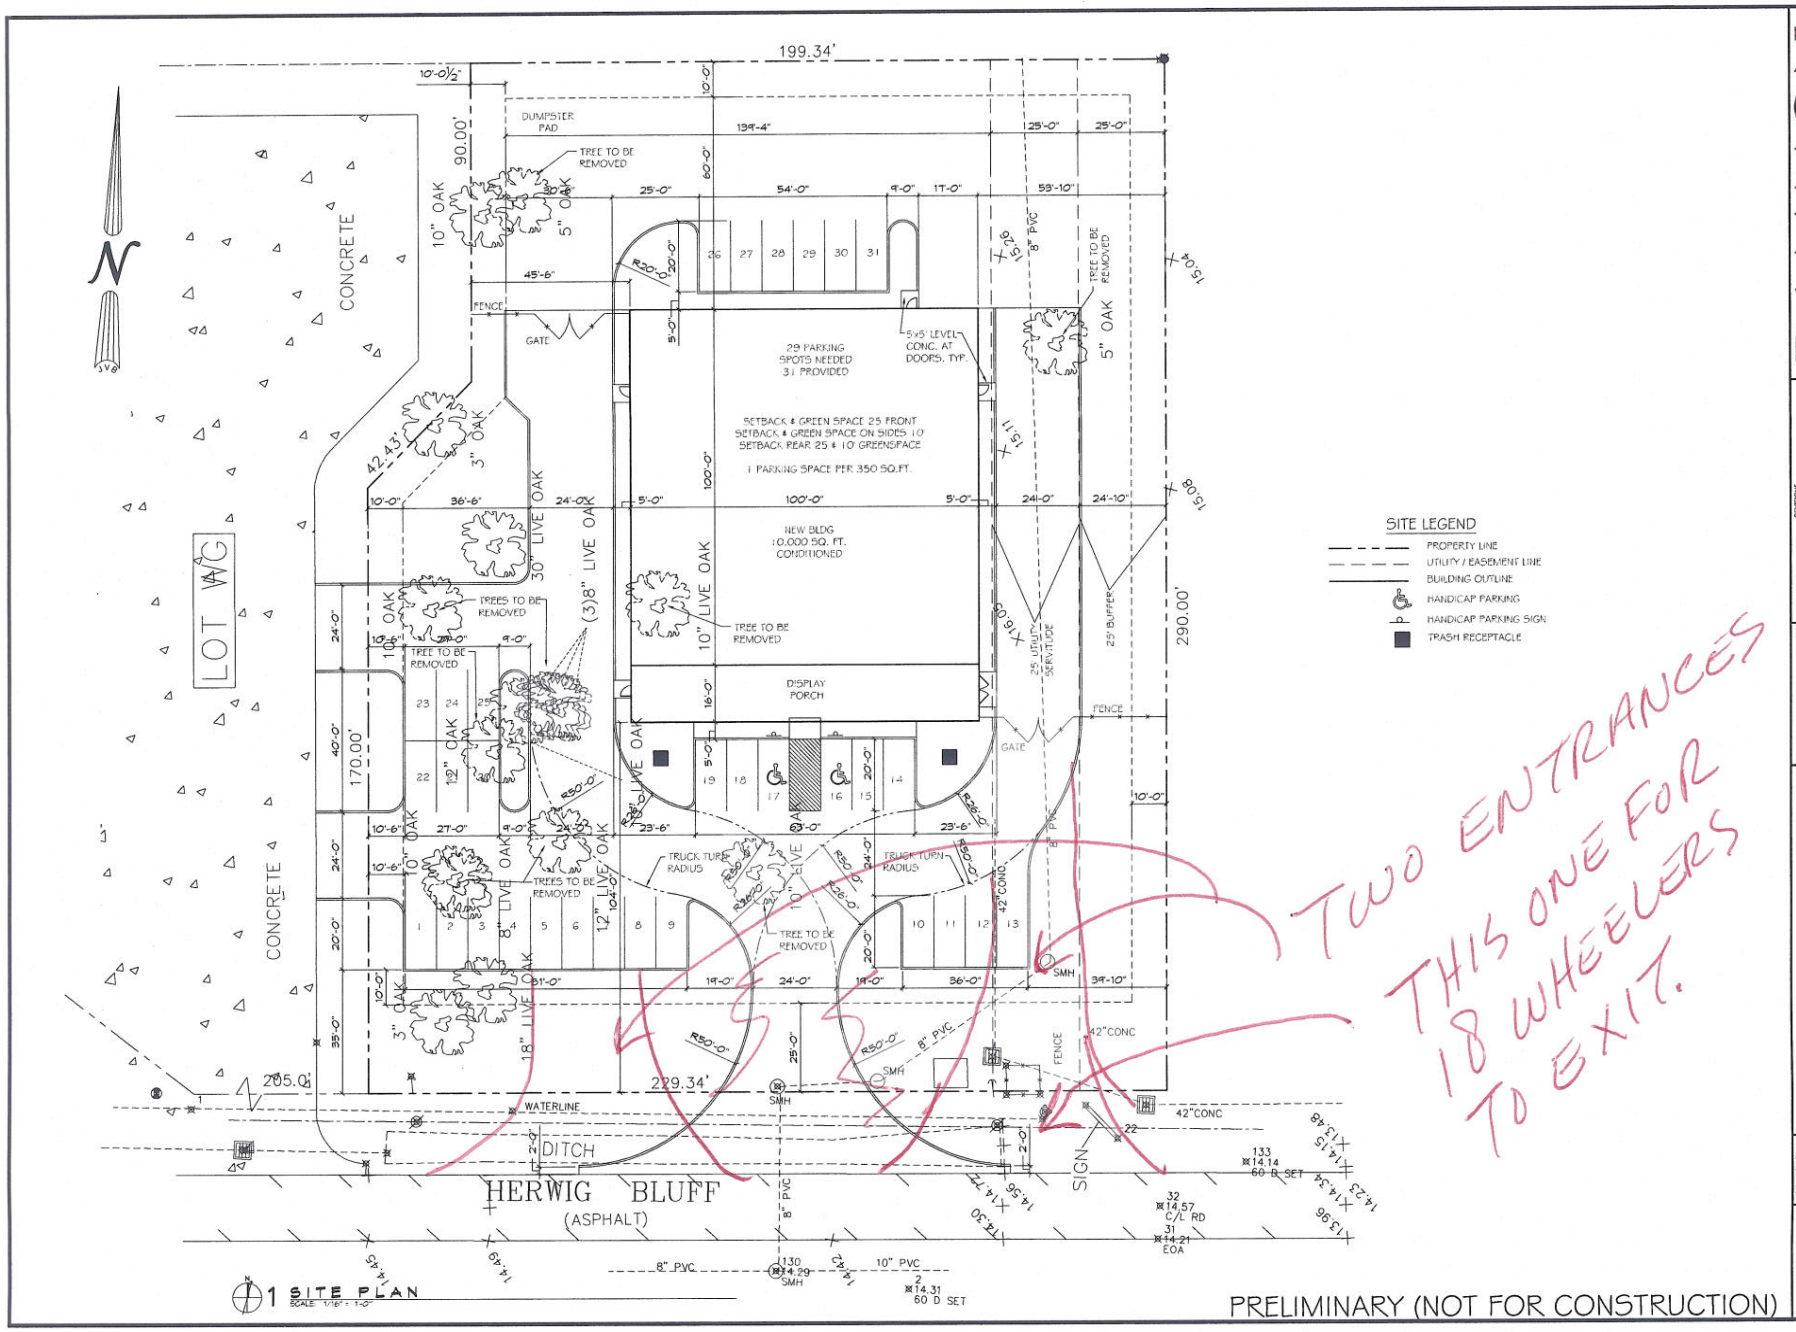

SITE LEGEND

- PROPERTY LINE
- UTILITY / EASEMENT LINE
- BUILDING OUTLINE
- HANDICAP PARKING
- HANDICAP PARKING SIGN
- TRASH RECEPTACLE

TWO ENTRANCES
THIS ONE FOR 18 WHEELERS TO EXIT.

PRELIMINARY (NOT FOR CONSTRUCTION)

DAMMON ENGINEERING, INC.
Architects & Engineers
www.dammonengineering.com
dammonengineering@bellsouth.net
P: 985.641.9900
F: 985.641.9950
Chief Architect: Kevin J. Kinchen, NCARB
Chief Engineer: Brian Hesch, PE
5500 Bluff Hill
Slidell, LA 70458

#	DESCRIPTION	DATE

REVISIONS

SEAL:

ACE Hardware
HERWIG BLUFF, SLIDELL, LOUISIANA

DRAWN BY:	DATE: 04.10.2014
	CHECKED BY:

SHEET TITLE:
SITE PLAN
SCHEME 2
WITH TREES
TO BE REMOVED

DRAWING NUMBER:
C1

SHEET No: 01 of 05