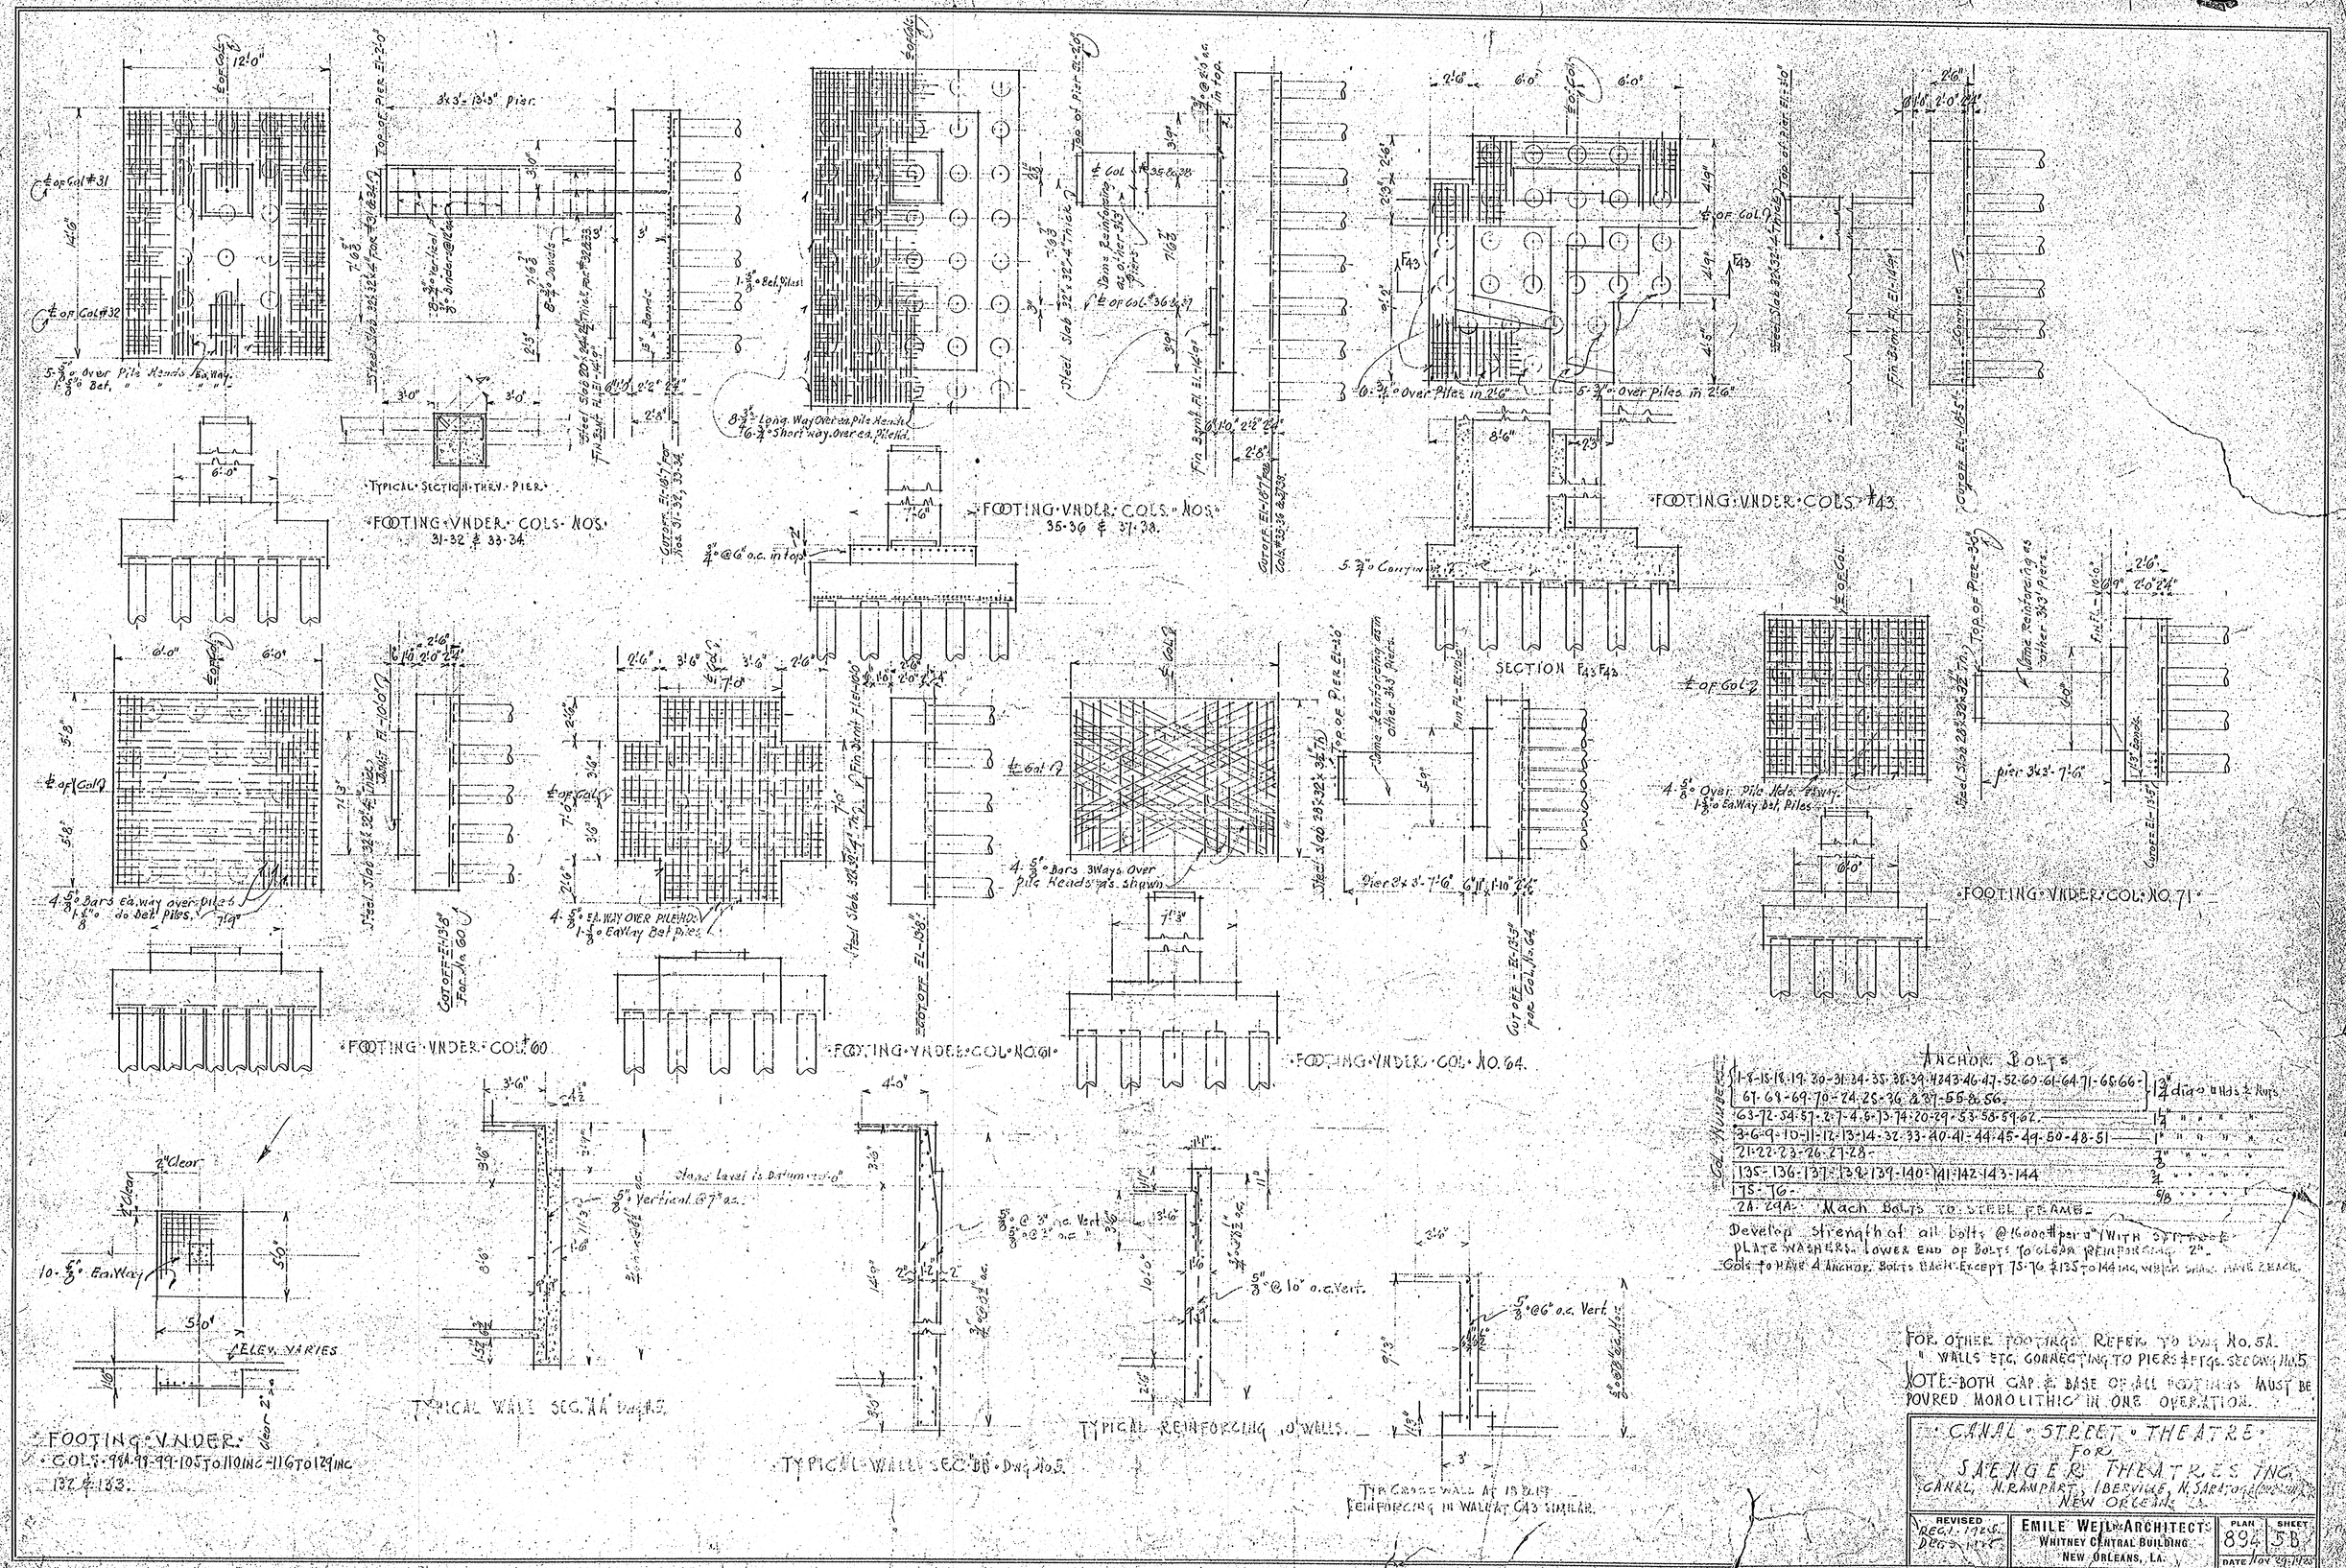
FOOTING VNDER COLS. NOS. 31-32 & 33-34
TYPICAL SECTION THRU PIER
FOOTING VNDER COLS. NOS. 35-36 & 37-38.
FOOTING VNDER COLS. #43
SECTION F43-F43
FOOTING VNDER COL. NO. 71
FOOTING VNDER COL. #60
FOOTING VNDER COL. NO. 61
FOOTING VNDER COL. NO. 64.
TYPICAL WALL SEC. AA Dwg. No. 5
TYPICAL WALL SEC. BB Dwg. No. 5
TYPICAL REINFORCING IN WALLS
TYP. CROSS WALL AT 15 & 17 REINFORCING IN WALL AT C43 SIMILAR.
FOOTING VNDER COLS. 99A-99-99-105 TO 110 INC-116 TO 129 INC 132 & 133.
ANCHOR BOLTS
Col. Number
1-8-15-18-19-20-31-34-35-38-39-42-43-46-47-52-60-61-64-71-65-66-67-68-69-70-24-25-36 & 37-55 & 56 — 1 3/4" dia. U Bolts & Rods
63-72-54-57-2-7-4-6-13-74-20-29-53-58-59-62 — 1 1/2"
3-6-9-10-11-12-13-14-32-33-40-41-44-45-49-50-48-51 — 1"
21-22-23-26-27-28 — 3/8"
135-136-137-138-139-140-141-142-143-144 — 3/4"
175-76 — 5/8"
24-29A — Mach Bolts to Steel Frame
Develop strength of all bolts @ 16000# per □" (WITH 3/8" THICK PLATE WASHERS. LOWER END OF BOLTS TO OLSON REINFORCING 2".
COLS. TO HAVE 4 ANCHOR BOLTS EACH EXCEPT 75-76 & 135 TO 144 INC. WHICH SHALL HAVE 2 EACH.
FOR OTHER FOOTINGS REFER TO DWG. NO. 5A.
" WALLS ETC. CONNECTING TO PIERS & FTGS. SEE DWG. NO. 5
NOTE-BOTH CAP & BASE OF ALL FOOTINGS MUST BE POURED MONOLITHIC IN ONE OPERATION.
CANAL STREET THEATRE
FOR
SAENGER THEATRES INC.
CANAL, N. RAMPART, IBERVILLE, N. SARATOGA
NEW ORLEANS
REVISED
EMILE WEIL ARCHITECT
WHITNEY CENTRAL BUILDING
NEW ORLEANS, LA.
PLAN 894
SHEET 5B
DATE NOV 29 1926