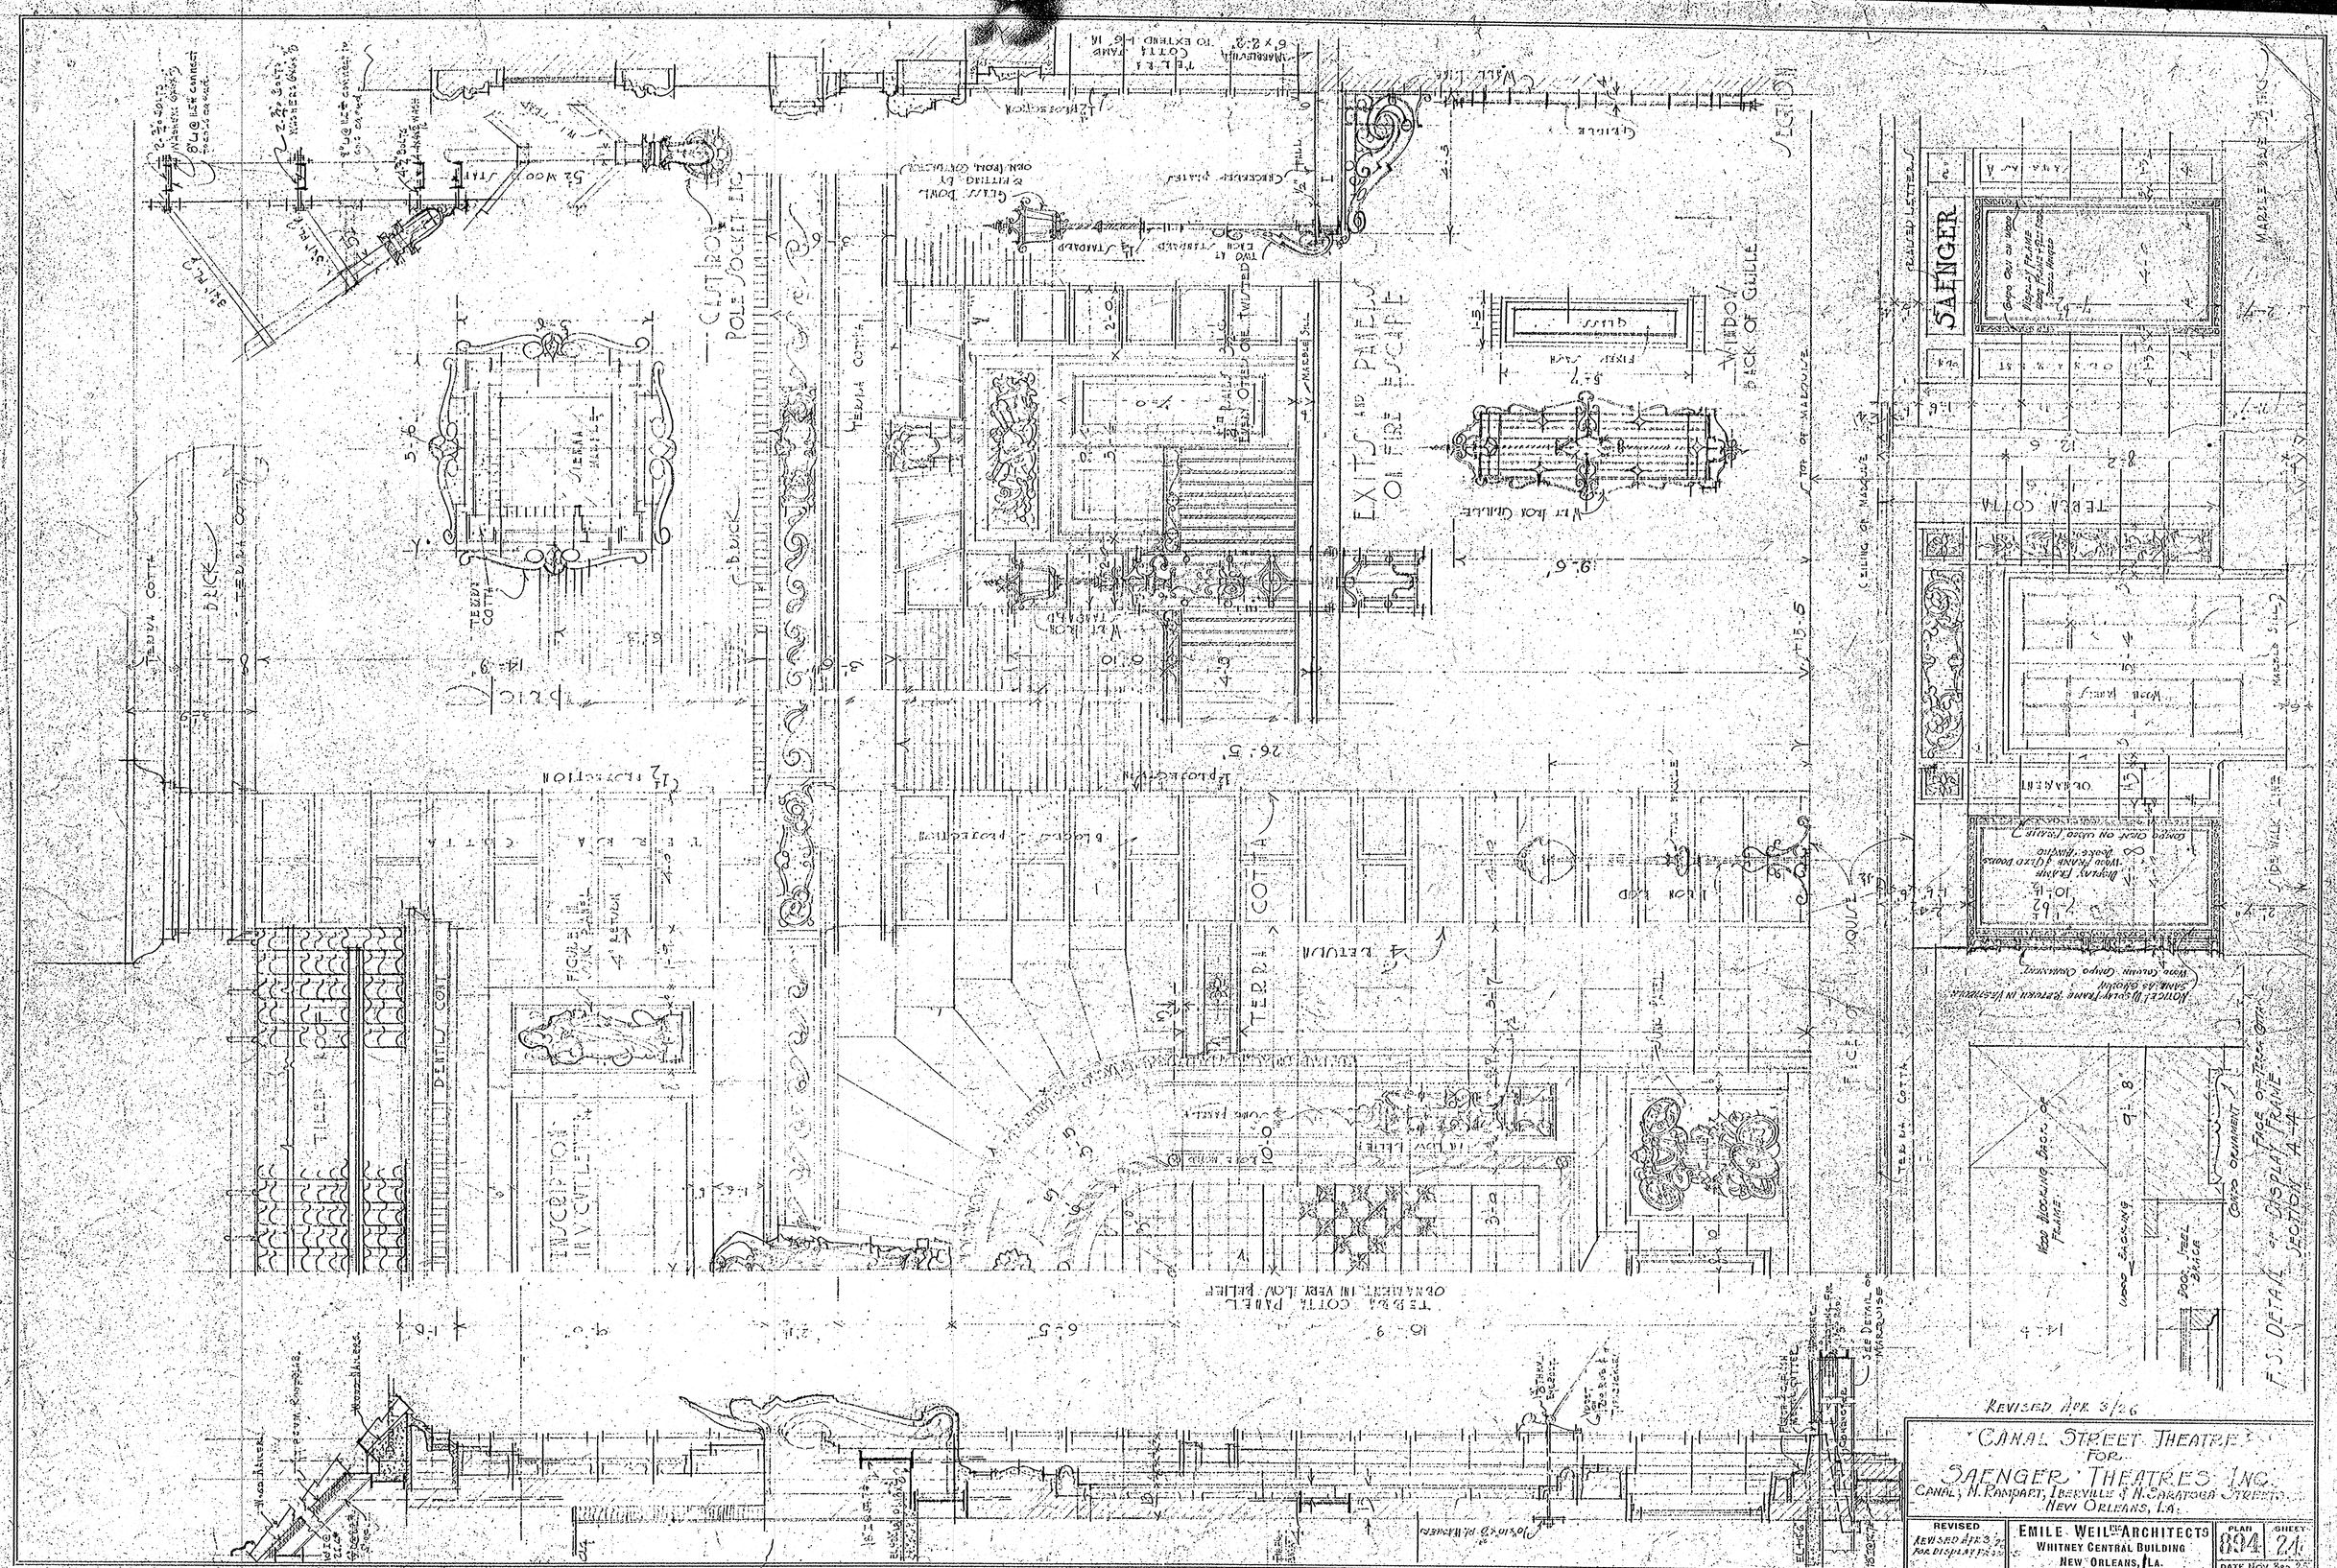
SAENGER
TERRA COTTA
EXITS AND PANELS OF FIRE ESCAPE
CLIMBOX POLE SOCKET ETC
TERRA COTTA PANEL ORNAMENT IN VERY LOW RELIEF
F.S. DETAIL OF DISPLAY FRAME SECTION A-A
REVISED APR 3/26
CANAL STREET THEATRE
FOR
SAENGER THEATRES INC.
CANAL, N. RAMPART, IBERVILLE & N. SARATOGA STREETS
NEW ORLEANS, LA.
REVISED
REVISED APR 3/26 FOR DISPLAY FRS
EMILE WEIL ARCHITECTS
WHITNEY CENTRAL BUILDING
NEW ORLEANS, LA.
PLAN 894
SHEET 24
DATE NOV. 2ND 25